November 14, 2014

BOARD OF COUNTY COMMISSIONERS ORANGE COUNTY, FLORIDA ADDENDUM NO. 2 / IFB Y15-721-EZ

Bid Opening Date: November 25, 2014

ORANGE COUNTY CLARCONA HORSEMEN'S PARK KITCHEN AND REC BUILDING HVAC REPLACEMENT

This Addendum is hereby incorporated into the bid documents of the project referenced above. The following items are clarifications, corrections, additions, deletions and/or revisions to and shall take precedence over the original documents. Additions are indicated by <u>underlining</u>, deletions are indicated by <u>strikethrough</u>.

A. The following additions, deletions, and clarifications are provided herewith and incorporated into this IFB:

- **1.** The following drawings, have been revised, with changes noted:
 - a. DRAWING SHEET NO. AD100 PHOTOS OF EXISTING CONDITIONS
 - (1) Revise photos and hex notes to remove restroom scope from the project.
 - b. DRAWING SHEET NO. AD101 FLOOR PLAN DEMOLITION -ARCHITECTURAL
 - (1) Revise Hex Notes 1, 4, and 5.
 - c. DRAWING SHEET NO. AD102 REFLECTED CEILING PLAN DEMOLITION ARCHITECTURAL
 - (1) Revise Hex Notes 1, 4, and 5.
 - (2) Revise notes for demolition of existing ceiling devices.
 - d. DRAWING SHEET NO. AD201 EXTERIOR ELEVATIONS DEMOLITION
 (1) Revise Hex Notes 1, 4, and 5.
 - e. DRAWING SHEET NO. A101 FLOOR PLAN RENOVATION -ARCHITECTURAL
 - (1) Revise Hex Notes 1, 4, and 5.
 - f. DRAWING SHEET NO. A102 REFLECTED CEILING PLAN RENOVATION ARCHITECTURAL
 - (1) Revise Hex Notes 1, 4, and 5.
 - (2) Revise notes for demolition of existing ceiling devices.
 - g. DRAWING SHEET NO. A103 ROOF PLAN RENOVATION -ARCHITECTURAL
 - (1) Revise Hex Notes 1, 4, and 5.
 - (2) Revise notes for demolition of existing ceiling devices.

- h. DRAWING SHEET NO. A201 EXTERIOR ELEVATIONS (1) Revise Hex Notes 1, 4, and 5.
- i. DRAWING SHEET NO. A401 SECTION AND INTERIOR ELEVATION
 - (1) Revise Hex Notes 1, 4, and 5.
 - (2) Revise notes.
- j. DRAWING SHEET NO. A402 DETAILS
 - (1) Revise Details 1, 6, and 7.
 - (2) Added comment "Provide top rail at all fencing (Typical)" to details 4/A402 and 7/A402.
 - (3) Added comment "Provide bottom rail at all fencing (Typical)" to details 4/A402 and 7/A402.
- k. DRAWING SHEET NO MD101 FLOOR PLAN DEMOLITION MECHANICAL
 - (1) Revise exhaust fan notes in restrooms
 - (2) Revise Hex Note #9.
- I. DRAWING SHEET NO M101 FLOOR PLAN RENOVATION MECHANICAL
 - (1) Revise exhaust fan notes in restrooms.
 - (2) Remove restroom ductwork.
 - (3) Add General Note #21.
- m. DRAWING SHEET NO M601 SCHEDULES- MECHANICAL
 - (1) Revise schedules as shown in attached sheet.
- n. DRAWING SHEET NO. ED101 FLOOR PLAN DEMOLITION POWER
 - (1) Revise two exhaust fans serving restroom to show "existing to remain."
- o. DRAWING SHEET NO. E101 FLOOR PLAN RENOVATION POWER/SYSTEMS
 - (1) Delete new electrical connections for two exhaust fans serving restrooms.
 - (2) Delete Hex Note #5.
- p. DRAWING SHEET NO. E501 ELECTRICAL SCHEDULES ELECTRICAL
 - (1) Revise mechanical feeder schedule for GPU-1 and EF-3
 - (2) Revise load and CB for GPU-1 on panel 3535C (existing revised).
 - (3) Revise load and CB for EF-3 on panel 3535C (existing revised).
- q. The similar project description is changed to read as follows:
- 2. Furnish and install all Mechanical, Electrical and Incidental work associated with the installation of an HVAC system in a commercial kitchen with a minimum area of 700 square feet OR Furnish and install all Mechanical, Electrical and Incidental work associated with the installation of an HVAC system in a commercial dining establishment or commercial restaurant with a minimum area of 1500 square feet.

- **3. The following information is provided as clarification:** Project has been submitted for permitting. The contractor shall include the cost of **all** permit fees in the bid. Contractor shall contact Orange County Building Department for permit fees as well as Orange County Utilities for separate utilities permit fees. Permit number for this project is B14903293.
- B. All other terms, conditions and specifications remain the same.
- C. 1. The Proposer shall acknowledge receipt of this addendum by completing the applicable section in the solicitation or by completion of the acknowledgement information on the addendum. Either form of acknowledgement must be completed and returned not later than the date and time for receipt of proposals.
 - 2. Receipt acknowledged by:


_____Authorized Signature _____Date Signed

_____ Title

_____ Name of Firm




	<image/> <image/> <image/> <text><text><text><text><text><text><text><text></text></text></text></text></text></text></text></text>
 HEX.NOTES PENSTING FLOOR VENTS ARE TO REMAIN AT NON-AR CONDITIONED SPACE. THOROUGHY CLEMI LOUVERS AND REMOVE LANDSCHING MULCH A MIN. OF 12' FROM THE LOUVERS AND REMOVE LANDSCHING MULCH A MIN. OF 12' FROM THE LOUVERS. PROTECT FROM DAMAGE. REMOVE EXISTING TRANSOM GLASS PAILES IN PREPARATION FOR MEGANICE EXHILST PROVIDE NEW WOOD TRIM AND CEMENT BOARD PAREL AS SHOWN IN DETAIL ON 3/A-402. REMOVE EXISTING MECHANICAL, ROOF EXHAUST. CAP OURS WITH GALV. SHEET MELL COVER. PROVIDE GASKIED ATTACIMENTS TO EXISTING DURING MIN. TOTOLET FROM DAMAGE. RETAIN KEITING DON LOUVERS. CLEAR EXISTING DOOR LOUVERS AT TOLETS AND PROTECT FROM DAMAGE. RETAIN CRIMP COUPMENT IS TO BE SALVAGED AND STORED IN A SECOND EXISTING GRIP/PLASTER COLLINGE. STORE DATA DECOMMEND AREA FOR THE OWNER. SEE MECHANICAL PLANS FOR SECOND EXISTING GRIP/PLASTER COLLING FLAN RETAIN CRIMPAN HIL PREVIDE OSTELLING PLAN RETAING COUPMENT REMOVE EXISTING GRIP/PLASTER COLLING FLAN USISTING TRANSOM GLASS AND STOPS IN ITS ENTRETY. RETAIN DURING AND INSTALL NEW CEMENT BOARD INTEL PLANEL FER DETAIL. PART TO ARCH TRM. SEE MECH DAMAND SFOR TSTALL NEW ACT CELLING AS SHOWN IN REFLECTED CELLING PLAN REMOVE EXISTING TRANSOM GLASS AND STOPS IN ITS ENTRETY. TURINGH AND DUCTWORK. REMOVE EXISTING TRANSOM GLASS AND STOPS IN ITS ENTRETY. TURINGH AND DUCTWORK. 	Revisions No. Date Description 1 11/10/14 Revision No. 1 1 11/10/14 Revision No. 1 1 1 1 1 <

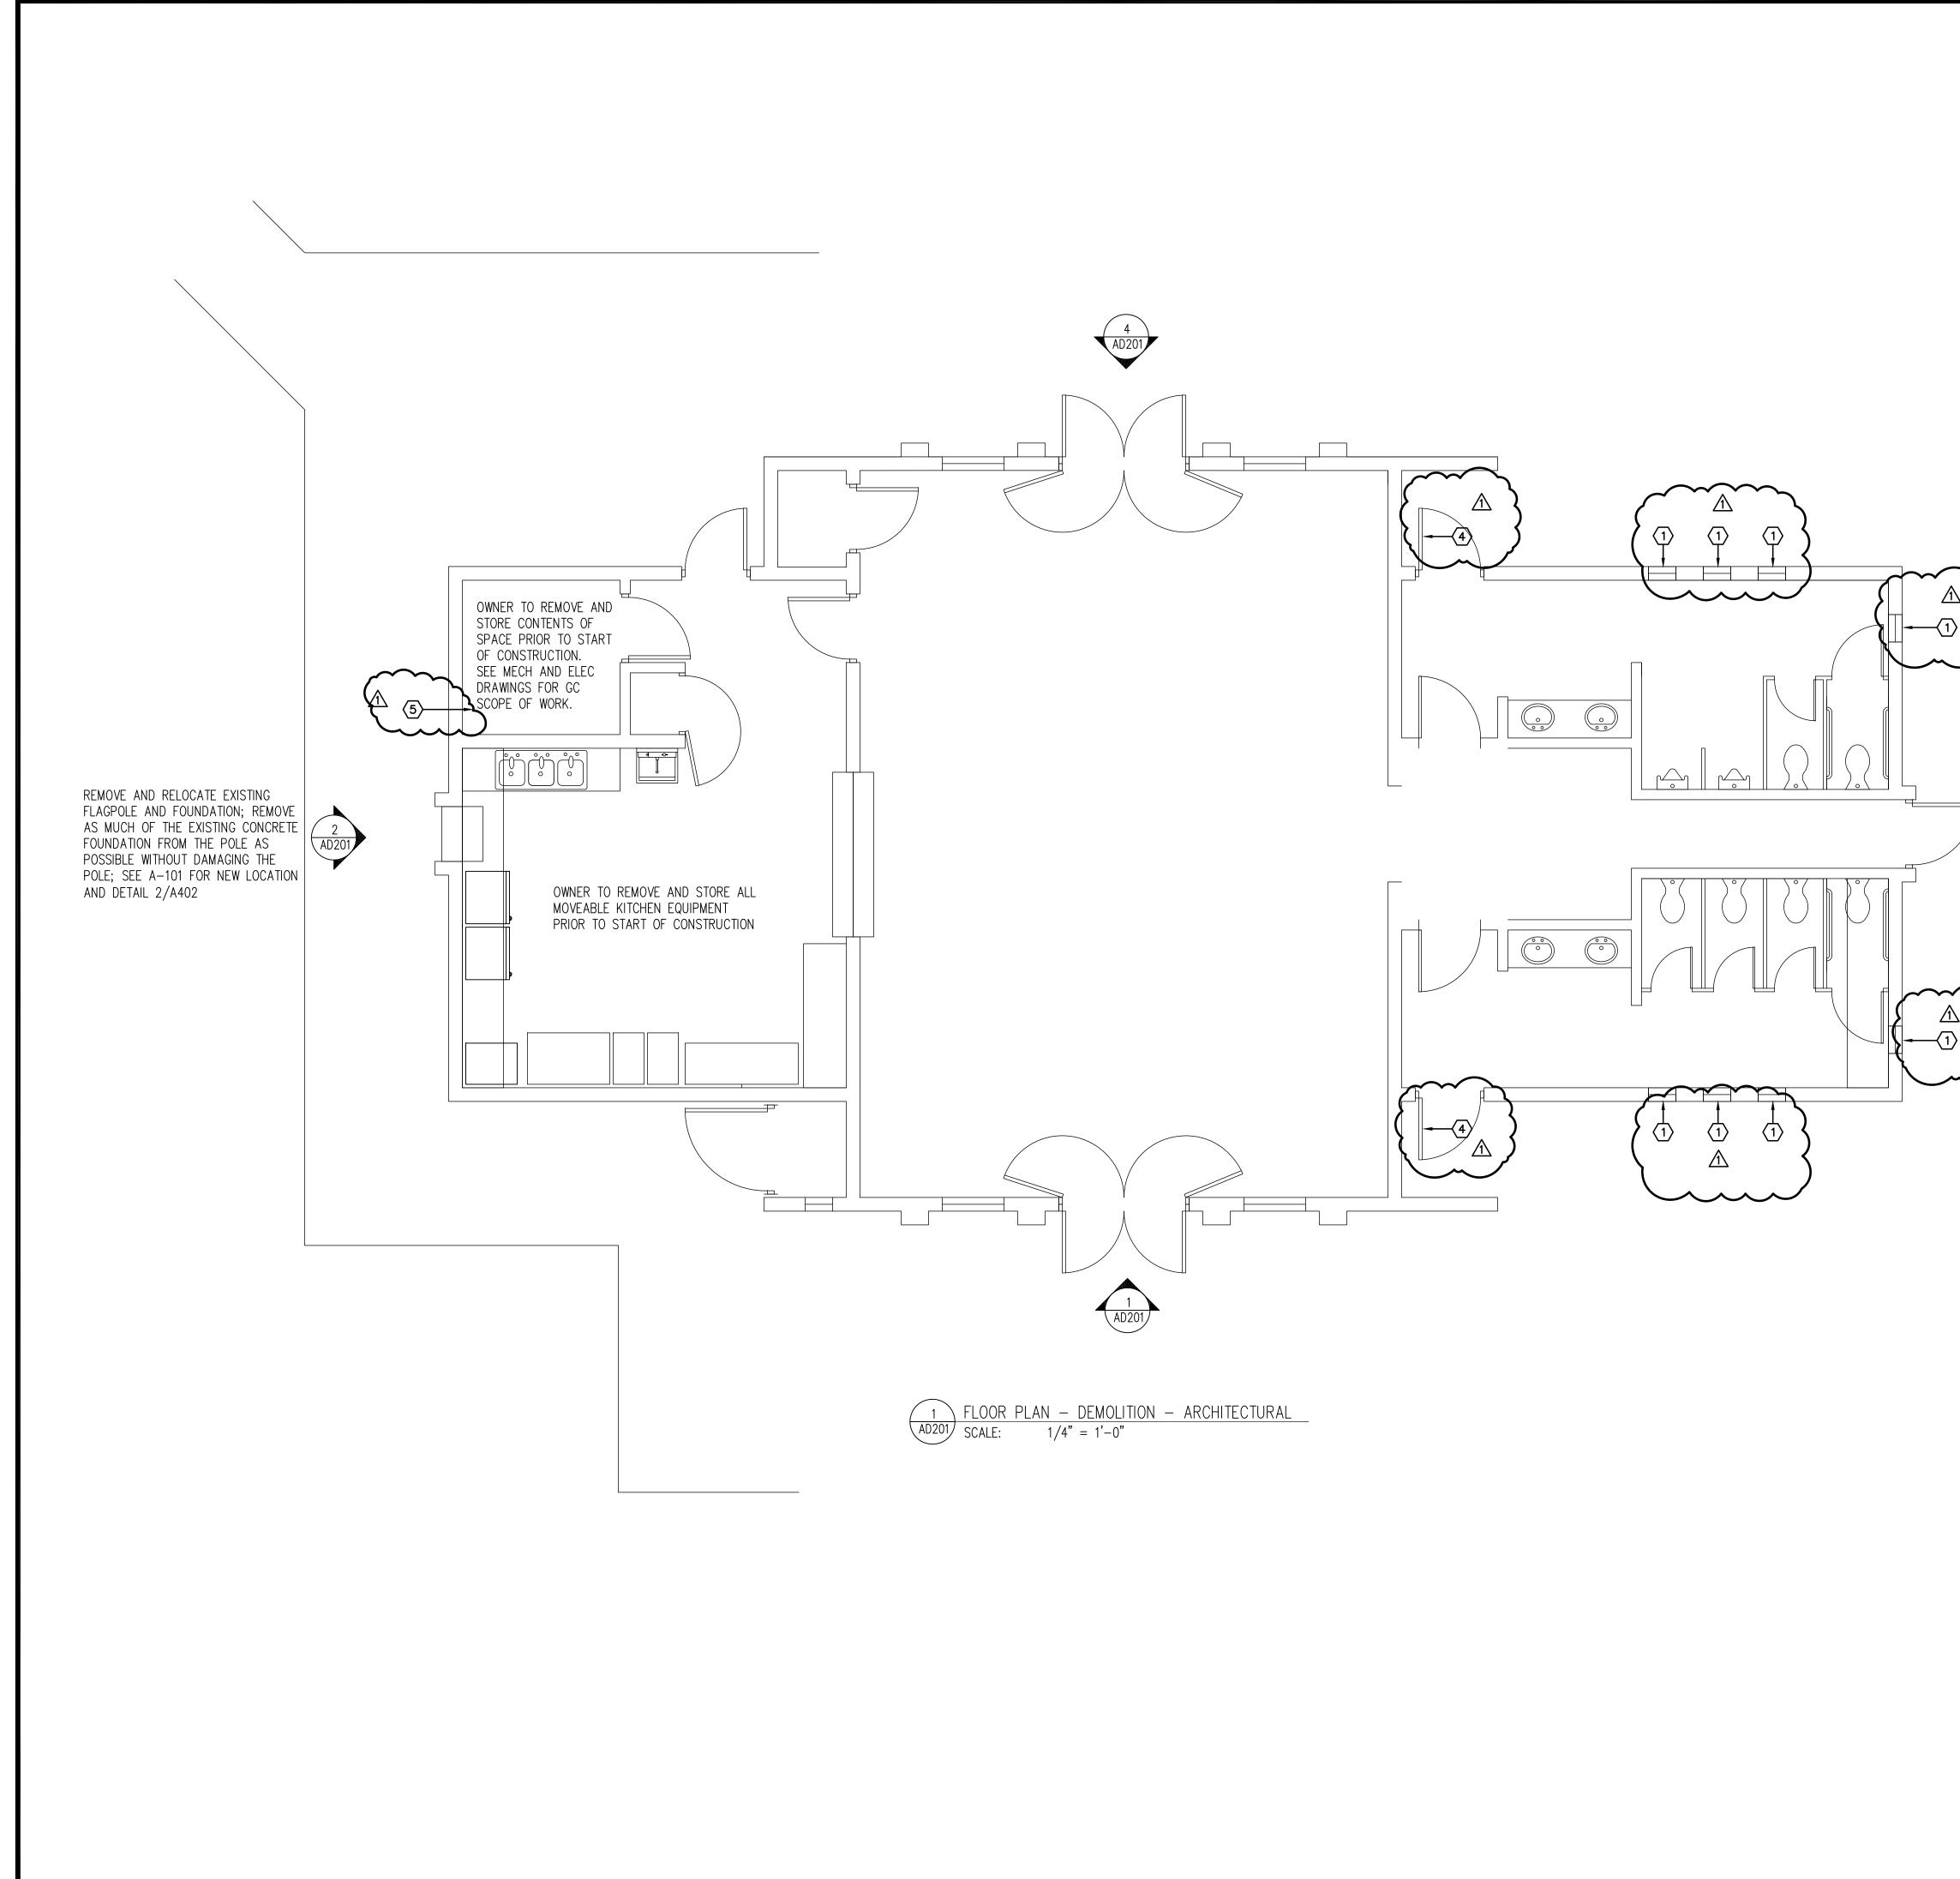


	<image/> <image/> <image/> <text><text><text><text><text><text><text><text></text></text></text></text></text></text></text></text>
 HEX.NOTES EXISTING FLOOR VENTS ARE TO REMAIN AT NON-AR CONDITIONED SPACES THOROUGHLY CLEAN LOWRERS AND REMAYE LANDCAPING MULCH A MIN. OF 12° FRON THE LOWRERS. PROTECT FROM DAMAGE. REMAYE EXISTING TRANSOM GLASS PANELS IN PREPARATION FOR MICHAACL EXITALST. FROM THE LOWRERS. PROTECT FROM DAMAGE. REMAYE EXISTING TRANSOM GLASS PANELS IN PREPARATION FOR MICHAACL EXITALST. PROVIDE NEW YOUND THM AND CENTINT BOARD PANEL AS SHOWN IN DETAIL ON 3/A-402. REMAYE DESTING MECHANICAL ROOF EVALUATION FOR MICHAAL EXISTING TOOR LOWRER AND REMARK. ALL EXISTING FLOOR LOWRER AND REMARK. ALL EXISTING PROOF LOWRERS. CLEAN EXISTING DOOR LOWRERS AT TOLETS AND PROTECT FROM DAMAGE. ALL EXISTING HARC EQUIPHENT IS TO BE SAUWAED AND STORED IN A SPECIFIC EQUIPMENT. BERSING THEOR THE OWNERS. SEE MECHANICAL PLANS FOR SPECIFIC EQUIPMENT. BERSING THEORY THE CHEMIC IN ITS ENTRETY. RETAIN SUSPENDED ACCOUSTICAL CELLING SYSTEM. FURNISH AND INSTALL NEW ACT CELLING AS SHOWN IN REFLECTED CELLING PLAN REMOVE EXISTING RANG/PLASTER CELLING IN ITS ENTRETY. PURINSH AND INSTALL NEW CENCH EQARD MAINS FOR THE NEW SUSPENDED ACCOUSTICAL CELLING SYSTEM. FURNISH AND INSTALL NEW ACT CELLING AS SHOWN IN REFLECTED CELLING PLAN REMOVE EXISTING RANGY MICHAGE AND STORED IN A DECIFIC EQUIPMENT. REMOVE EXISTING RANGY MICHAGE AND STORED IN A DECIFIC EQUIPMENT AND DUCTWORK. 	Revisions No. Date Description 1 11/10/14 Revision No. 1 1 11 11/10/14 1 11/10/14 RB Issue Date: 11/10/14 Drawing Scale: 1/4"=1'-0" Drawing Title: FLOOR PLAN DEMOLITION ARCHITECTURAL 100 % CONSTRUCTION DOCUMENTS Drawing No. A D 1



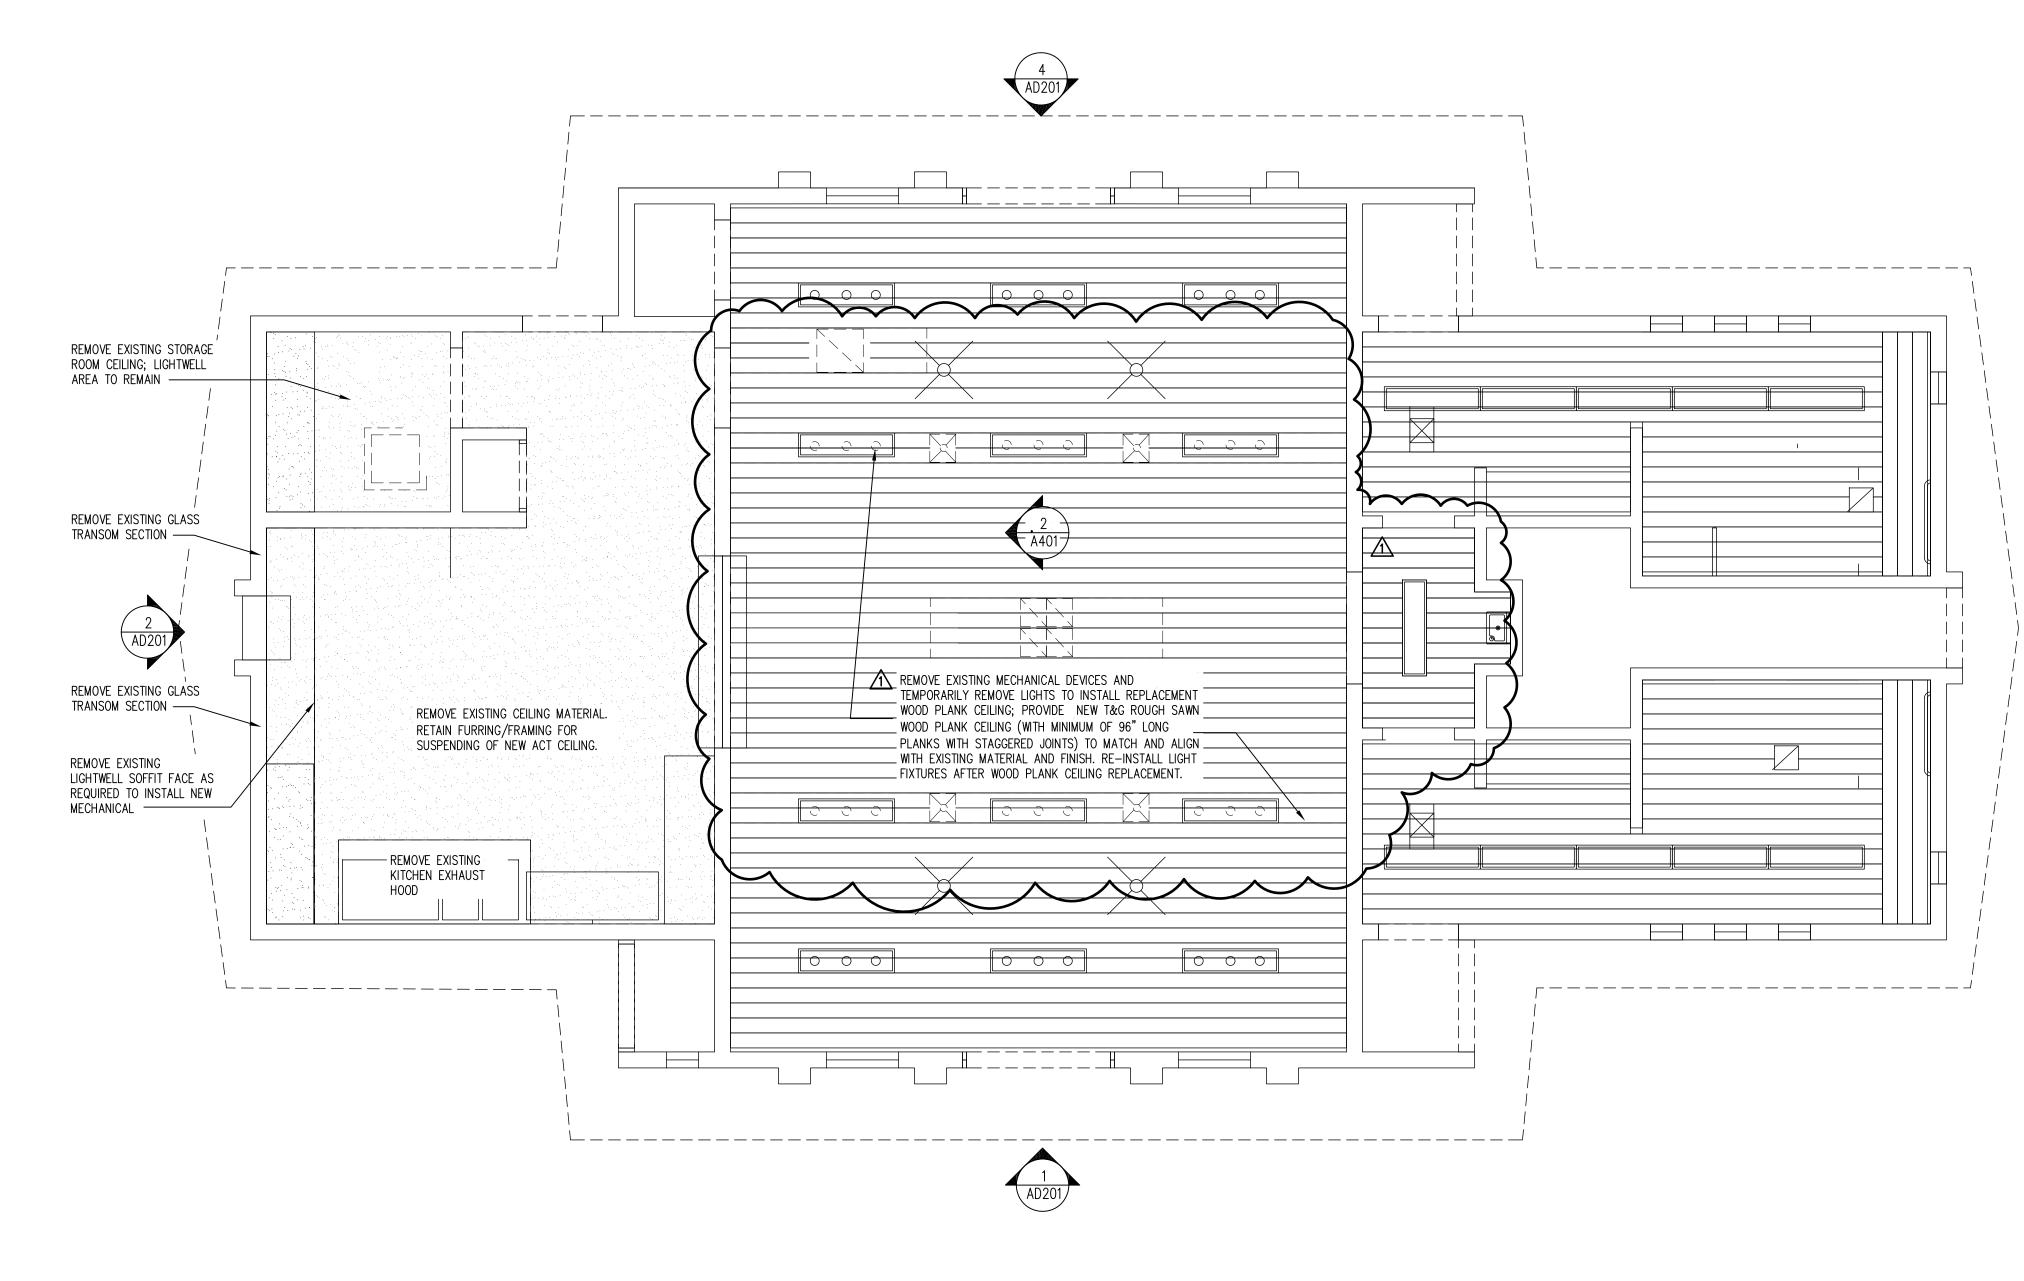


 $\begin{array}{c|cccc} 1 & REFLECTED & CEILING & PLAN - DEMOLITION - ARCHITECTURAL \\ \hline AD102 & SCALE: & 1/4" = 1'-0" \end{array}$

M. HEL NOTE: M. HEL NOTE: M. DISTING FLOOR VARIES ARE TO FRAME WITHOW ARE CONSTRUME WICHING LOWARD. MONOTING WITHOW ARE CONSTRUME WICHING LOWARD. PROVIDE NOT WITH AND CENTER BRADE PROVIDE RESTING THE OWNER. CAN BE AND CONSTRUCT CONSTRUMENT AND INCOME WITH AND CENTER BRADE PROVIDE RESTING THE OWNER. CAN BE AND CONSTRUME TO AND AND AND AND CENTER DEAR AND STORED IN A DESIGNMENT AND CENTER DEAR AND STORED IN A DESIGNMENT AND CENTER DEAR AND STORED IN A DESIGNMENT AND DEAR ASS AND STORES IN THE INTER- STRUME RESTING AND			<image/> <image/> <section-header><section-header><text><text><text><text><text><text></text></text></text></text></text></text></section-header></section-header>
Construction functions Service Function for the owner and construction for methods of the function of	<u>3</u> D201		No. Date Description
Construction functions Service Function for the owner and construction for methods of the function of			
EQUIPMENT AND DUCTWORK. EQUIPMENT AND DUCTWORK. Drawn By: GG Checked By: RB Issue Date: 11/10/14 Drawing Scale: 1/4"=1'-0" Drawing Title: REFLECTED CEILING PLAN DEMOLITION ARCHITECTURAL 100% CONSTRUCTION DOCUMENTS Drawing No.		 1 EXISTING FLOOR VENTS ARE TO REMAIN AT NON-AIR CONDITIONED SPACES. THOROUGHLY CLEAN LOUVERS AND REMOVE LANDSCAPING MULCH A MIN. OF 12" FROM THE LOUVERS. PROTECT FROM DAMAGE. 2 REMOVE EXISTING TRANSOM GLASS PANELS IN PREPARATION FOR MECHANICAL EXHAUST. PROVIDE NEW WOOD TRIM AND CEMENT BOARD PANEL AS SHOWN IN DETAIL ON 3/A-402. 3 REMOVE EXISTING MECHANICAL ROOF EXHAUST. CAP CURB WITH GALV. SHEET METAL COVER. PROVIDE GASKETED ATTACHMENTS TO EXISTING CURB. PAINT TO MATCH SHINGLE ROOF COLOR 4 RETAIN EXISTING DOOR LOUVERS. CLEAN EXISTING DOOR LOUVERS AT TOILETS AND PROTECT FROM DAMAGE. 5 ALL EXISTING HVAC EQUIPMENT IS TO BE SALVAGED AND STORED IN A DESIGNATED AREA FOR THE OWNER. SEE MECHANICAL PLANS FOR SPECIFIC EQUIPMENT. 6 REMOVE EXISTING GWB/PLASTER CEILING IN ITS ENTIRETY. RETAIN EXISTING FURRING IF IT HELPS PROVIDE SUPPORT FOR THE NEW SUSPENDED ACOUSTICAL CEILING SYSTEM. FURNISH AND INSTALL NEW ACT CEILING AS SHOWN IN REFLECTED CEILING PLAN 7 REMOVE EXISTING TRANSOM GLASS AND STOPS IN ITS ENTIRETY. FURNISH AND INSTALL NEW CEMENT BOARD INFILL PANEL PER DETAIL. 	
Issue Date: 11/10/14 Drawing Scale: 1/4"=1'-0" Drawing Title: REFLECTED CEILING PLAN DEMOLITION ARCHITECTURAL 100% CONSTRUCTION DOCUMENTS Drawing No.			.
Drawing Title: REFLECTED CEILING PLAN DEMOLITION ARCHITECTURAL 100% CONSTRUCTION DOCUMENTS Drawing No.			Issue Date: 11/10/14
			Drawing Title: REFLECTED CEILING PLAN DEMOLITION ARCHITECTURAL

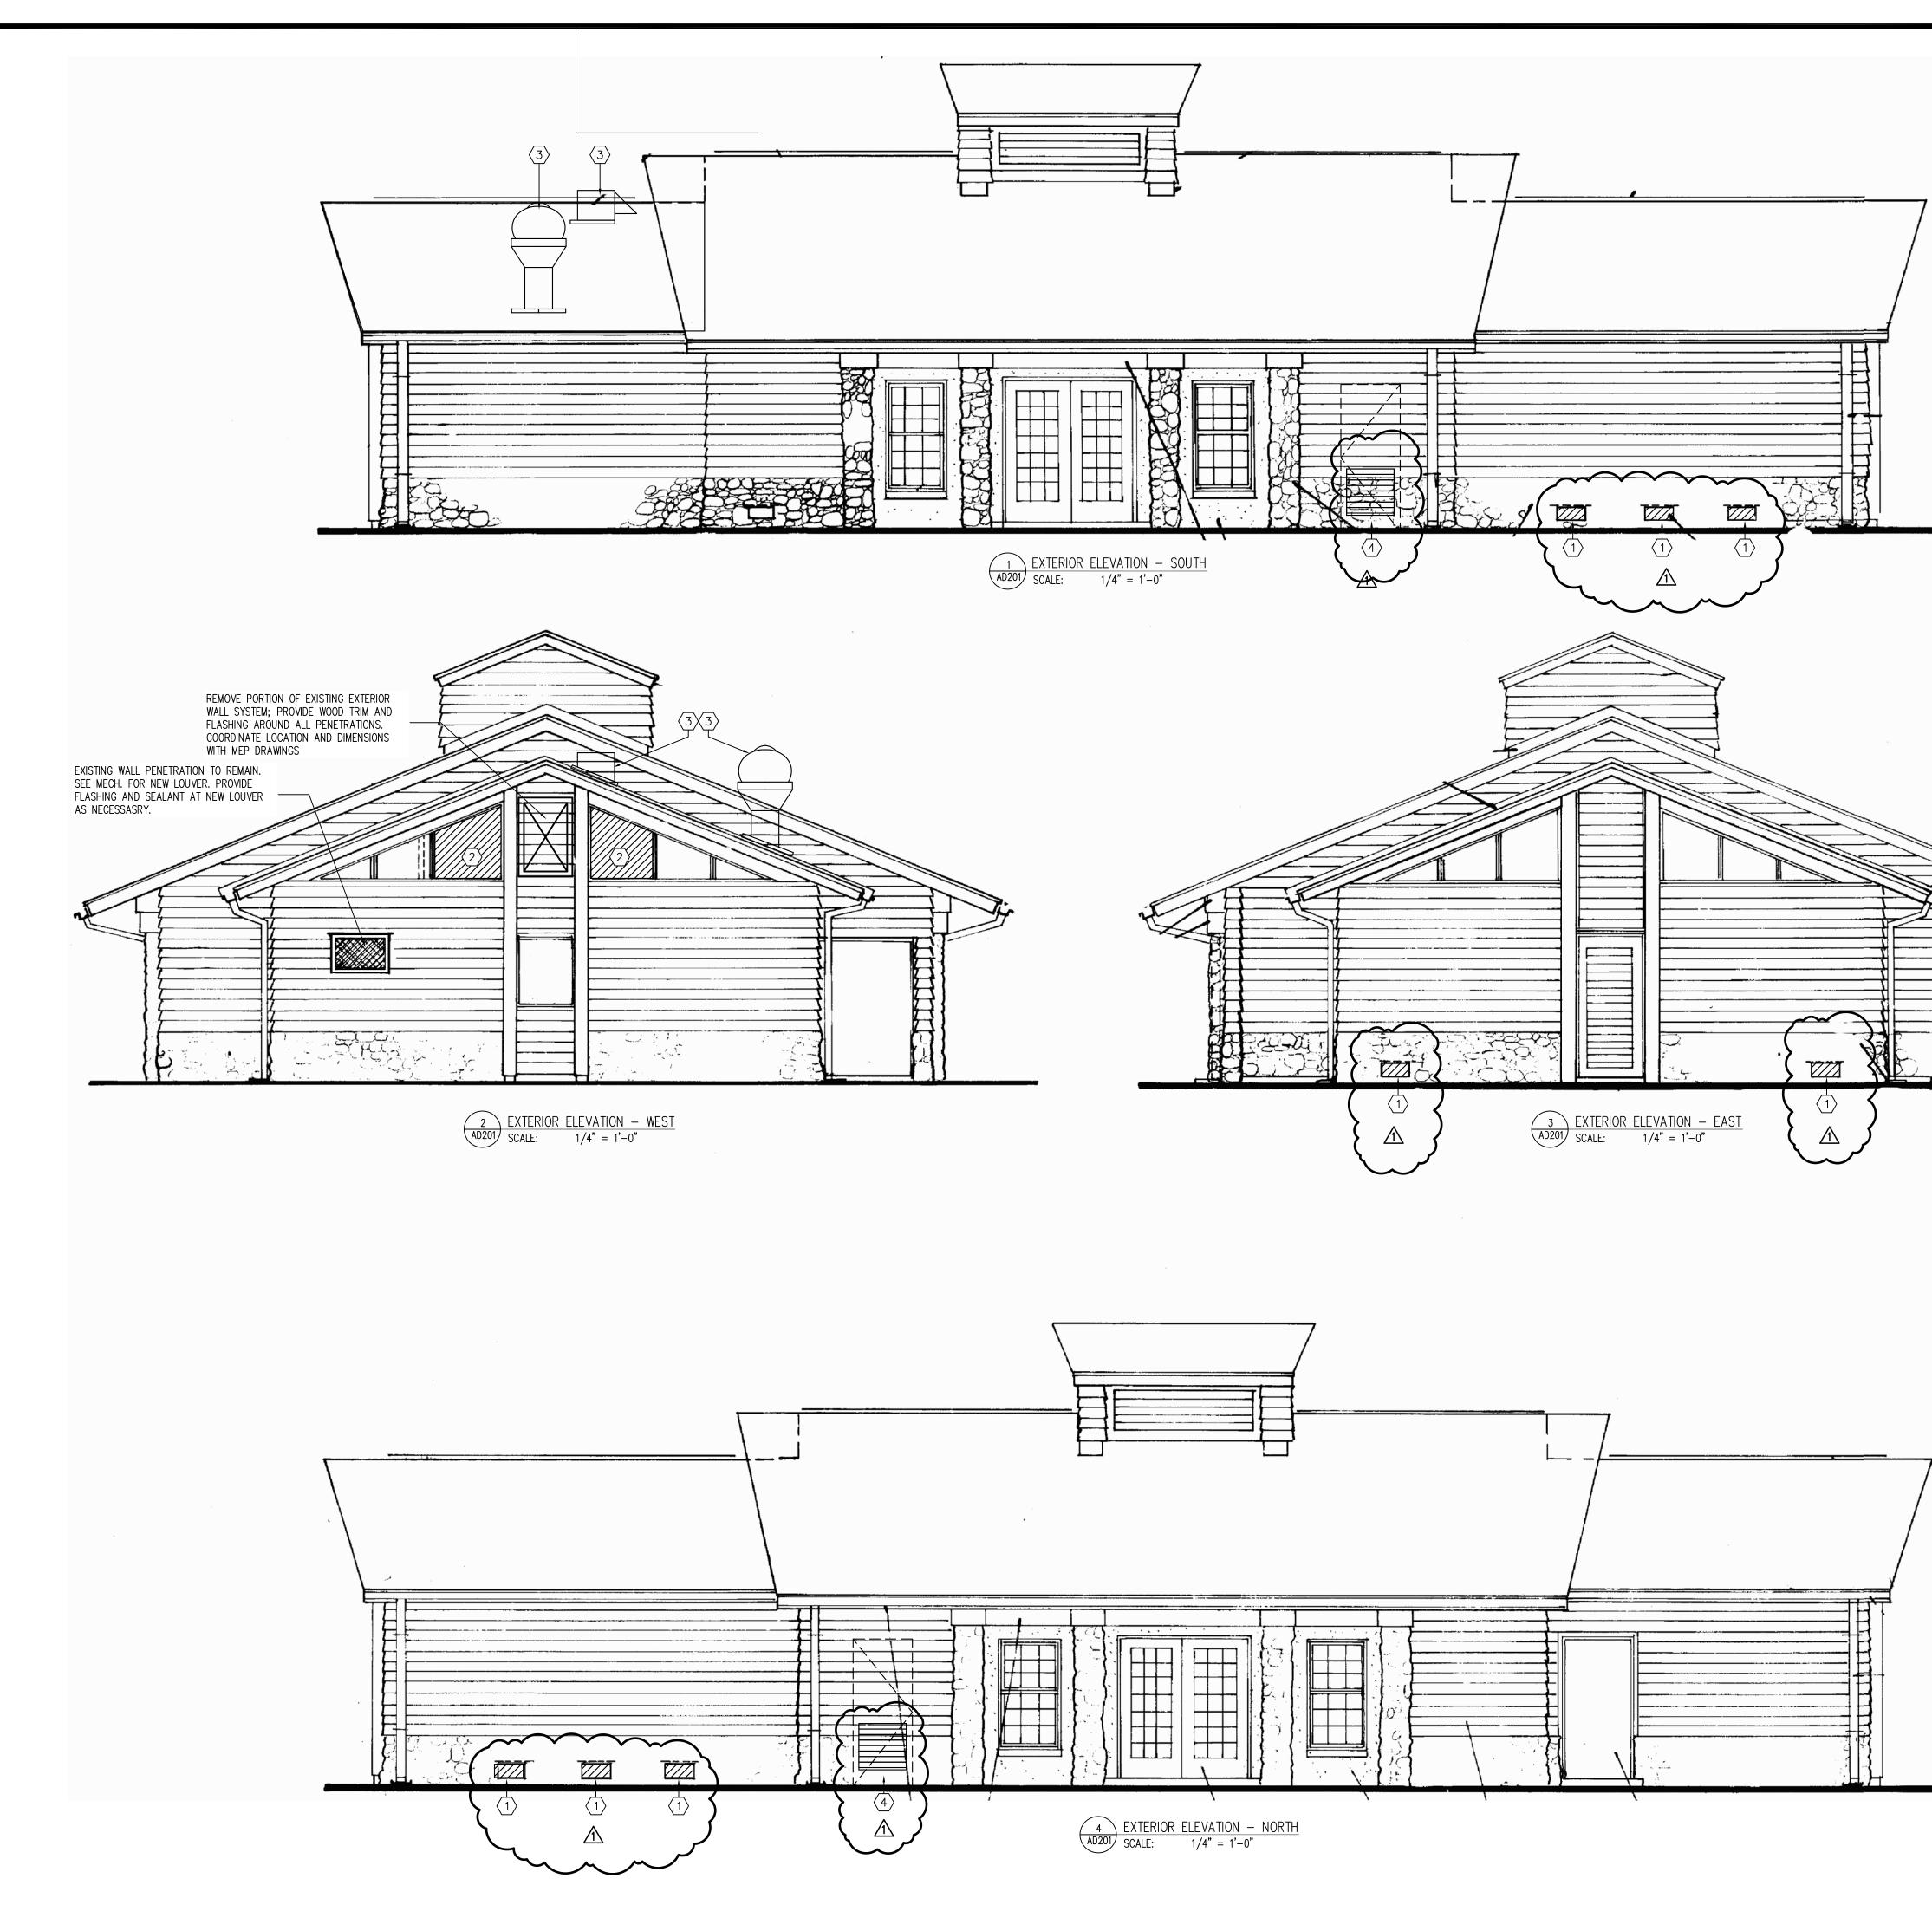


 JELMOIS JELMOIS JELMOIS CONTRACTOR SHE TO REAMA AL NON-ARE CONTINUESD INFORMATION OF A SHE TO REAMA ALL NON-ARE ALL NON-ARE INFORMATION OF A SHE TO REAMA ALL NON-ARE ALL NON-ARE INFORMATION OF A SHE TO REAMA ALL NON-ARE ALL NON-ARE ALL NON-ARE INFORMATION OF A SHE TO REAMA ALL NON-ARE ALL NON-ARE ALL NON-ARE INFORMATION OF A SHE TO REAMA ALL NON-ARE ALL NON-ARE ALL NON-ARE INFORMATION OF A SHE TO REAMA ALL NON-ARE ALL NON-ARE ALL NON-ARE INFORMATION OF A SHE TO REAMA ALL NON-ARE ALL NON-ARE ALL NON-ARE INFORMATION OF A SHE TO REAMA ALL NON-ARE ALL NON-ARE ALL NON-ARE INFORMATION OF A SHE TO REAMA ALL NON-ARE ALL NON-	<form></form>

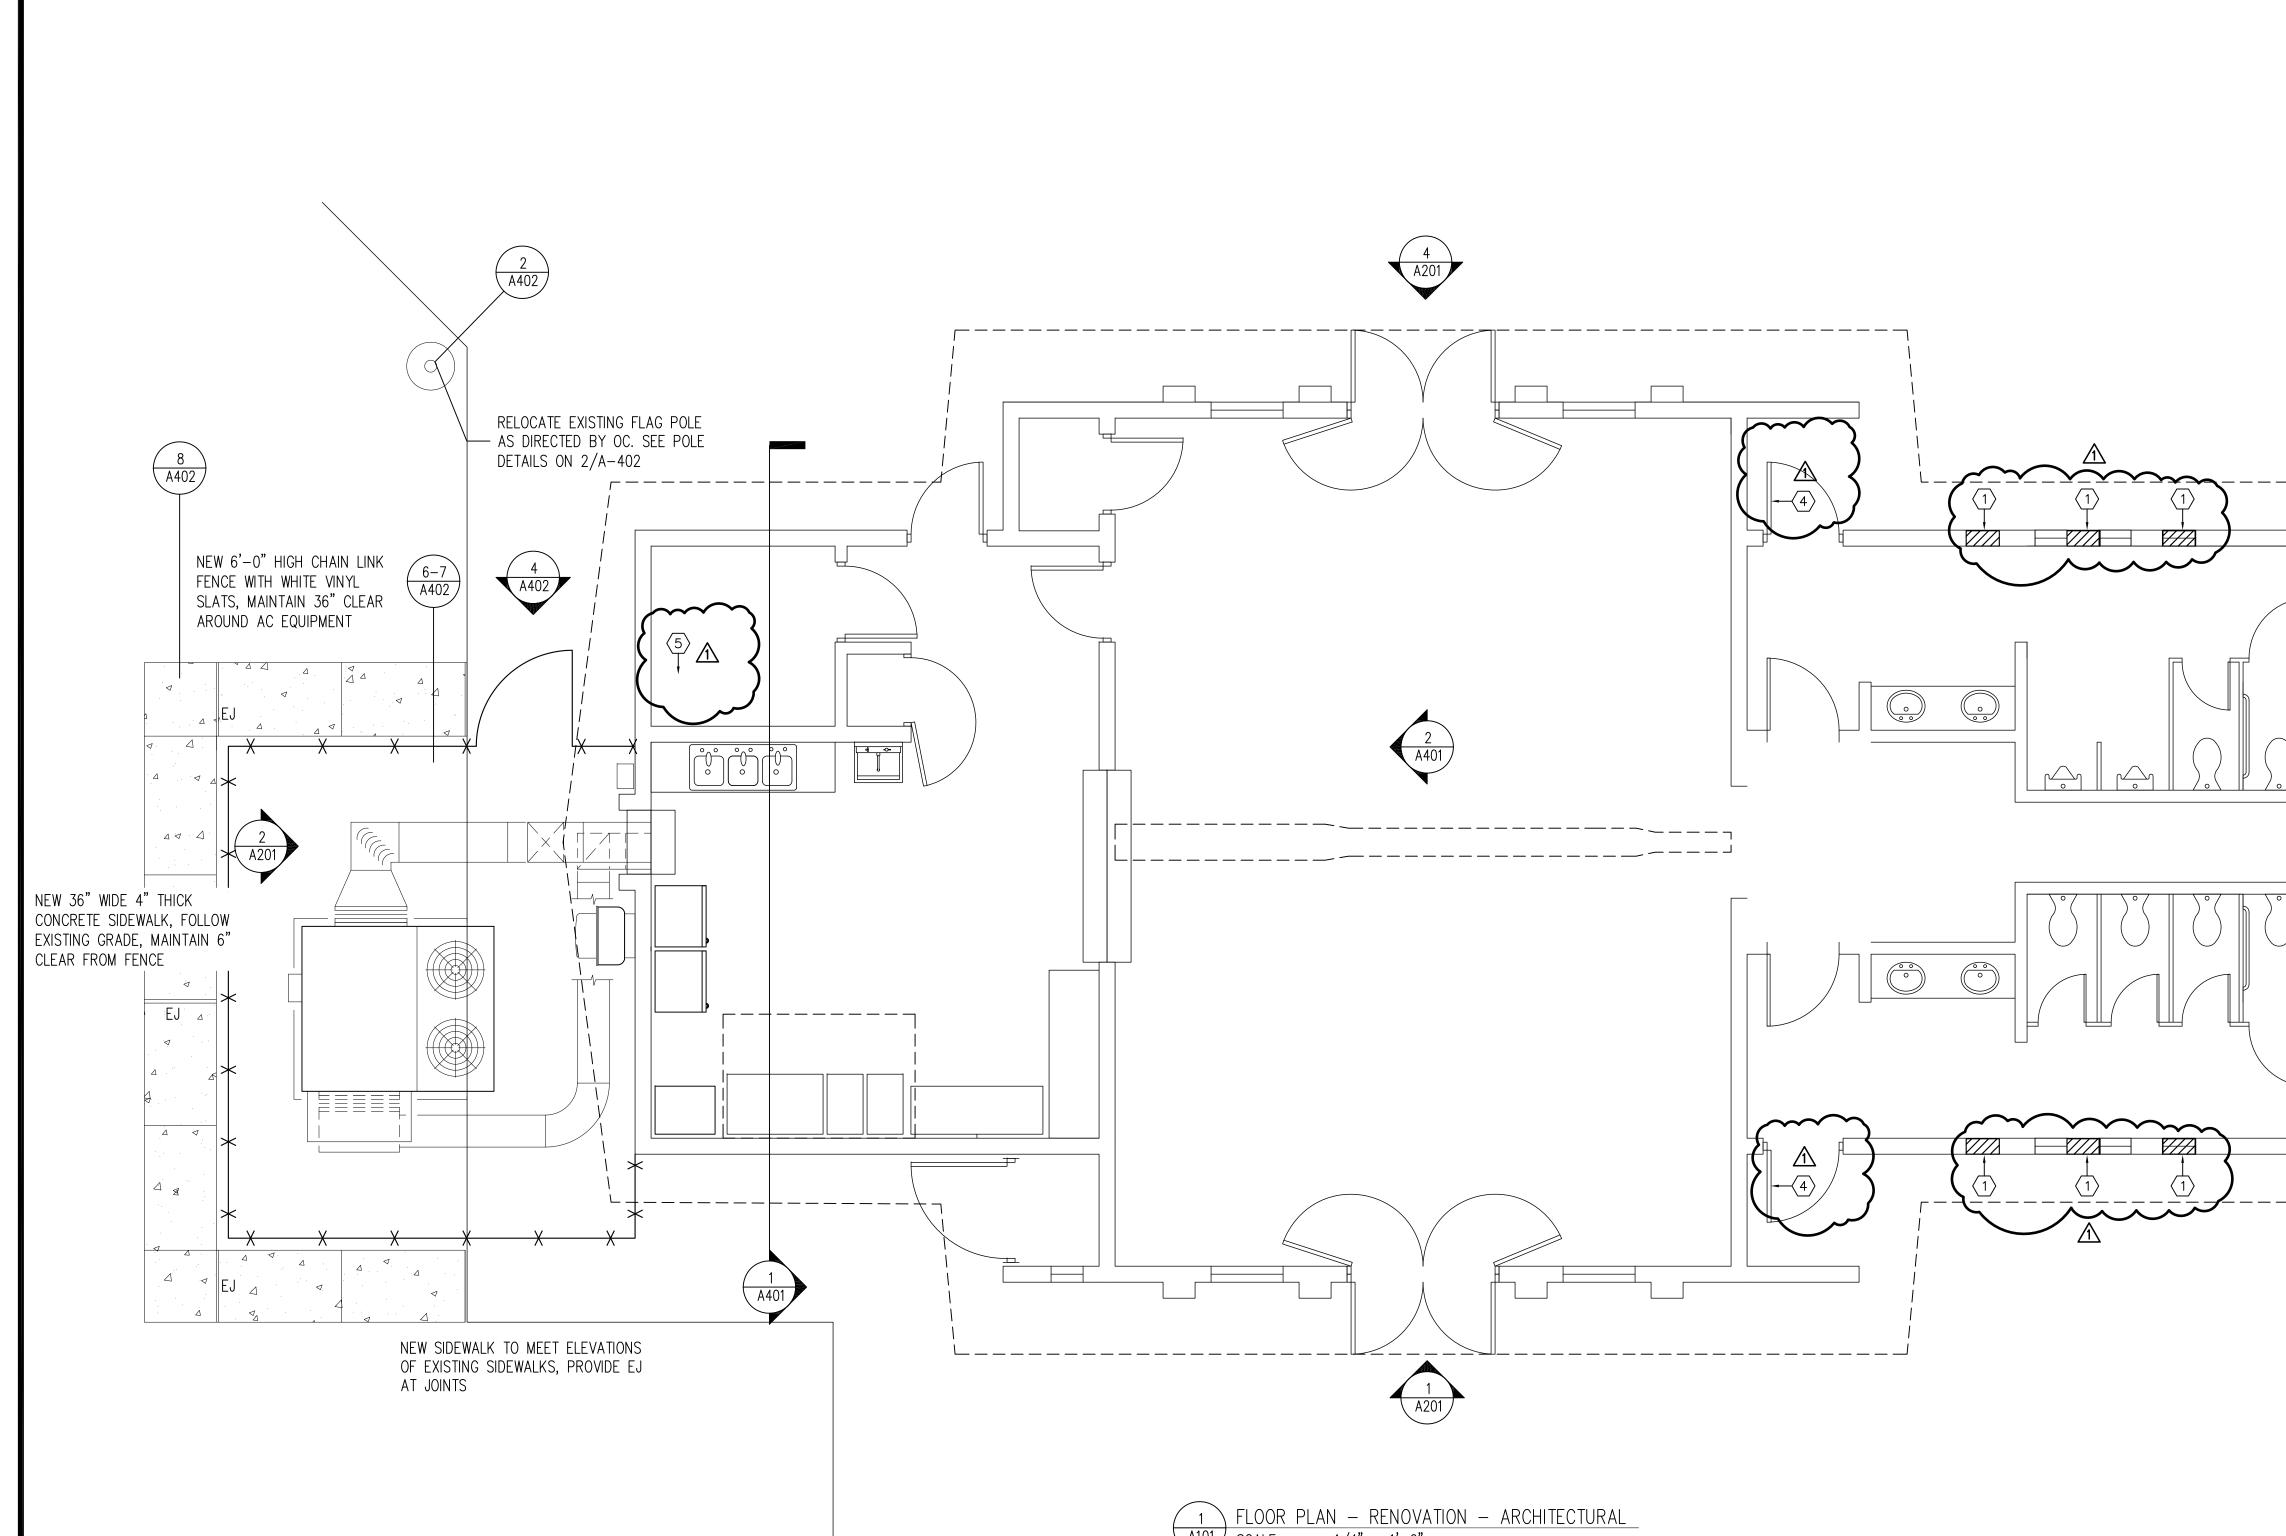

 $\begin{array}{|c|c|c|c|c|c|c|c|}\hline 1 & FLOOR & PLAN & - & RENOVATION & - & ARCHITECTURAL\\\hline A101 & SCALE: & 1/4" &= 1'-0"\\\hline \end{array}$

	<image/> <image/> <image/> <text><text><text><text><text><text><text></text></text></text></text></text></text></text>
HEX.NOTES HEX.NOTES	Revisions No. Date Description 1 11/10/14 Revision No. 1 1 11/10/14 1 1 11/10/14 1 1 11/10/14 1 1 11/10/14 1 1 11/10/14 1 1 11/10/14 1 1 11/10/14 1 1 11/10/14 1 1 11/10/14 1 1 11/10/14 1 1 11/10/14 1 1 11/10/14 1 1 11/10/14 1 1 11/10/14 1 1 11/10/14 1 1 11/10/14 1 1 11/10/14 1 1 11/10/14 1 1 11/10/14 1 1 11/10 1 </td




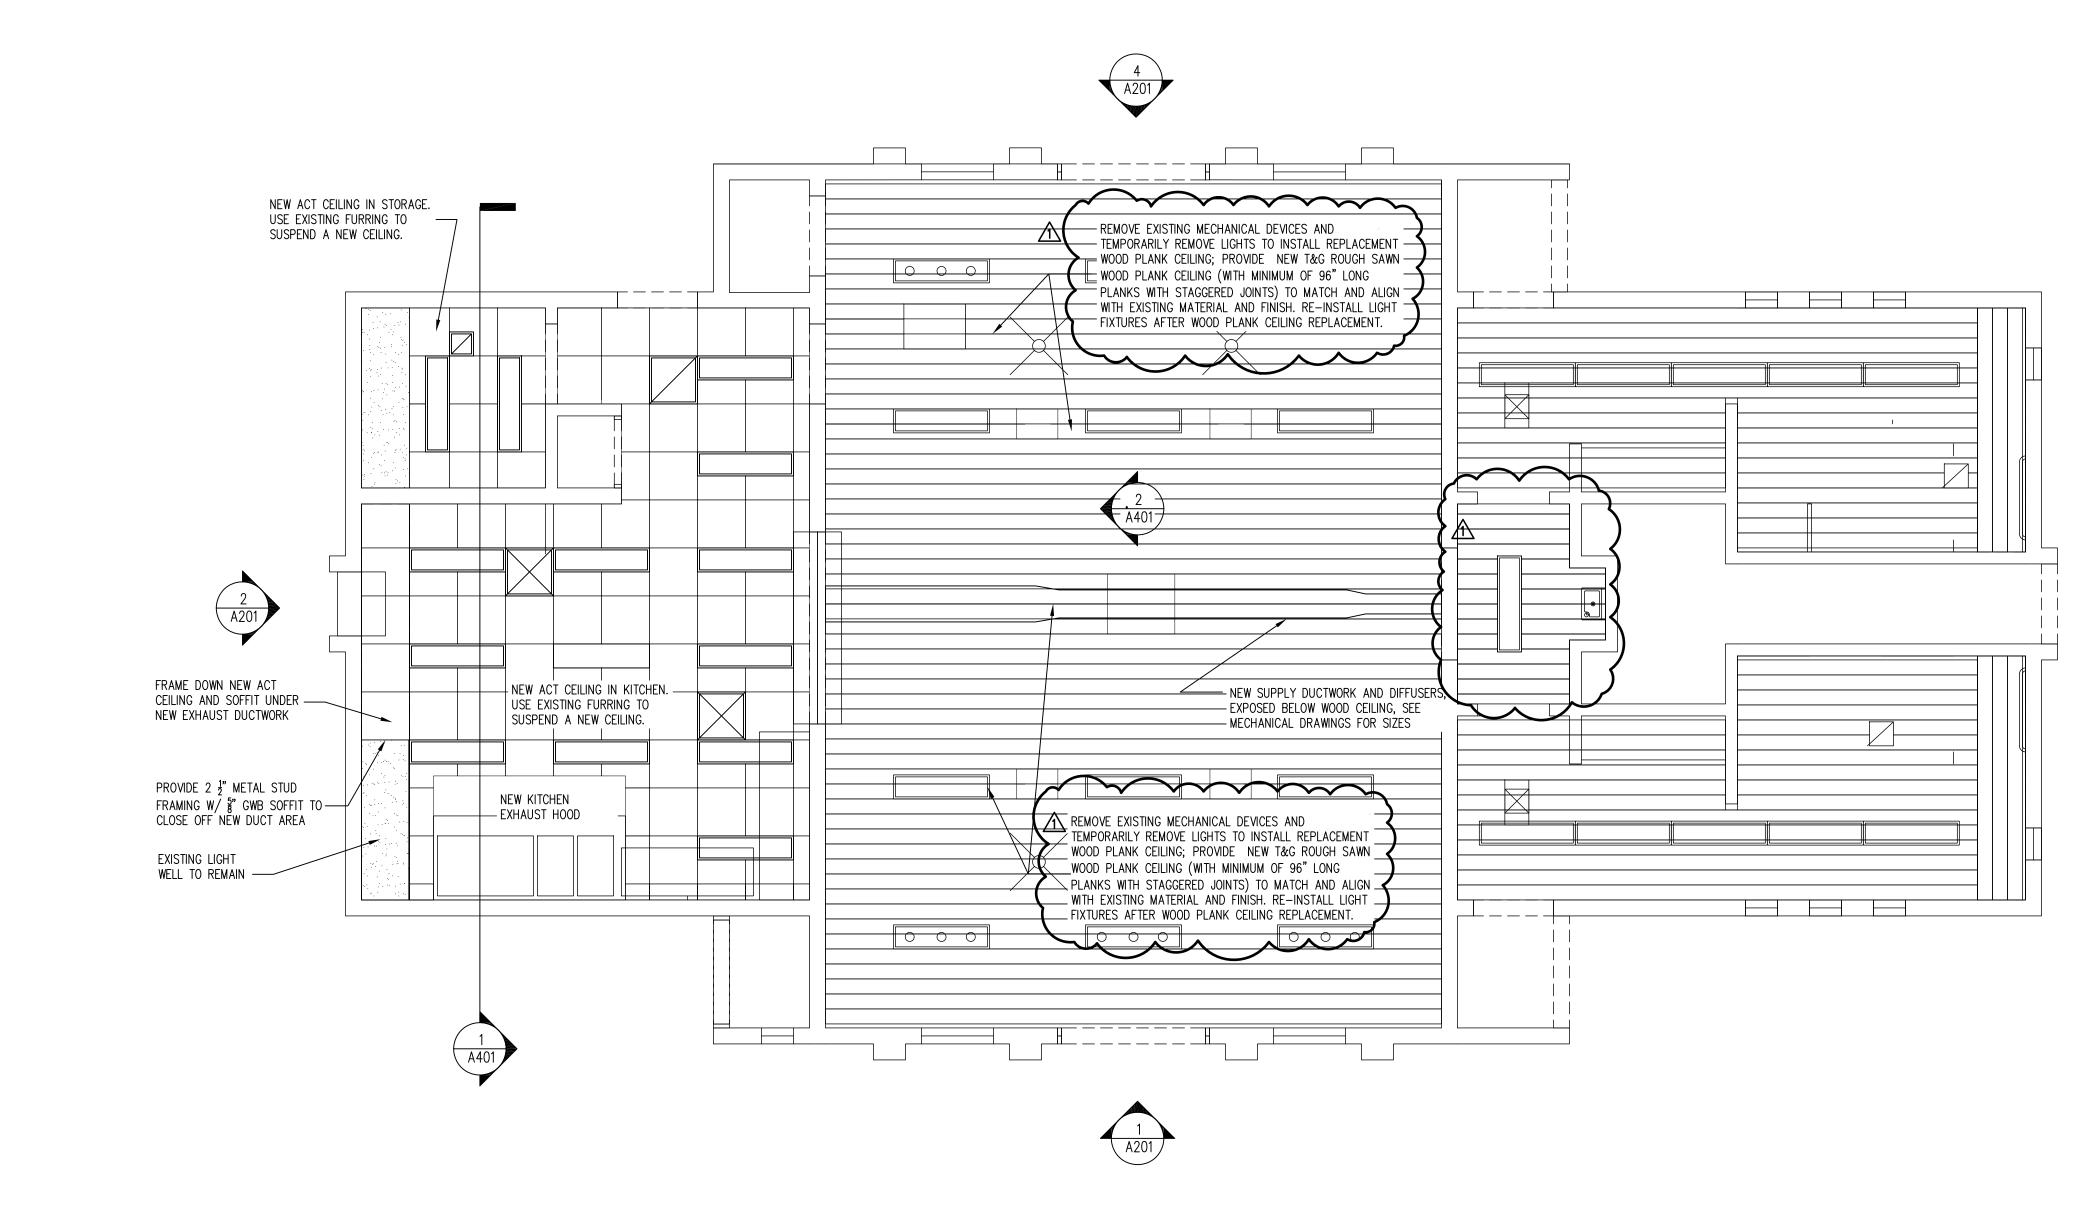

1	REFLECTED	CEILING PLAN – RENOVATION – ARCHITECTURAL	
A102/	SCALE:	1/4" = 1'-0"	

	<image/> <image/> <text><text><text><text><text><text><text><text></text></text></text></text></text></text></text></text>
 HEX NOTES PLOSTING FLOOR VENUS ARE TO REMAIN AT NON-AIR CONDITIONED SPACES. THOROUGHLY CLEAN LOWERS AND REMOVE LANDSCAPING MUCH A MIN. OF 12⁻ FROM DIAL CONFERS IN PREDMATION FOR MECHANICAL EXHIBIT: PROVIDE NOS WOOD TRIM AND CEMENT BOARD PREL AS SHOWI IN DETAIL ON 3/A-402. PREMOVE EXISTING WECKENNCL ROOF EXHILIST. CAP CURB WITH CAIN. SHET METAL COORE: PROVIDE NASKETED ATTACHMENTS TO EXISTING OCCEPT PRIME TO BOOK CONFERS. LEAN EXISTING DOOR LOWERS AT TOTELTS AND PROTOE TO HOME CASKETED ATTACHMENTS TO EXISTING DESCRIPTION TO MUCH STORE DOOR LOWERS. STORED IN A DESCRIPTION OF CONFERS. CLEAN EXISTING DOOR LOWERS AT TOTELTS AND PROTOC TROME DAMAGE. ALL ENSTING WAC EQUIPMENT IS TO BE SALWAGED AND STORED IN A DESCRIPTION CONFIGURATION DAMAGE. ALL ENSTING WAC/PLASTER CELLING IN ITS ENTIRETY. RETAIN DISTING TURRING. IT THEORY RESE WECHANCLL PLANS FOR SUPERFIDE ADDEMAILS. REMOVE EXISTING GAR/PLASTER CELLING STIME. THORNERS AND INTALL NEW ACT CELLING AS SHOWIN IN REFLECTED CELLING FUNK MIN AND INSTALL NEELED CELLING STIME. THERE FOR THE PLANS HAD INSTALL NEELED CELLING STOR. THEN INSTALL NEW ACT CELLING AS SHOWIN IN REFLECTED CELLING FUNK MIN AND INSTALL NEELED CELLING STOR. THE PRIME HAD INSTALL PLANS HAD INSTALL NEW ACT CELLING AS SHOWIN IN REFLECTED CELLING FUNK MIN AND INSTALL NEELED CELLING STOR. THE PLANS HAD INSTALL PLANS HAD INSTALL NEELED CELLING STOR IN THE PARE THE DETAIL. PART TO MATCH TRAN. SEE MECH DRAWINGS FOR NEW HAXC EQUIPMENT AND DUCTIVORK. 	Phone: 407-839-5501 Fax: 407-839-0668 Revisions No. Date Description 1 11/10/14 Revision No. 1 Image: Im

(3) A201

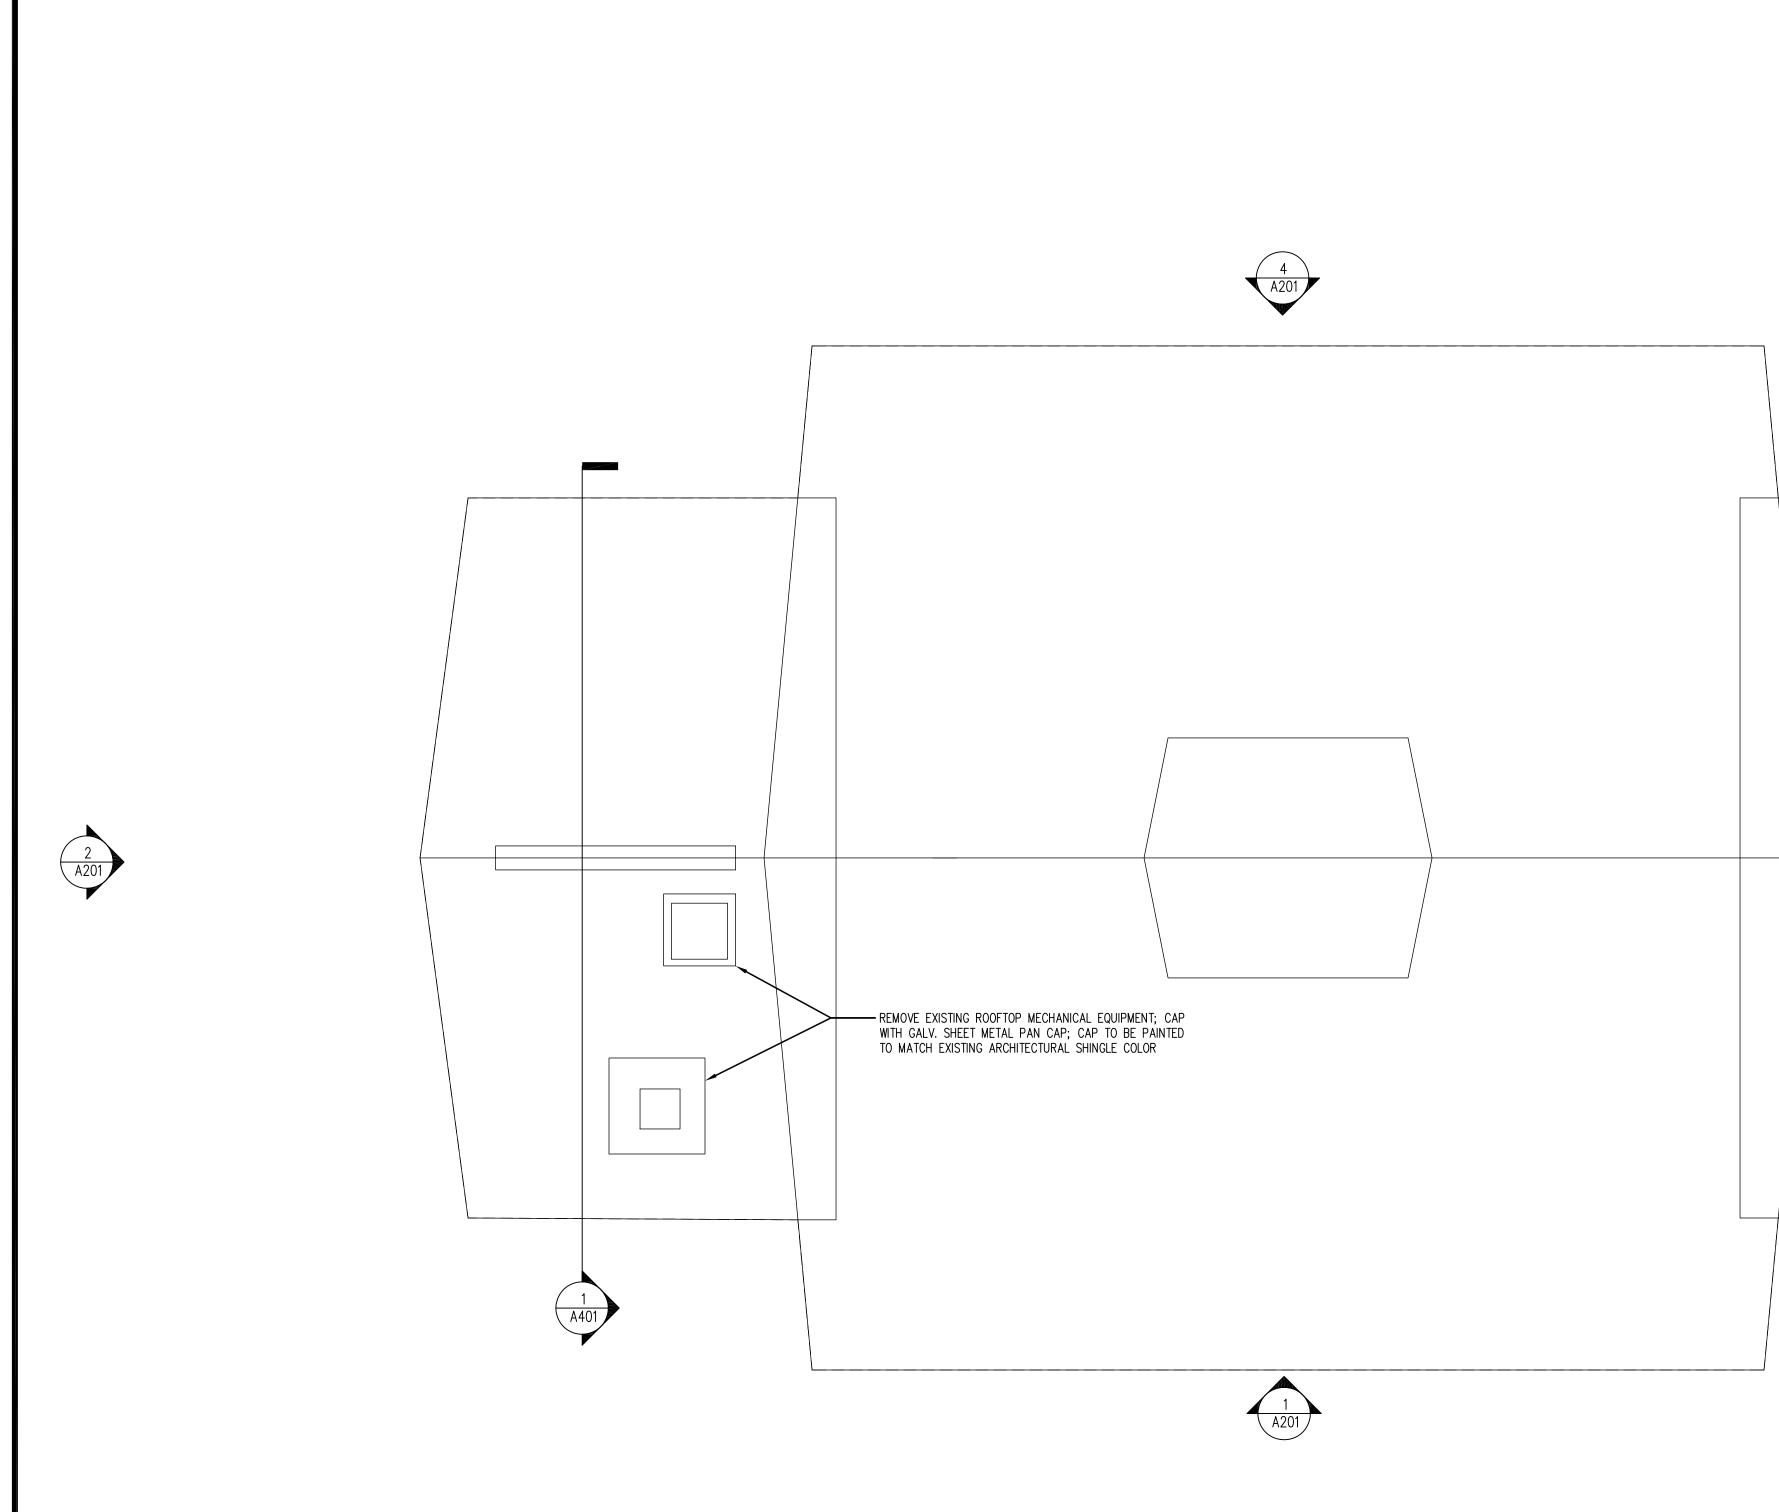


 $\begin{array}{|c|c|c|c|c|c|c|c|}\hline 1 & ROOF PLAN - RENOVATION - ARCHITECTURAL\\\hline A103 & SCALE: & 1/4" = 1'-0"\end{array}$


		<image/> <image/> <image/> <text><text><text><text><text><text><text></text></text></text></text></text></text></text>
3 A201		Revisions No. Date Description
		1 11/10/14 Revision No. 1
	 HEX.NOTES EXISTING FLOOR VENTS ARE TO REMAIN AT NON-AIR CONDITIONED SPACES. THOROUGHLY CLEAN LOUVERS AND REMOVE LANDSCAPING MULCH A MIN. OF 12° FROM THE LOUVERS. PROTECT FROM DAMAGE. REMOVE EXISTING TRANSOM GLASS PANELS IN PREPARATION FOR MECHANICAL EXHAUST. PROVIDE NEW WOOD TRIM AND CEMENT BOARD PANEL AS SHOWN IN DETAIL ON 3/A-402. REMOVE EXISTING MECHANICAL ROOF EXHAUST. CAP CURB WITH GALY. SHEET METAL COVER. PROVIDE GASKETED ATACHMENTS TO EXISTING CURB DAMIL TO MATCH EMDICLE POOT COLOR AND TRANSMIC TO THE UNIVERS. CLEAN EXISTING DOOR LOUVERS AT TOLLETS AND PROTECT FROM DAMAGE. ALL ENSTING HVAC EQUIPMENT IS TO BE SALVAGED AND STORED IN A DESIGNATED AREA FOR THE OWNER. SEE MECHANICAL PLANS FOR SUSPENDED ACCUSTICAL CELLING SYSTEM. FURNISH AND INSTALL NEW ACT CELLING AS SHOWN IN REFLECTED CELLING PLAN REMOVE EXISTING GWB/PLASTER CELLING IN ITS ENTIRETY. RETAIN EXISTING FURRING IF IT HELPS PROVIDE SUPPORT FOR THE NEW SUSPENDED ACCUSTICAL CELLING SYSTEM. FURNISH AND INSTALL NEW ACT CELLING AS SHOWN IN REFLECTED CELLING PLAN REMOVE EXISTING TRANSOM GLASS AND STOPS IN ITS ENTIRETY. PURNISH AND INSTALL NEW CEMENT BOARD INFILL PAREL PER DETAIL PARISH AND DUCTWORK. 	Key Plan MPE PROJ#: 2013–079 Designed By: GG Drawn By: GG Checked By: RB Issue Date: 11/10/14 Drawing Scale: 1/4"=1'-0" Drawing Title: ROOF PLAN RENOVATION ARCHITECTURAL 100% CONSTRUCTION DOCUMENTS Drawing No. A 1 0 3





The function of the first of th	HER MOTES HER MOTES	<image/> <image/> <image/> <image/> <text><text><text><text><text><text></text></text></text></text></text></text>
RB 1/4"=1'-0" Drawing Title: EXTERIOR ELEVATIONS 100% CONSTRUCTION DOCUMENTS	PAINT TO MATCH TRIM. SEE MECH DRAWINGS FOR NEW HVAC	
Drawing Title: EXTERIOR ELEVATIONS 100% CONSTRUCTION DOCUMENTS		
EXTERIOR ELEVATIONS 100% CONSTRUCTION DOCUMENTS		
		EXTERIOR
A 2 0 1		
		A201

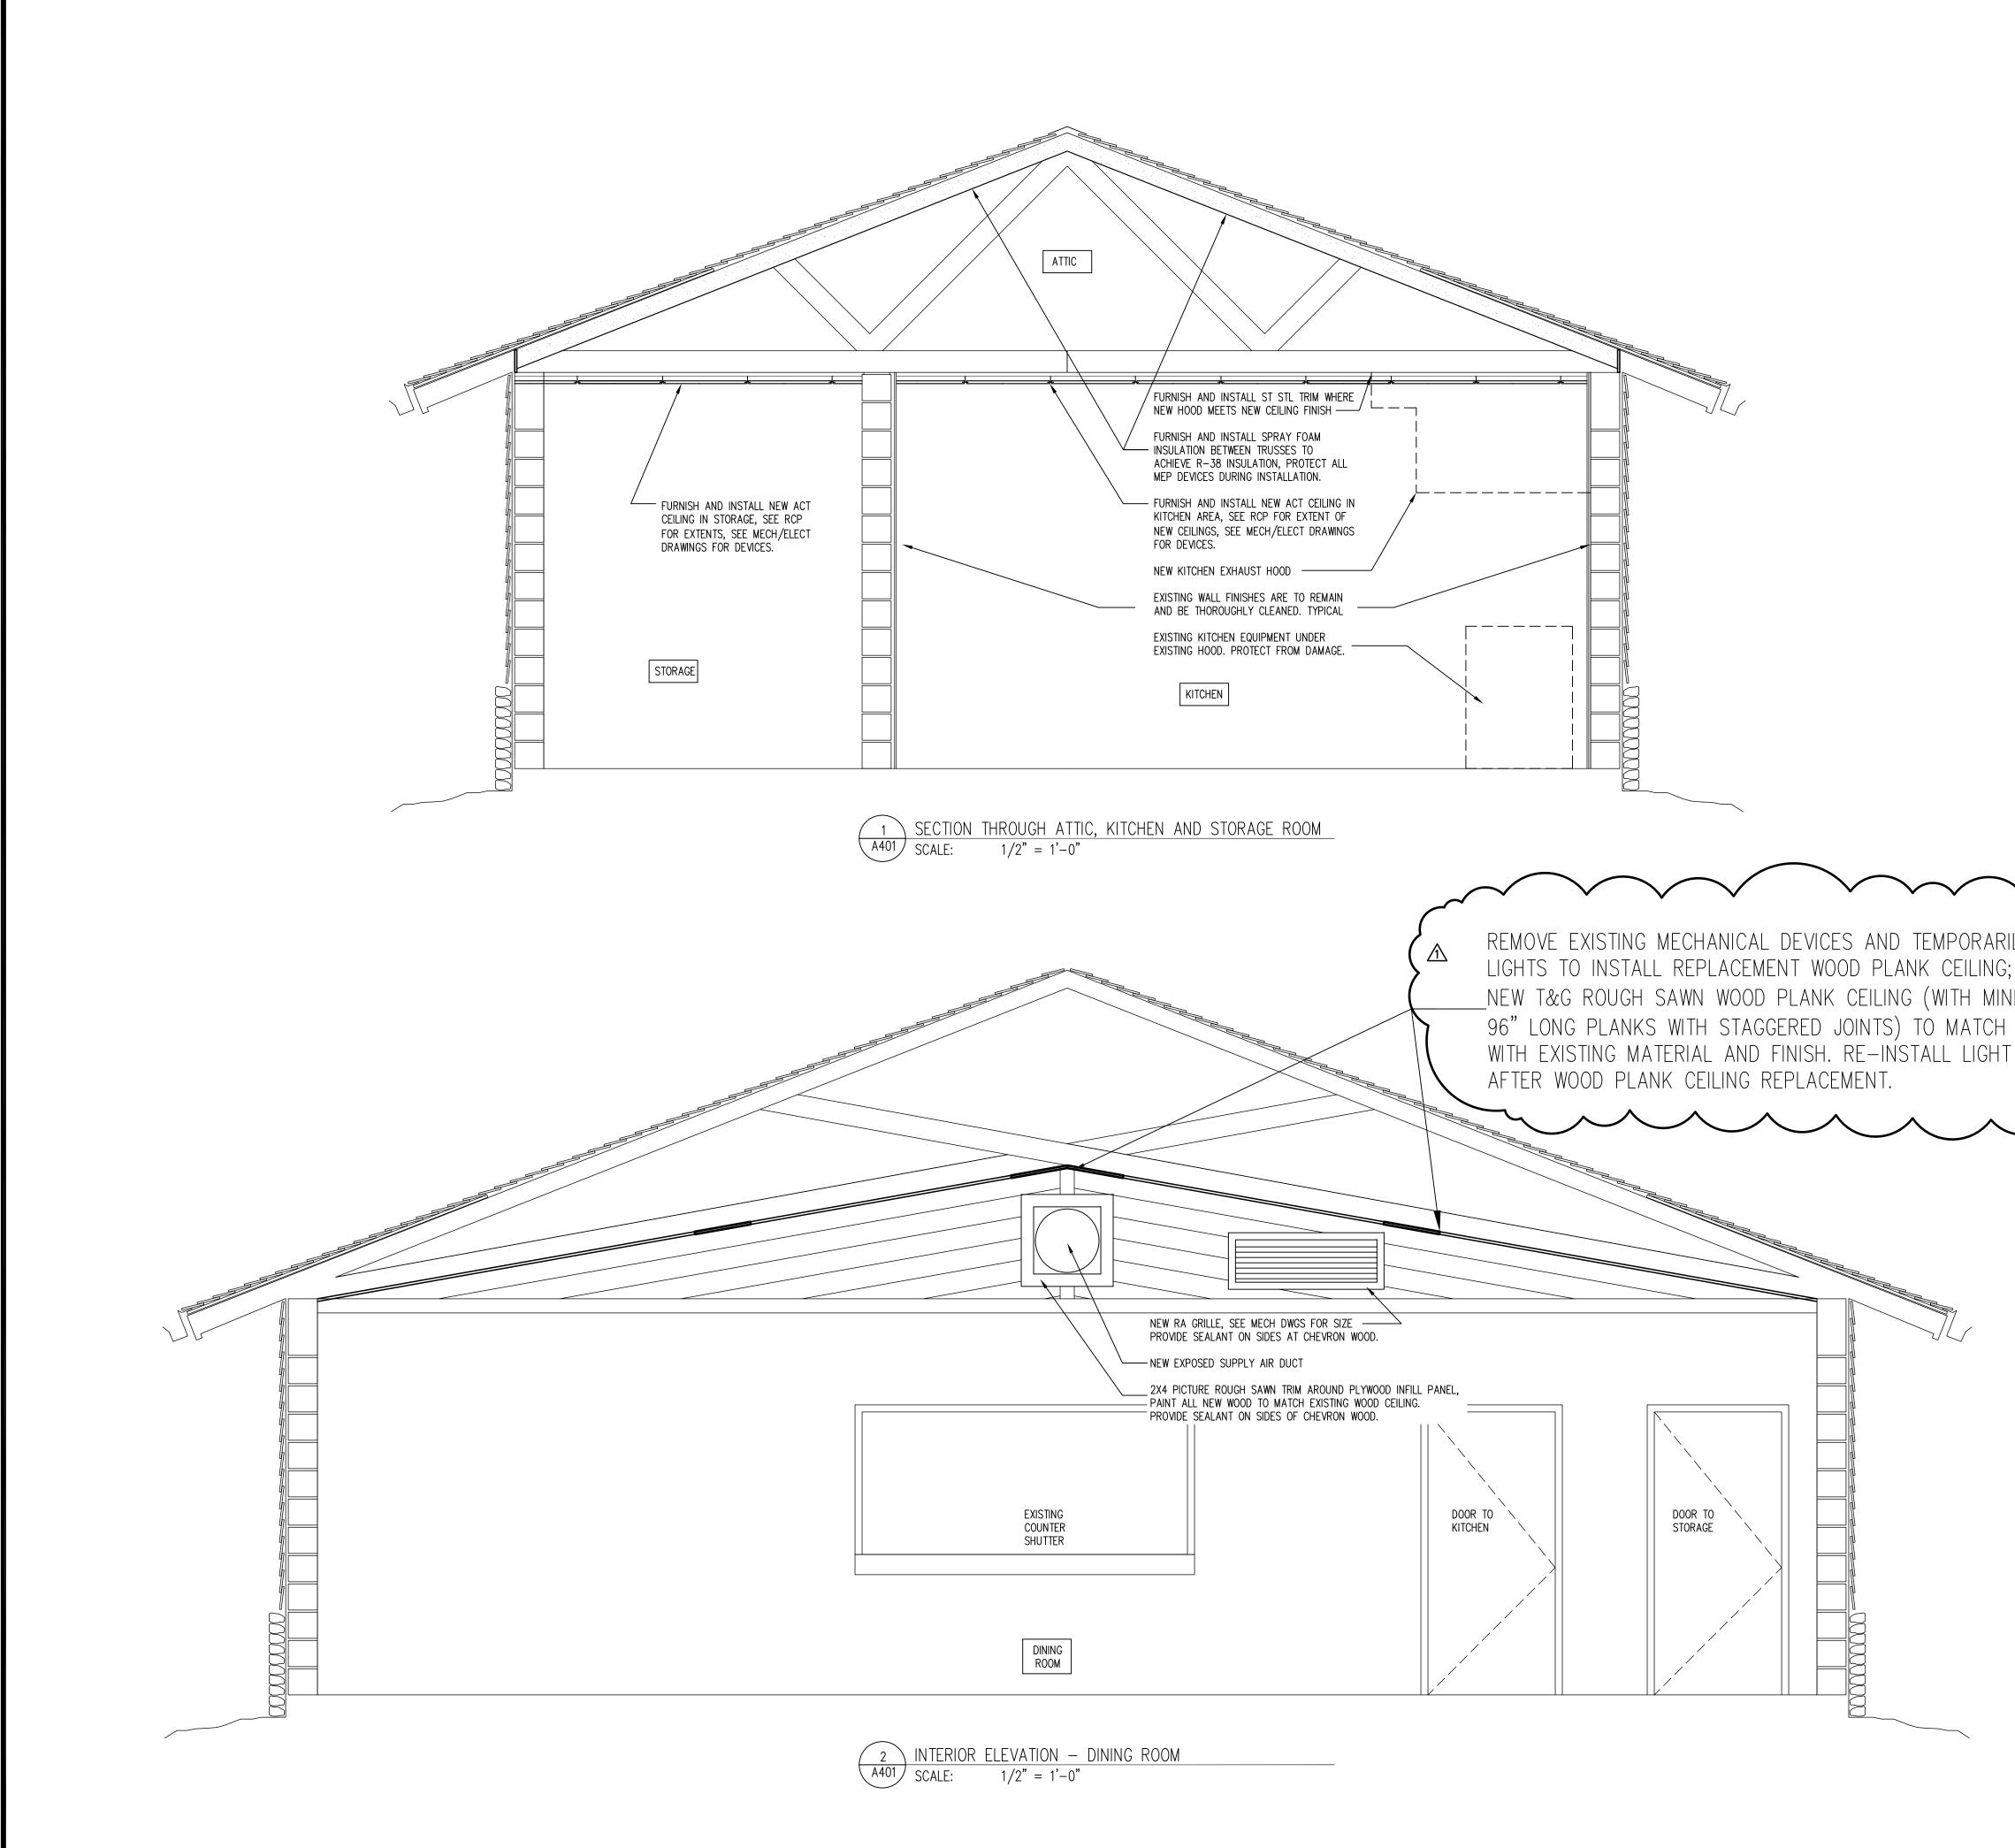

		<image/> <image/> <image/> <text><text><text><text><text><text><text></text></text></text></text></text></text></text>
RILY REMOVE G; PROVIDE INIMUM OF H AND ALIGN IT FIXTURES		No. Date Description 1 11/10/14 Revision No. 1 11/10/14 Revision No. 1 1 1 1
	 EXISTING FLOOR VENTS ARE TO REMAIN AT NON-AIR CONDITIONED SPACES. THOROUGHLY CLEAN LOUVERS AND REMOVE LANDSCAPING MULCH A MIN. OF 12" FROM THE LOUVERS. PROTECT FROM DAMAGE. REMOVE EXISTING TRANSOM GLASS PANELS IN PREPARATION FOR MECHANICAL EXHAUST. PROVIDE NEW WOOD TRIM AND CEMENT BOARD PANEL AS SHOWN IN DETAIL ON 3/A-402. REMOVE EXISTING MECHANICAL ROOF EXHAUST. CAP CURB WITH GALV. SHEET METAL COVER. PROVIDE GASKETED ATTACHMENTS TO EXISTING WITH, TO MATCH STNNOLE ROOF COLOR. SHEET METAL COVER. PROVIDE GASKETED ATTACHMENTS TO EXISTING WITH, TO MATCH STNNOLE ROOF COLOR. LOUVERS AT TOILETS AND PROTECT FROM DAMAGE. REMOVE EXISTING HVAC EQUIPMENT IS TO BE SALVAGED AND STORED IN A DESIGNATED AREA FOR THE OWNER. SEE MECHANICAL PLANS FOR SPECIFIC EQUIPMENT. ALL EXISTING GVB/PLASTER CELLING IN ITS ENTIRETY. RETAIN EXISTING FURRING IF IT HELPS PROVIDE SUPPORT FOR THE NEW SUSPENDED ACOUSTICAL CELLING SYSTEM. FURNISH AND INSTALL NEW ACT CELLING AS SHOWN IN REFLECTED CELLING PLAN REMOVE EXISTING TRANSOM GLASS AND STORD IN ITS ENTIRETY. PANEL PER DETAIL. PAINT TO MATCH TRIM. SEE MECH DRAWINGS FOR NEW HVAC EQUIPMENT AND DUCTWORK. 	Key Plan MPE PROJ#: 2013-079 Designed By: GG Drawn By: GG Checked By: RB Issue Date: 11/10/14 Drawing Scale: 1/2"=1'-0" Drawing Title: SECTION AND INTERIOR ELEVATION
		100 % CONSTRUCTION DOCUMENTS Drawing No. $A 4 0 1$

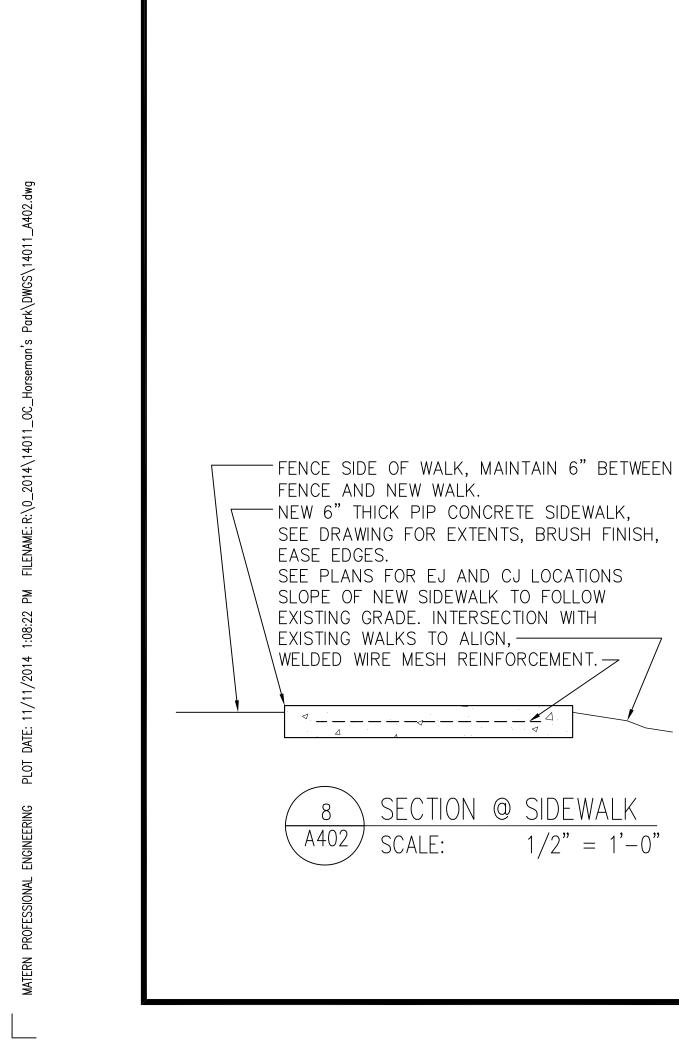


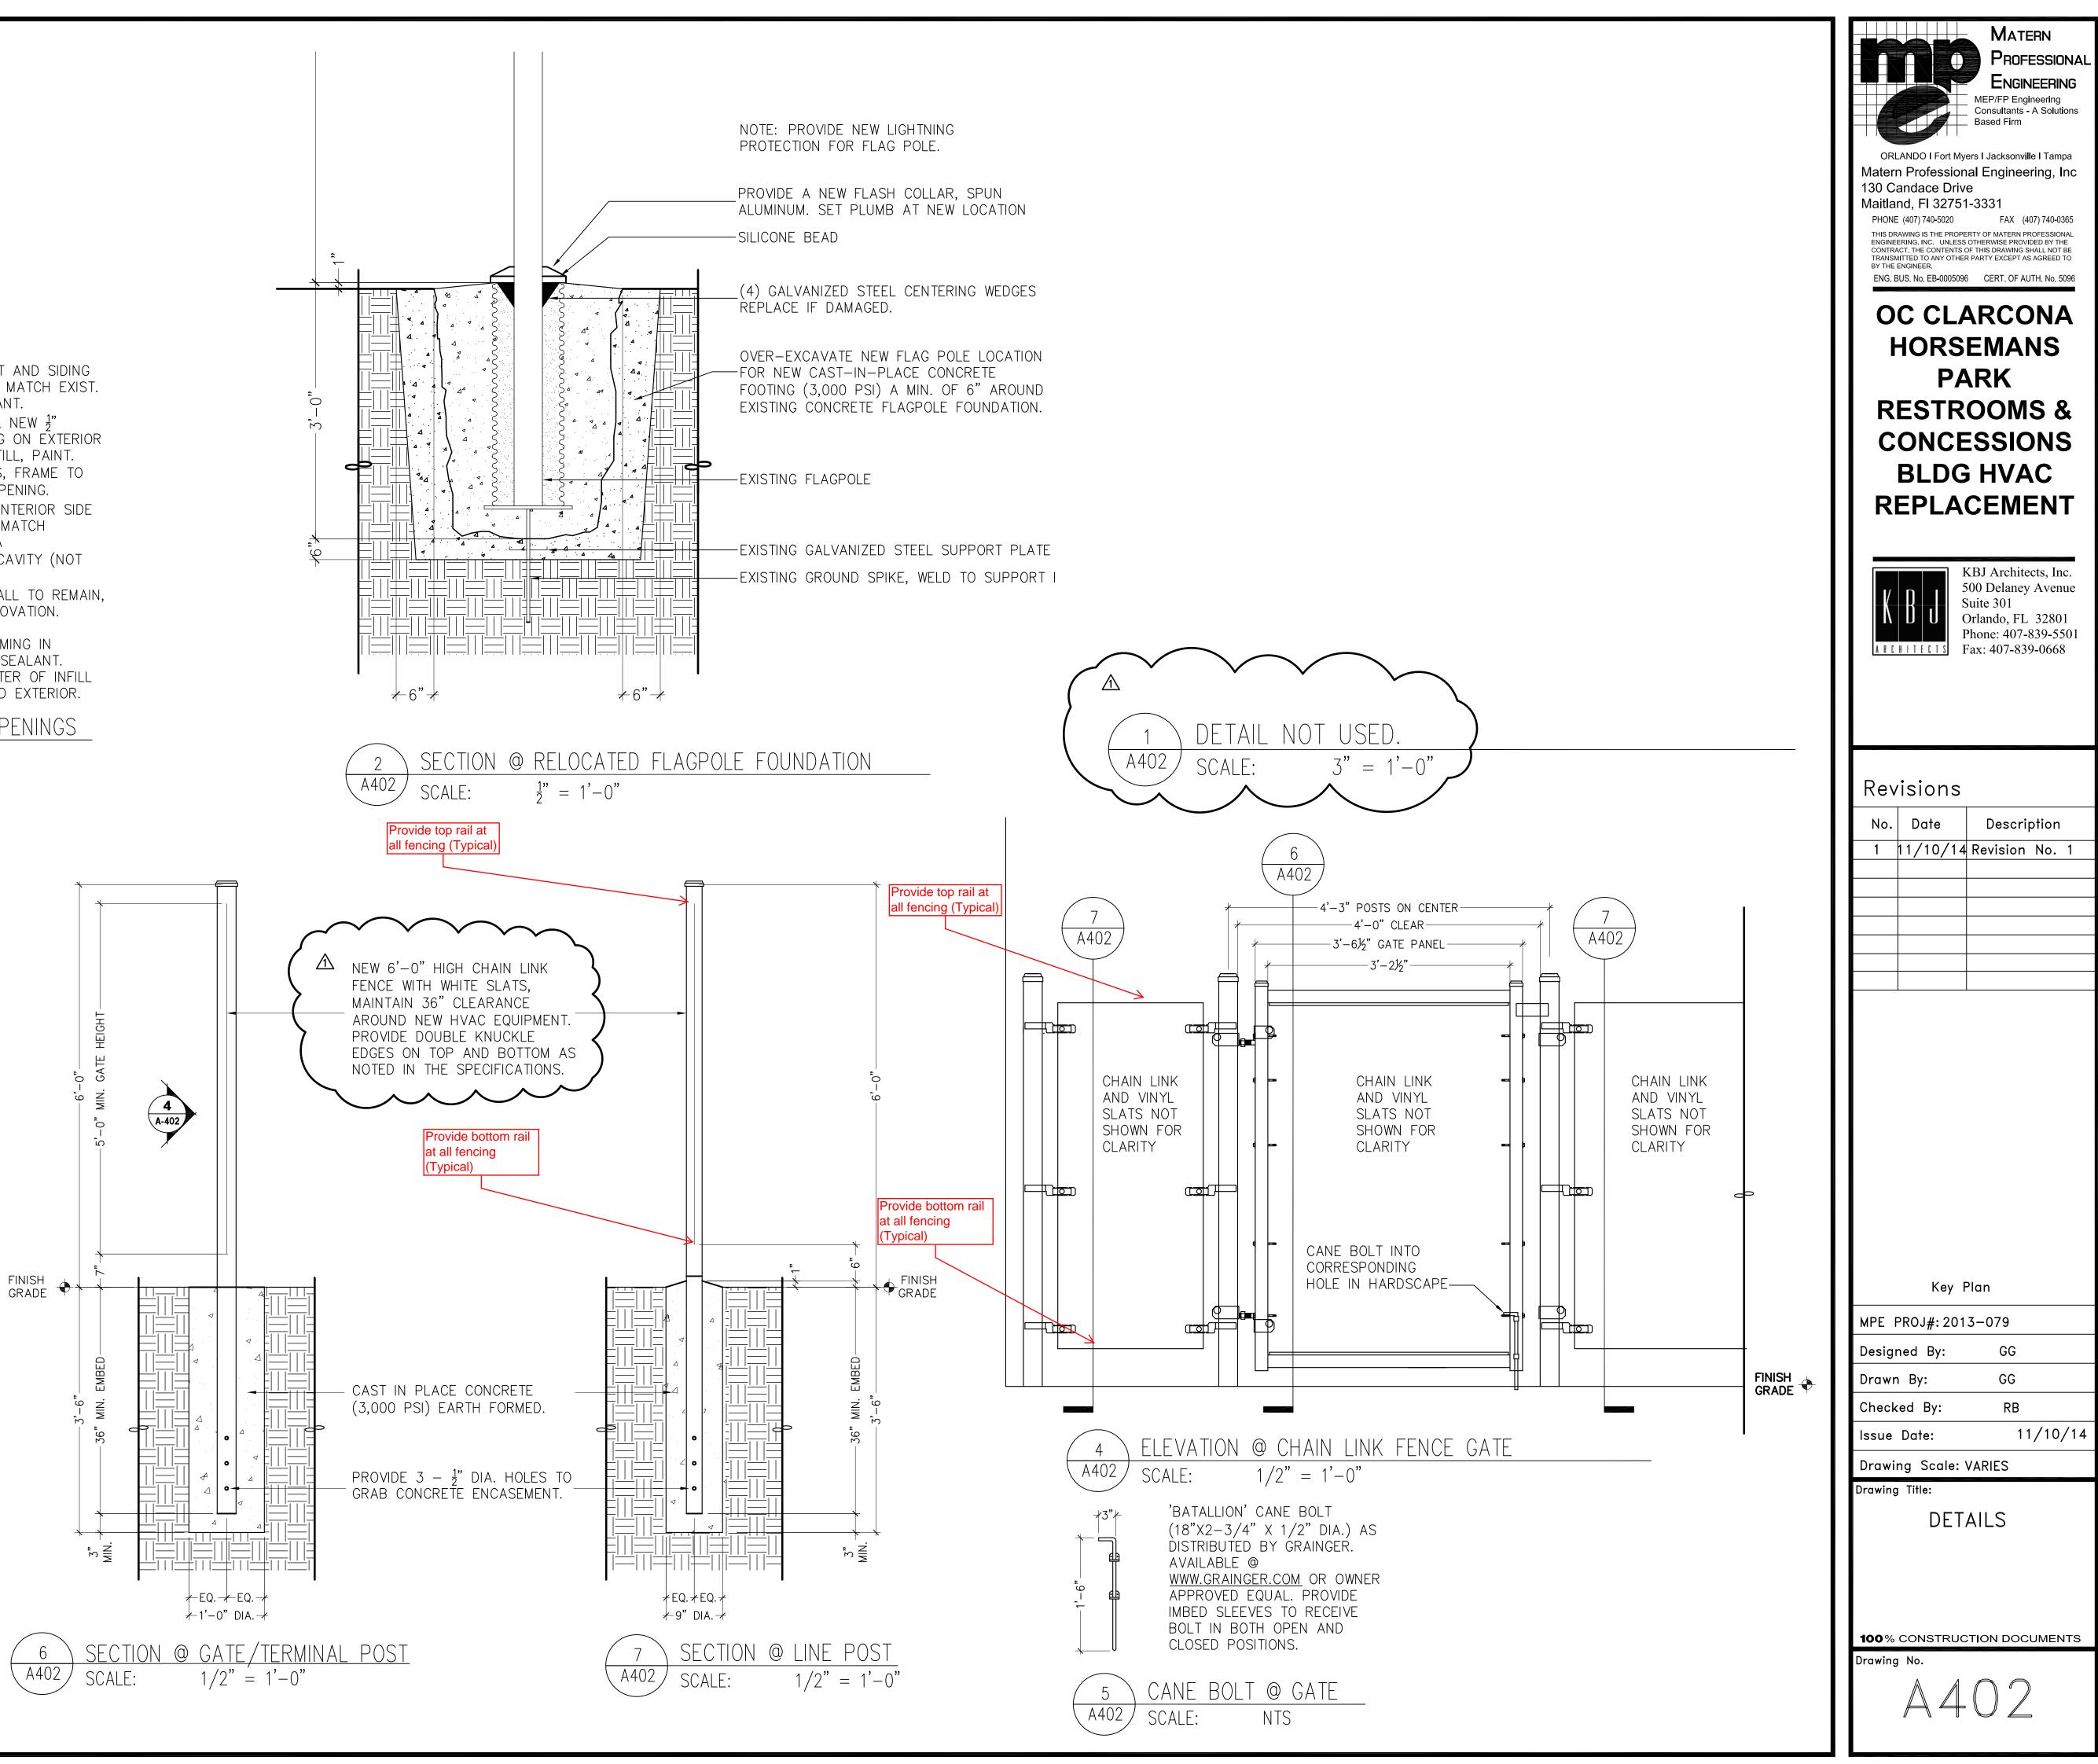

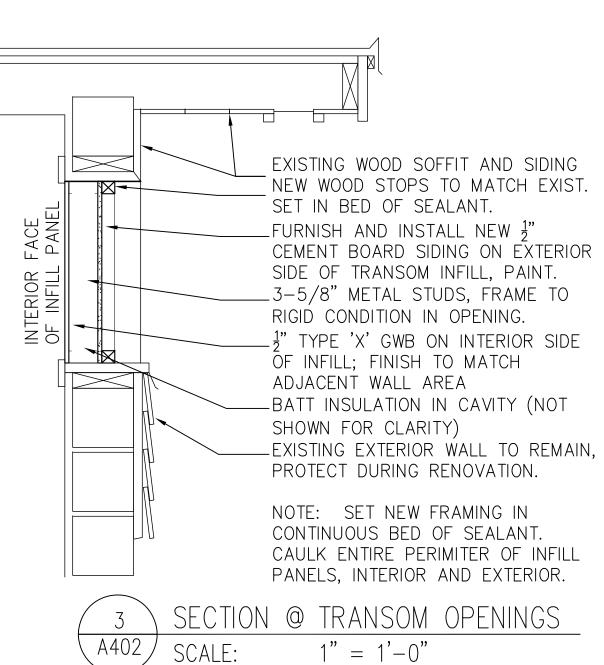


1/2" = 1'-0"



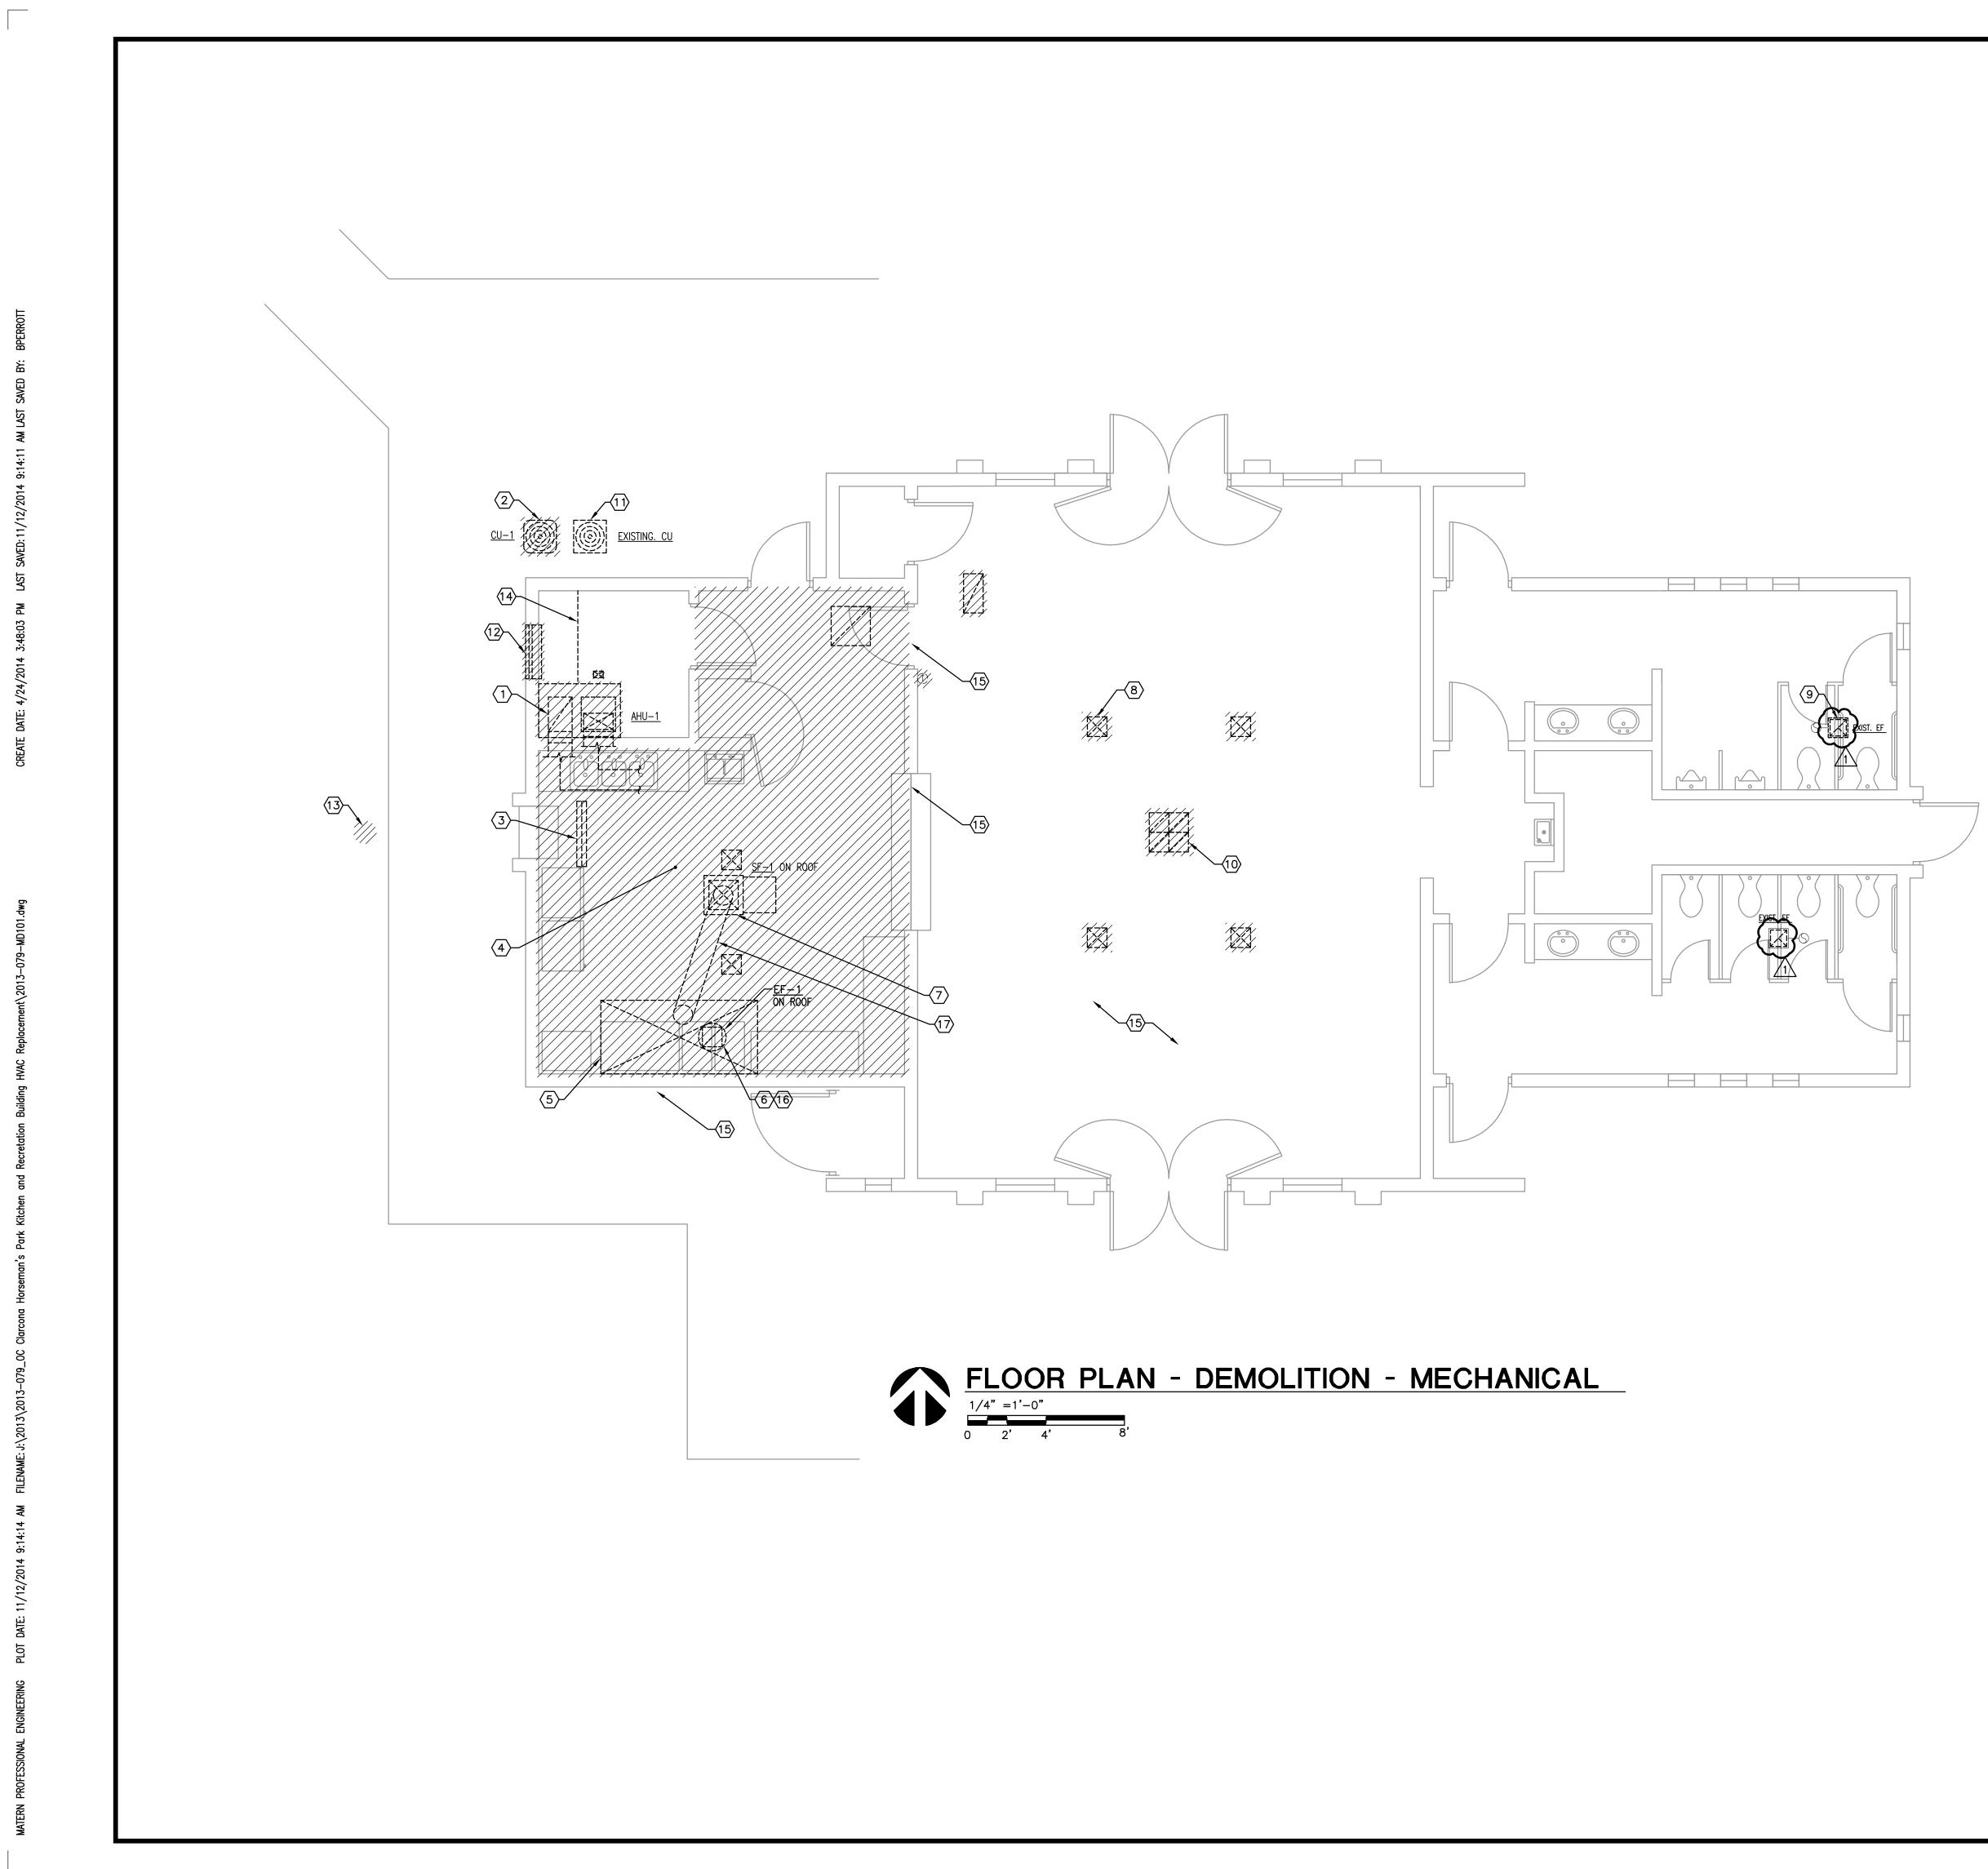

GENE	ERAL NOTES	
1.	REFER TO GENERAL NOTES FOR THIS DISCIPLINE.	PROFESSIONAL
	REFER TO SPECIFICATIONS. ALL HEX NOTES NOT NECESSARILY USED ON ALL SHEETS.	Engineering
	ALL UNUSED ROOF AND EXTERIOR PENETRATIONS SHALL BE	Consultants - A Solutions Based Firm
5.	PROPERLY CAPPED AND SEALED WATER TIGHT. REFER TO ARCHITECTURAL. ALL EXISTING MECHANICAL EQUIPMENT, DUCTWORK, PIPING AND	ORLANDO I Fort Myers I Jacksonville I Tampa Matern Professional Engineering, Inc
6.	ACCESSORIES ARE SCHEDULED TO BE REMOVED UNLESS NOTED OTHERWISE. EXISTING WORK MAY NOT BE SHOWN FOR CLARITY. THE FACILITY SHALL REMAIN UNOCCUPIED FOR CERTAIN DURATIONS	130 Candace Drive Maitland, FI 32751-3331 PHONE (407) 740-5020 FAX (407) 740-0365
	OF THE PROJECT. ALL INDOOR AND OUTDOOR WORK SHALL BE PERFORMED DURING NORMAL BUSINESS HOURS DURING THE WEEK. NORMAL BUSINESS HOURS ARE DEFINED AS 7:00 AM TO 5:00 PM, MONDAY TO FRIDAY.	THIS DRAWING IS THE PROPERTY OF MATERN PROFESSIONAL ENGINEERING, INC. UNLESS OTHERWISE PROVIDED BY THE CONTRACT, THE CONTENTS OF THIS DRAWING SHALL NOT BE TRANSMITTED TO ANY OTHER PARTY EXCEPT AS AGREED TO BY THE ENGINEER. ENG. BUS. No. EB-0005096 CERT. OF AUTH. No. 5096
		OC CLARCONA HORSEMANS PARK RESTROOMS & CONCESSIONS BLDG HVAC REPLACEMENT
		Revisions No. Date Description 1 11/10/14 REVISION #1
HEX	NOTES	
HEX (1)	EXISTING AIR-HANDLING UNIT, SUPPLY, AND RETURN DUCTWORK TO BE REMOVED IN THEIR ENTIRETY, INCLUDING WOOD PLATFORM UNDERNEATH. EXISTING CONDENSATE PIPING AND PUMP TO BE	
	EXISTING AIR-HANDLING UNIT, SUPPLY, AND RETURN DUCTWORK TO BE REMOVED IN THEIR ENTIRETY, INCLUDING WOOD PLATFORM	
	EXISTING AIR-HANDLING UNIT, SUPPLY, AND RETURN DUCTWORK TO BE REMOVED IN THEIR ENTIRETY, INCLUDING WOOD PLATFORM UNDERNEATH. EXISTING CONDENSATE PIPING AND PUMP TO BE REMOVED. EXISTING CONDENSING UNIT CONNECTED TO AHU TO BE REMOVED IN ITS ENTIRETY, INCLUDING CONNECTED REFRIGERANT PIPING AND	
(1)	EXISTING AIR-HANDLING UNIT, SUPPLY, AND RETURN DUCTWORK TO BE REMOVED IN THEIR ENTIRETY, INCLUDING WOOD PLATFORM UNDERNEATH. EXISTING CONDENSATE PIPING AND PUMP TO BE REMOVED. EXISTING CONDENSING UNIT CONNECTED TO AHU TO BE REMOVED IN ITS ENTIRETY, INCLUDING CONNECTED REFRIGERANT PIPING AND DISCONNECT SWITCH. EXISTING EXHAUST GRILLE IN SOFFIT AND CONNECTED ATTIC FAN TO BE REMOVED IN THEIR ENTIRETY. REMOVE EXISTING WALL SWITCH	
 (1) (2) (3) 	EXISTING AIR-HANDLING UNIT, SUPPLY, AND RETURN DUCTWORK TO BE REMOVED IN THEIR ENTIRETY, INCLUDING WOOD PLATFORM UNDERNEATH. EXISTING CONDENSATE PIPING AND PUMP TO BE REMOVED. EXISTING CONDENSING UNIT CONNECTED TO AHU TO BE REMOVED IN ITS ENTIRETY, INCLUDING CONNECTED REFRIGERANT PIPING AND DISCONNECT SWITCH. EXISTING EXHAUST GRILLE IN SOFFIT AND CONNECTED ATTIC FAN TO BE REMOVED IN THEIR ENTIRETY. REMOVE EXISTING WALL SWITCH CONTROLLING ATTIC FAN. EXISTING KITCHEN HARD CEILING TO BE REMOVED IN ITS ENTIRETY – REFER TO ARCHITECTURAL. ALL EXISTING SUPPLY AND RETURN DUCTWORK, DIFFUSERS AND GRILLES TO BE REMOVED IN THEIR	Key Plan
 (1) (2) (3) (4) 	EXISTING AIR-HANDLING UNIT, SUPPLY, AND RETURN DUCTWORK TO BE REMOVED IN THEIR ENTIRETY, INCLUDING WOOD PLATFORM UNDERNEATH. EXISTING CONDENSATE PIPING AND PUMP TO BE REMOVED. EXISTING CONDENSING UNIT CONNECTED TO AHU TO BE REMOVED IN ITS ENTIRETY, INCLUDING CONNECTED REFRIGERANT PIPING AND DISCONNECT SWITCH. EXISTING EXHAUST GRILLE IN SOFFIT AND CONNECTED ATTIC FAN TO BE REMOVED IN THEIR ENTIRETY. REMOVE EXISTING WALL SWITCH CONTROLLING ATTIC FAN. EXISTING KITCHEN HARD CEILING TO BE REMOVED IN ITS ENTIRETY – REFER TO ARCHITECTURAL. ALL EXISTING SUPPLY AND RETURN DUCTWORK, DIFFUSERS AND GRILLES TO BE REMOVED IN THEIR ENTIRETY. EXISTING KITCHEN EXHAUST HOOD TO BE REMOVED IN ITS ENTIRETY, INCLUDING ANSUL FIRE SUPPRESSION SYSTEM AND HOOD CONTROLS. ALL EXISTING KITCHEN EQUIPMENT TO REMAIN. REFER TO AD101 FOR INSTRUCTIONS REGARDING KITCHEN EQUIPMENT REMOVAL DURING DEMOLITION. EXISTING HOOD EXHAUST FAN ON ROOF TO BE REMOVED. CAP	
 1 2 3 4 5 6 6 	EXISTING AIR-HANDLING UNIT, SUPPLY, AND RETURN DUCTWORK TO BE REMOVED IN THEIR ENTIRETY, INCLUDING WOOD PLATFORM UNDERNEATH. EXISTING CONDENSATE PIPING AND PUMP TO BE REMOVED. EXISTING CONDENSING UNIT CONNECTED TO AHU TO BE REMOVED IN ITS ENTIRETY, INCLUDING CONNECTED REFRIGERANT PIPING AND DISCONNECT SWITCH. EXISTING EXHAUST GRILLE IN SOFFIT AND CONNECTED ATTIC FAN TO BE REMOVED IN THEIR ENTIRETY. REMOVE EXISTING WALL SWITCH CONTROLLING ATTIC FAN. EXISTING KITCHEN HARD CEILING TO BE REMOVED IN ITS ENTIRETY – REFER TO ARCHITECTURAL. ALL EXISTING SUPPLY AND RETURN DUCTWORK, DIFFUSERS AND GRILLES TO BE REMOVED IN ITS ENTIRETY, INCLUDING ANSUL FIRE SUPPRESSION SYSTEM AND HOOD CONTROLS. ALL EXISTING KITCHEN EXHAUST HOOD TO BE REMOVED IN ITS ENTIRETY, INCLUDING ANSUL FIRE SUPPRESSION SYSTEM AND HOOD CONTROLS. ALL EXISTING KITCHEN EQUIPMENT TO REMAIN. REFER TO AD101 FOR INSTRUCTIONS REGARDING KITCHEN EQUIPMENT REMOVAL DURING DEMOLITION. EXISTING HOOD EXHAUST FAN ON ROOF TO BE REMOVED. CAP EXISTING ROOF CURB. PAINT CAP TO MATCH EXISTING ROOF COLOR.	MPE PROJ#: 2013-079
 1 2 3 4 5 6 7 7 	 EXISTING AIR-HANDLING UNIT, SUPPLY, AND RETURN DUCTWORK TO BE REMOVED IN THEIR ENTIRETY, INCLUDING WOOD PLATFORM UNDERNEATH. EXISTING CONDENSATE PIPING AND PUMP TO BE REMOVED. EXISTING CONDENSING UNIT CONNECTED TO AHU TO BE REMOVED IN ITS ENTIRETY, INCLUDING CONNECTED REFRIGERANT PIPING AND DISCONNECT SWITCH. EXISTING EXHAUST GRILLE IN SOFFIT AND CONNECTED ATTIC FAN TO BE REMOVED IN THEIR ENTIRETY. REMOVE EXISTING WALL SWITCH CONTROLLING ATTIC FAN. EXISTING KITCHEN HARD CEILING TO BE REMOVED IN ITS ENTIRETY - REFER TO ARCHITECTURAL. ALL EXISTING SUPPLY AND RETURN DUCTWORK, DIFFUSERS AND GRILLES TO BE REMOVED IN ITS ENTIRETY, INCLUDING ANSUL FIRE SUPPRESSION SYSTEM AND HOOD CONTROLS. ALL EXISTING KITCHEN EQUIPMENT TO REMAIN. REFER TO AD101 FOR INSTRUCTIONS REGARDING KITCHEN EQUIPMENT REMOVAL DURING DEMOLITION. EXISTING HOOD EXHAUST FAN ON ROOF TO BE REMOVED. CAP EXISTING ROOF CURB. PAINT CAP TO MATCH EXISTING ROOF COLOR. 	
 1 2 3 4 5 6 6 	EXISTING AIR-HANDLING UNIT, SUPPLY, AND RETURN DUCTWORK TO BE REMOVED IN THEIR ENTIRETY, INCLUDING WOOD PLATFORM UNDERNEATH. EXISTING CONDENSATE PIPING AND PUMP TO BE REMOVED. EXISTING CONDENSING UNIT CONNECTED TO AHU TO BE REMOVED IN ITS ENTIRETY, INCLUDING CONNECTED TO AHU TO BE REMOVED IN ITS ENTIRETY, INCLUDING CONNECTED REFRIGERANT PIPING AND DISCONNECT SWITCH. EXISTING EXHAUST GRILLE IN SOFFIT AND CONNECTED ATTIC FAN TO BE REMOVED IN THEIR ENTIRETY. REMOVE EXISTING WALL SWITCH CONTROLLING ATTIC FAN. EXISTING KITCHEN HARD CEILING TO BE REMOVED IN ITS ENTIRETY - REFER TO ARCHITECTURAL. ALL EXISTING SUPPLY AND RETURN DUCTWORK, DIFFUSERS AND GRILLES TO BE REMOVED IN THEIR ENTIRETY. EXISTING KITCHEN EXHAUST HOOD TO BE REMOVED IN ITS ENTIRETY, INCLUDING ANSUL FIRE SUPPRESSION SYSTEM AND HOOD CONTROLS. ALL EXISTING KITCHEN EQUIPMENT TO REMAIN. REFER TO AD101 FOR INSTRUCTIONS REGARDING KITCHEN EQUIPMENT REMOVAL DURING DEMOLITION. EXISTING HOOD EXHAUST FAN ON ROOF TO BE REMOVED. CAP EXISTING ROOF CURB. PAINT CAP TO MATCH EXISTING ROOF COLOR.	MPE PROJ#: 2013-079 Designed By: BWP Drawn By: RN Checked By: BWP
 1 2 3 4 5 6 7 7 	EXISTING AIR-HANDLING UNIT, SUPPLY, AND RETURN DUCTWORK TO BE REMOVED IN THEIR ENTIRETY, INCLUDING WOOD PLATFORM UNDERNEATH. EXISTING CONDENSATE PIPING AND PUMP TO BE REMOVED. EXISTING CONDENSING UNIT CONNECTED TO AHU TO BE REMOVED IN ITS ENTIRETY, INCLUDING CONNECTED REFRIGERANT PIPING AND DISCONNECT SWITCH. EXISTING EXHAUST GRILLE IN SOFFIT AND CONNECTED ATTIC FAN TO BE REMOVED IN THEIR ENTIRETY. REMOVE EXISTING WALL SWITCH CONTROLLING ATTIC FAN. EXISTING KITCHEN HARD CEILING TO BE REMOVED IN ITS ENTIRETY – REFER TO ARCHITECTURAL. ALL EXISTING SUPPLY AND RETURN DUCTWORK, DIFFUSERS AND GRILLES TO BE REMOVED IN ITS ENTIRETY, INCLUDING ANSUL FIRE SUPPRESSION SYSTEM AND HOOD CONTROLS. ALL EXISTING KITCHEN EXHAUST HOOD TO BE REMOVED IN ITS ENTIRETY, INSTRUCTIONS REGARDING KITCHEN EQUIPMENT TO REMAIN. REFER TO AD101 FOR INSTRUCTIONS REGARDING KITCHEN EQUIPMENT REMOVAL DURING DEMOLITION. EXISTING HOOD EXHAUST FAN ON ROOF TO BE REMOVED. CAP EXISTING ROOF CURB. PAINT CAP TO MATCH EXISTING ROOF COLOR. EXISTING HOOD SUPPLY FAN ON ROOF TO BE REMOVED. CAP EXISTING ROOF CURB. PAINT CAP TO MATCH EXISTING ROOF COLOR. ALL EXISTING DIFFUSERS AND GRILLES WITHIN DINING ROOM TO BE REMOVED IN THEIR ENTIRETY. TYPICAL IN DINING ROOM TO BE REMOVED IN THEIR ENTIRETY. TYPICAL IN DINING ROOM. CAP EXISTING OPENINGS TO MATCH EXISTING CEILING FINISH AND COLOR. REFER TO	MPE PROJ#: 2013-079 Designed By:BWP Drawn By:RN Checked By:BWP Issue Date: 9/05/14
 1 2 3 4 5 6 7 8 6 	EXISTING AIR-HANDLING UNIT, SUPPLY, AND RETURN DUCTWORK TO BE REMOVED IN THEIR ENTIRETY, INCLUDING WOOD PLATFORM UNDERNEATH. EXISTING CONDENSATE PIPING AND PUMP TO BE REMOVED. EXISTING CONDENSING UNIT CONNECTED TO AHU TO BE REMOVED IN ITS ENTIRETY, INCLUDING CONNECTED REFRIGERANT PIPING AND DISCONNECT SWITCH. EXISTING EXHAUST GRILLE IN SOFFIT AND CONNECTED ATTIC FAN TO BE REMOVED IN THEIR ENTIRETY. REMOVE EXISTING WALL SWITCH CONTROLLING ATTIC FAN. EXISTING KITCHEN HARD CEILING TO BE REMOVED IN ITS ENTIRETY – REFER TO ARCHITECTURAL. ALL EXISTING SUPPLY AND RETURN DUCTWORK, DIFFUSERS AND GRILLES TO BE REMOVED IN ITS ENTIRETY, INCLUDING ANSUL FIRE SUPPRESSION SYSTEM AND HOOD CONTROLS. ALL EXISTING KITCHEN EXHAUST HOOD TO BE REMOVED IN ITS ENTIRETY, INSTRUCTIONS REGARDING KITCHEN EQUIPMENT TO REMAIN. REFER TO AD101 FOR INSTRUCTIONS REGARDING KITCHEN EQUIPMENT REMOVAL DURING DEMOLITION. EXISTING HOOD EXHAUST FAN ON ROOF TO BE REMOVED. CAP EXISTING ROOF CURB. PAINT CAP TO MATCH EXISTING ROOF COLOR. EXISTING HOOD SUPPLY FAN ON ROOF TO BE REMOVED. CAP EXISTING ROOF CURB. PAINT CAP TO MATCH EXISTING ROOF COLOR. ALL EXISTING DIFFUSERS AND GRILLES WITHIN DINING ROOM TO BE REMOVED IN THEIR ENTIRETY. TYPICAL IN DINING ROOM TO BE REMOVED IN THEIR ENTIRETY. TYPICAL IN DINING ROOM TO BE REMOVED IN THEIR ENTIRETY. TYPICAL IN DINING ROOM TO BE REMOVED IN THEIR ENTIRETY. TYPICAL IN DINING ROOM TO BE	MPE PROJ#: 2013-079 Designed By: BWP Drawn By: RN Checked By: BWP Issue Date: 9/05/14 Drawing Scale: 1/4"=1'-0"
 1 2 3 4 5 6 7 8 9 10 	EXISTING AIR-HANDLING UNIT, SUPPLY, AND RETURN DUCTWORK TO BE REMOVED IN THEIR ENTIRETY, INCLUDING WOOD PLATFORM UNDERNEATH. EXISTING CONDENSATE PIPING AND PUMP TO BE REMOVED. EXISTING CONDENSING UNIT CONNECTED TO AHU TO BE REMOVED IN ITS ENTIRETY, INCLUDING CONNECTED REFRIGERANT PIPING AND DISCONNECT SWITCH. EXISTING EXHAUST GRILLE IN SOFFIT AND CONNECTED ATTIC FAN TO BE REMOVED IN THEIR ENTIRETY. REMOVE EXISTING WALL SWITCH CONTROLLING ATTIC FAN. EXISTING KITCHEN HARD CEILING TO BE REMOVED IN ITS ENTIRETY - REFER TO ARCHITECTURAL. ALL EXISTING SUPPLY AND RETURN DUCTWORK, DIFFUSERS AND GRILLES TO BE REMOVED IN ITS ENTIRETY - REFER TO ARCHITECTURAL. ALL EXISTING SUPPLY AND RETURN DUCTWORK, DIFFUSERS AND GRILLES TO BE REMOVED IN ITS ENTIRETY, INCLUDING ANSUL FIRE SUPPRESSION SYSTEM AND HOOD CONTROLS. ALL EXISTING KITCHEN EQUIPMENT TO REMAIN. REFER TO ADIO1 FOR INSTRUCTIONS REGARDING KITCHEN EQUIPMENT REMOVAL DURING DEMOLITION. EXISTING HOOD EXHAUST FAN ON ROOF TO BE REMOVED. CAP EXISTING HOOD EXHAUST FAN ON ROOF TO BE REMOVED. CAP EXISTING ROOF CURB. PAINT CAP TO MATCH EXISTING ROOF COLOR. ALL EXISTING DIFFUSERS AND GRILLES WITHIN DINING ROOM TO BE REMOVED IN THEIR ENTIRETY. TYPICAL IN DINING ROOM TO BE REMOVED IN THEIR ENTIRETY. TYPICAL IN DINING ROOM. CAP EXISTING OPENINGS TO MATCH EXISTING CEILING TO REMAIN IN-TACT. EXISTING CEILING CABINET FAN ABOVE CEILING TO REMAIN.	MPE PROJ#: 2013-079 Designed By: BWP Drawn By: RN Checked By: BWP Issue Date: 9/05/14 Drawing Scale: 1/4"=1'-0" Drawing Title:
 1 2 3 4 5 6 7 8 9 10 11 	EXISTING AIR-HANDLING UNIT, SUPPLY, AND RETURN DUCTWORK TO BE REMOVED IN THEIR ENTIRETY, INCLUDING WOOD PLATFORM UNDERNEATH. EXISTING CONDENSATE PIPING AND PUMP TO BE REMOVED. EXISTING CONDENSING UNIT CONNECTED TO AHU TO BE REMOVED IN ITS ENTIRETY, INCLUDING CONNECTED REFRIGERANT PIPING AND DISCONNECT SWITCH. EXISTING EXHAUST GRILLE IN SOFFIT AND CONNECTED ATTIC FAN TO BE REMOVED IN THEIR ENTIRETY. REMOVE EXISTING WALL SWITCH CONTROLLING ATTIC FAN. EXISTING KITCHEN HARD CEILING TO BE REMOVED IN ITS ENTIRETY - REFER TO ARCHITECTURAL. ALL EXISTING SUPPLY AND RETURN DUCTWORK, DIFFUSERS AND GRILLES TO BE REMOVED IN ITS ENTIRETY, INCLUDING ANSUL FIRE SUPPRESSION SYSTEM AND HOOD CONTROLS. ALL EXISTING KITCHEN EQUIPMENT TO REMAIN. REFER TO AD101 FOR INSTRUCTIONS REGARDING KITCHEN EQUIPMENT REMOVAL DURING DEMOLITION. EXISTING HOOD EXHAUST FAN ON ROOF TO BE REMOVED. CAP EXISTING ROOF CURB. PAINT CAP TO MATCH EXISTING ROOF COLOR. EXISTING ROOF CURB. PAINT CAP TO MATCH EXISTING ROOF COLOR. ALL EXISTING DIFFUSERS AND GRILLES WITHIN DINING ROOM TO BE REMOVED IN THEIR ENTIRETY. TYPICAL IN DINING ROOM TO BE REMOVED IN THEIR ENTIRETY. TYPICAL IN DINING ROOM TO BE REMOVED IN THEIR ENTIRETY. TYPICAL IN DINING ROOM TO BE REMOVED IN THEIR ENTIRETY. TYPICAL IN DINING ROOM TO BE REMOVED IN THEIR ENTIRETY. TYPICAL IN DINING ROOM TO BE REMOVED IN THEIR ENTIRETY. TYPICAL IN DINING ROOM TO BE REMOVED IN THEIR ENTIRETY. TYPICAL IN DINING ROOM TO BE REMOVED IN THEIR ENTIRETY. TYPICAL IN DINING ROOM. CAP EXISTING OPENINGS TO MATCH EXISTING CEILING FINISH AND COLOR. REFER TO ARCHITECTURAL. EXISTING CEILING TO REMAIN IN-TACT. EXISTING CEILING CABINET FAN ABOVE CEILING TO REMAIN. EXISTING RELIEF FAN ABOVE CEILING TO BE REMOVED. CAP & SEAL EXISTING RELIEF FAN ABOVE CEILING TO BE REMOVED. CAP & SEAL EXISTING OPENING WITHIN THE INSIDE OF THE STRUCTURE. PAINT TO	MPE PROJ#: 2013-079 Designed By: BWP Drawn By: RN Checked By: BWP Issue Date: 9/05/14 Drawing Scale: 1/4"=1'-0" Drawing Title: FLOOR PLAN
 1 2 3 4 5 6 7 8 9 1 12 	EXISTING AIR-HANDLING UNIT, SUPPLY, AND RETURN DUCTWORK TO BE REMOVED IN THEIR ENTIRETY, INCLUDING WOOD PLATFORM UNDERNEATH. EXISTING CONDENSATE PIPING AND PUMP TO BE REMOVED. EXISTING CONDENSING UNIT CONNECTED TO AHU TO BE REMOVED IN ITS ENTIRETY, INCLUDING CONNECTED REFRIGERANT PIPING AND DISCONNECT SWITCH. EXISTING EXHAUST GRILLE IN SOFFIT AND CONNECTED ATTIC FAN TO BE REMOVED IN THEIR ENTIRETY. REMOVE EXISTING WALL SWITCH CONTROLLING ATTIC FAN. EXISTING KITCHEN HARD CEILING TO BE REMOVED IN ITS ENTIRETY - REFER TO ARCHITECTURAL ALL EXISTING SUPPLY AND RETURN DUCTWORK, DIFFUSERS AND GRILLES TO BE REMOVED IN THEIR ENTIRETY. EXISTING KITCHEN EXHAUST HOOD TO BE REMOVED IN ITS ENTIRETY, INCLUDING ANSUL FIRE SUPPRESSION SYSTEM AND HOOD CONTROLS. ALL EXISTING KITCHEN EQUIPMENT TO REMAIN. REFER TO AD101 FOR INSTRUCTIONS REGARDING KITCHEN EQUIPMENT REMOVAL DURING DEMOLITON. EXISTING HOOD EXHAUST FAN ON ROOF TO BE REMOVED. CAP EXISTING ROOF CURB. PAINT CAP TO MATCH EXISTING ROOF COLOR. EXISTING HOOD SUPPLY FAN ON ROOF TO BE REMOVED. CAP EXISTING ROOF CURB. PAINT CAP TO MATCH EXISTING ROOF COLOR. ALL EXISTING DIFFUSERS AND GRILLES WITHIN DINING ROOM TO BE REMOVED IN THEIR ENTIRETY. TYPICAL IN DINING ROOM TO BE REMOVED IN THEIR ENTIRETY. TYPICAL IN DINING ROOM TO BE REMOVED IN THEIR ENTIRETY. TYPICAL IN DINING ROOM TO BE REMOVED IN THEIR ENTIRETY. TYPICAL IN DINING ROOM. CAP EXISTING OPENINGS TO MATCH EXISTING CEILING FINISH AND COLOR. REFER TO ARCHITECTURAL. EXISTING CEILING TO REMAIN IN-TACT. EXISTING CIELING CABINET FAN ABOVE CEILING TO REMAIN. EXISTING RELIEF FAN ABOVE CEILING TO REMAIN IN-TACT. EXISTING RELIEF FAN ABOVE CEILING TO BE REMOVED. CAP & SEAL EXISTING OPENING WITHIN THE INSIDE OF THE STRUCTURE. PAINT TO MATCH EXISTING SURROUNDINGS. EXISTING ICE MACHINE CONDENSING UNIT TO REMAIN. EXISTING ICE MACHINE CONDENSING UNIT TO REMAIN. EXISTING ICE MACHINE CONDENSING UNIT TO REMAIN.	MPE PROJ#: 2013-079 Designed By: BWP Drawn By: RN Checked By: BWP Issue Date: 9/05/14 Drawing Scale: 1/4"=1'-0" Drawing Title:
 1 2 3 4 5 6 7 8 9 10 11 	EXISTING AIR-HANDLING UNIT, SUPPLY, AND RETURN DUCTWORK TO BE REMOVED IN THEIR ENTIRETY, INCLUDING WOOD PLATFORM UNDERNEATH. EXISTING CONDENSATE PIPING AND PUMP TO BE REMOVED. EXISTING CONDENSING UNIT CONNECTED TO AHU TO BE REMOVED IN ITS ENTIRETY, INCLUDING CONNECTED TO AHU TO BE REMOVED IN ITS ENTIRETY, INCLUDING CONNECTED REFRIGERANT PIPING AND DISCONNECT SWITCH. EXISTING EXHAUST GRILLE IN SOFFIT AND CONNECTED ATTIC FAN TO BE REMOVED IN THEIR ENTIRETY. REMOVE EXISTING WALL SWITCH CONTROLLING ATTIC FAN. EXISTING KITCHEN HARD CEILING TO BE REMOVED IN ITS ENTIRETY - REFER TO ARCHITECTURAL. ALL EXISTING SUPPLY AND RETURN DUCTWORK, DIFFUSERS AND GRILLES TO BE REMOVED IN THEIR ENTIRETY. EXISTING KITCHEN EXHAUST HOOD TO BE REMOVED IN ITS ENTIRETY, INCLUDING ANSUL FIRE SUPPRESSION SYSTEM AND HOOD CONTROLS. ALL EXISTING KITCHEN EQUIPMENT TO REMAIN. REFER TO AD101 FOR INSTRUCTIONS REGARDING KITCHEN EQUIPMENT REMOVAL DURING DEMOLITION. EXISTING HOOD EXHAUST FAN ON ROOF TO BE REMOVED. CAP EXISTING HOOD SUPPLY FAN ON ROOF TO BE REMOVED. CAP EXISTING GOF CURB. PAINT CAP TO MATCH EXISTING ROOF COLOR. ALL EXISTING DIFFUSERS AND GRILLES WITHIN DINING ROOM TO BE REMOVED IN THEIR ENTIRETY. TYPICAL IN DINING ROOM TO BE REMOVED IN THEIR ENTIRETY. TYPICAL IN DINING ROOM TO BE REMOVED IN THEIR ENTIRETY. TYPICAL IN DINING ROOM TO BE REMOVED IN THEIR ENTIRETY. TYPICAL IN DINING ROOM TO BE REMOVED IN THEIR ENTIRETY. TYPICAL IN DINING ROOM. CAP EXISTING OPENINGS TO MATCH EXISTING CEILING TO REMAIN IN-TACT. EXISTING CELING CABINET FAN ABOVE CEILING TO REMAIN.	MPE PROJ#: 2013-079 Designed By: BWP Drawn By: RN Checked By: BWP Issue Date: 9/05/14 Drawing Scale: 1/4"=1'-0" Drawing Title: FLOOR PLAN DEMOLITION
 1 2 3 4 5 6 7 8 9 1 12 	EXISTING AIR-HANDLING UNIT, SUPPLY, AND RETURN DUCTWORK TO BE REMOVED IN THEIR ENTIRETY, INCLUDING WOOD PLATFORM UNDERNEATH. EXISTING CONDENSATE PIPING AND PUMP TO BE REMOVED. EXISTING CONDENSING UNIT CONNECTED TO AHU TO BE REMOVED IN ITS ENTIRETY, INCLUDING CONNECTED REFRIGERANT PIPING AND DISCONNECT SWITCH. EXISTING EXHAUST GRILLE IN SOFFIT AND CONNECTED ATTIC FAN TO BE REMOVED IN THEIR ENTIRETY. REMOVE EXISTING WALL SWITCH CONTROLLING ATTIC FAN. EXISTING KITCHEN HARD CEILING TO BE REMOVED IN ITS ENTIRETY - REFER TO ARCHITECTURAL. ALL EXISTING SUPPLY AND RETURN DUCTWORK, DIFFUSERS AND GRILLES TO BE REMOVED IN THEIR ENTIRETY. EXISTING KITCHEN EXHAUST HOOD TO BE REMOVED IN ITS ENTIRETY, INCLUDING ANSUL FIRE SUPPRESSION SYSTEM AND HOOD CONTROLS. ALL EXISTING KITCHEN EQUIPMENT TO REMAIN. REFER TO AD101 FOR INSTRUCTIONS REGARDING KITCHEN EQUIPMENT REMOVAL DURING DEMOLITION. EXISTING HOOD EXHAUST FAN ON ROOF TO BE REMOVED. CAP EXISTING HOOD SUPPLY FAN ON ROOF TO BE REMOVED. CAP EXISTING GOF CURB. PAINT CAP TO MATCH EXISTING ROOF COLOR. ALL EXISTING DIFFUSERS AND GRILLES WITHIN DINING ROOM TO BE REMOVED IN THEIR ENTIRETY. TYPICAL IN DINING ROOM TO BE REMOVED IN THEIR ENTIRETY. TYPICAL IN DINING ROOF COLOR. ALL EXISTING DIFFUSERS AND GRILLES WITHIN DINING ROOM TO BE EXISTING HOOD SUPPLY FAN ON ROOF TO BE REMOVED. CAP EXISTING DOF CURB. PAINT CAP TO MATCH EXISTING ROOF COLOR. ALL EXISTING DIFFUSERS AND GRILLES WITHIN DINING ROOM TO BE REMOVED IN THEIR ENTIRETY. TYPICAL IN DINING ROOM TO BE REMOVED IN THEIR ENTIRETY. TYPICAL IN DINING ROOM TO BE EXISTING CELLING CABINET FAN ABOVE CEILING TO REMAIN IN-TACT. EXISTING CEILING CABINET FAN ABOVE CEILING TO REMAIN IN-TACT. EXISTING CEILING CABINET FAN ABOVE CEILING TO BE REMOVED. CAP & SEAL EXISTING OPENING WITHIN THE INSIDE OF THE STRUCTURE. PAINT TO MATCH EXISTING SURROUNDINGS. EXISTING ICE MACHINE CONDENSING UNIT TO REMAIN. EXISTING ICE MACHINE CONDENSING UNIT TO REMAIN. EXISTING ICE MACHINE CONDENSING UNIT TO REMAIN. EXISTING ICE MACHINE CONDENSING UNIT TO REMAIN. EXISTI	MPE PROJ#: 2013-079 Designed By: BWP Drawn By: RN Checked By: BWP Issue Date: 9/05/14 Drawing Scale: 1/4"=1'-0" Drawing Title: FLOOR PLAN DEMOLITION
 1 2 3 4 5 6 7 8 9 10 12 13 	EXISTING AIR-HANDLING UNIT, SUPPLY, AND RETURN DUCTWORK TO BE REMOVED IN THEIR ENTIRETY, INCLUDING WOOD PLATFORM UNDERNEATH. EXISTING CONDENSATE PIPING AND PUMP TO BE REMOVED. EXISTING CONDENSING UNIT CONNECTED TO AHU TO BE REMOVED IN ITS ENTIRETY, INCLUDING CONNECTED REFRIGERANT PIPING AND DISCONNECT SWITCH. EXISTING EXHAUST GRILLE IN SOFFIT AND CONNECTED ATTIC FAN TO BE REMOVED IN THEIR ENTIRETY. REMOVE EXISTING WALL SWITCH CONTROLLING ATTIC FAN. EXISTING KITCHEN HARD CEILING TO BE REMOVED IN ITS ENTIRETY - REFER TO ARCHITECTURAL. ALL EXISTING SUPPLY AND RETURN DUCTWORK, DIFFUSERS AND GRILLES TO BE REMOVED IN THEIR ENTIRETY. EXISTING KITCHEN EXHAUST HOOD TO BE REMOVED IN ITS ENTIRETY, INCLUDING ANSUL FIRE SUPPRESSION SYSTEM AND HOOD CONTROLS. ALL EXISTING KITCHEN EQUIPMENT TO REMAIN. REFER TO ADIO1 FOR INSTRUCTIONS REGARDING KITCHEN EQUIPMENT REMOVAL DURING DEMOLITION. EXISTING HOOD EXHAUST FAN ON ROOF TO BE REMOVED. CAP EXISTING ROOF CURB. PAINT CAP TO MATCH EXISTING ROOF COLOR. EXISTING ROOF CURB. PAINT CAP TO MATCH EXISTING ROOF COLOR. ALL EXISTING GOIF FUSERS AND GRILLES WITHIN DINING ROOM TO BE REMOVED IN THEIR ENTIRETY. TYPICAL IN DINING ROOM TO BE REMOVED IN THEIR ENTIRETY. TYPICAL IN DINING ROOM TO BE REMOVED IN THEIR ENTIRETY. TYPICAL IN DINING ROOM TO BE REMOVED IN THEIR ENTIRETY. TYPICAL IN DINING ROOM TO BE REMOVED IN THEIR ENTIRETY. TYPICAL IN DINING ROOM TO BE REMOVED IN THEIR ENTIRETY. TYPICAL IN DINING ROOM TO BE REMOVED IN THEIR ENTIRETY. TYPICAL IN DINING ROOM TO BE REMOVED IN THEIR ENTIRETY. TYPICAL IN DINING ROOM TO BE REMOVED IN THEIR ENTIRETY. TYPICAL IN DINING ROOM TO BE REMOVED IN THEIR ENTIRETY. TYPICAL IN DINING ROOM TO BE REMOVED IN THEIR ENTIRETY. TYPICAL IN DINING ROOM TO BE REMOVED IN THEIR ENTIRETY. TYPICAL IN DINING ROOM TO BE REMOVED IN THEIR ENTIRETY. TYPICAL IN DINING ROOM TO BE REMOVED IN THEIR ENTIRETY. TYPICAL IN DINING ROOM TO BE REMOVED IN THEIR ENTIRETY. TYPICAL IN DINING ROOM CAP EXISTING OPENING STO MATCH EXISTING CEILING TO REMAIN. EXISTING CEILING TO BE REMOVED. RE	MPE PROJ#: 2013-079 Designed By: BWP Drawn By: RN Checked By: BWP Issue Date: 9/05/14 Drawing Scale: 1/4"=1'-0" Drawing Title: FLOOR PLAN DEMOLITION MECHANICAL 100 % CONSTRUCTION DOCUMENTS
 1 2 3 4 5 6 7 8 9 10 12 13 14 	EXISTING AIR-HANDLING UNIT, SUPPLY, AND RETURN DUCTWORK TO BE REMOVED IN THEIR ENTIRETY, INCLUDING WOOD PLATFORM UNDERNEATH. EXISTING CONDENSATE PIPING AND PUMP TO BE REMOVED. EXISTING CONDENSING UNIT CONNECTED TO AHU TO BE REMOVED IN TIS ENTIRETY, INCLUDING CONNECTED REFRIGERANT PIPING AND DISCONNECT SWITCH. EXISTING EXHAUST GRILLE IN SOFFIT AND CONNECTED ATTIC FAN TO BE REMOVED IN THEIR ENTIRETY. REMOVE EXISTING WALL SWITCH CONTROLLING ATTIC FAN. EXISTING KITCHEN HARD CEILING TO BE REMOVED IN ITS ENTIRETY - REFER TO ARCHITECTURAL. ALL EXISTING SUPPLY AND RETURN DUCTWORK, DIFFUSERS AND GRILLES TO BE REMOVED IN ITS ENTIRETY, INCLUDING ANSUL FIRE SUPPRESSION SYSTEM AND HOOD CONTROLS. ALL EXISTING KITCHEN EXHAUST HOOD TO BE REMOVED IN ITS ENTIRETY, INCLUDING ANSUL FIRE SUPPRESSION SYSTEM AND HOOD CONTROLS. ALL EXISTING KITCHEN EQUIPMENT TO REMAIN. REFER TO AD101 FOR INSTRUCTORS REGARDING KITCHEN EQUIPMENT REMOVAL DURING DEMOLITION. EXISTING HOOD EXHAUST FAN ON ROOF TO BE REMOVED. CAP EXISTING ROOF CURB. PAINT CAP TO MATCH EXISTING ROOF COLOR. ALL EXISTING GOT CURB. PAINT CAP TO MATCH EXISTING ROOF COLOR. ALL EXISTING GOT CURB. PAINT CAP TO MATCH EXISTING ROOF COLOR. ALL EXISTING GOT CURB. PAINT CAP TO MATCH EXISTING ROOF COLOR. ALL EXISTING GOT CURB. PAINT CAP TO MATCH EXISTING ROOF COLOR. ALL EXISTING GOT FUSERS AND GRILLES WITHIN DINING ROOM TO BE REMOVED IN THEIR ENTIRETY. TYPICAL IN DINING ROOM TO BE REMOVED IN THEIR ENTIRETY. TYPICAL IN DINING ROOM COLOR. REFER TO ARCHITECTURAL. EXISTING CEILING TO REMAIN IN-TACT. EXISTING CEILING CABINET FAN ABOVE CEILING TO REMAIN. EXISTING CEILING CABINET FAN ABOVE CEILING TO REMAIN. EXISTING SURGUNDINGS. EXISTING PIAL CADISING UNIT TO REMAIN. EXISTING SURGUNDINGS. EXISTING FLAE FAD ABOVE CEILING TO REMAIN. EXISTING SURGUNDINGS. EXISTING FLAE POLE TO BE REMOVED. REUSE OPENING FOR NEW INTAKE LOUVER. REFER TO RENO SHEET. EXISTING FLAG POLE TO BE RELOCATED FOR NEW PACKAGED UNIT. REFER TO ARCHITECTURAL DRAWINGS. REMOVE SHELVING AS REQUIRED FOR NEW DUCTWORK. REFER TO RENOVATIO	MPE PROJ#: 2013-079 Designed By: BWP Drawn By: RN Checked By: BWP Issue Date: 9/05/14 Drawing Scale: 1/4"=1'-0" Drawing Title: FLOOR PLAN DEMOLITION MECHANICAL
 1 2 3 4 5 6 7 8 9 1 1	EXISTING AIR-HANDLING UNIT, SUPPLY, AND RETURN DUCTWORK TO BE REMOVED IN THEIR ENTIRETY, INCLUDING WOOD PLATFORM UNDERNEATH. EXISTING CONDENSATE PIPING AND PUMP TO BE REMOVED. EXISTING CONDENSING UNIT CONNECTED TO AHU TO BE REMOVED IN TIS ENTIRETY, INCLUDING CONNECTED REFRIGERANT PIPING AND DISCONNECT SWITCH. EXISTING EXHAUST CRILLE IN SOFFIT AND CONNECTED ATTIC FAN TO BE REMOVED IN THEIR ENTIRETY. REMOVE EXISTING WALL SWITCH CONTROLLING ATTIC FAN. EXISTING KITCHEN HARD CEILING TO BE REMOVED IN ITS ENTIRETY – REFER TO ARCHITECTURAL. ALL EXISTING SUPPLY AND RETURN DUCTWORK, DIFFUSERS AND GRILLES TO BE REMOVED IN ITS ENTIRETY, INCLUDING ANSUL FIRE SUPPRESSION SYSTEM AND HOOD CONTROLS. ALL EXISTING KITCHEN EXHAUST HOOD TO BE REMOVED IN ITS ENTIRETY, INCLUDING ANSUL FIRE SUPPRESSION SYSTEM AND HOOD CONTROLS. ALL EXISTING KITCHEN EQUIPMENT TO REMAIN. REFER TO ADIOI FOR INSTRUCTIONS REGARDING KITCHEN EQUIPMENT REMOVAL DURING DEMOLITION. EXISTING HOOD EXHAUST FAN ON ROOF TO BE REMOVED. CAP EXISTING ROOF CURB. PAINT CAP TO MATCH EXISTING ROOF COLOR. EXISTING ROOF CURB. PAINT CAP TO MATCH EXISTING ROOF COLOR. EXISTING ROOF CURB. PAINT CAP TO MATCH EXISTING ROOF COLOR. ALL EXISTING DIFFUSERS AND GRILLES WITHIN DINING ROOM TO BE REMOVED IN THEFUSERS AND GRILLES WITHIN DINING ROOM TO BE REMOVED IN THEFUSERS AND GRILLES WITHIN DINING ROOM TO BE REMOVED IN THEFUSERS AND GRILLES WITHIN DINING ROOM TO BE REMOVED IN THEFUSERS AND GRILLES WITHIN DINING ROOM. CAP EXISTING OPENINGS TO MATCH EXISTING CEILING TO REMAIN IN-TACT. EXISTING CEILING CABINET FAN ABOVE CEILING TO REMAIN. EXISTING CEILING CABINET FAN ABOVE CEILING TO REMAIN. EXISTING CEILING CABINET FAN ABOVE CEILING TO REMAIN. EXISTING SURROUNDINGS. EXISTING FILE FAIN ABOVE CEILING TO REMAIN. EXISTING SURROUNDINGS. EXISTING FILE FAIN ABOVE CEILING TO REMAIN. EXISTING FILE OLDE RELOCATED FOR NEW PACKAGED UNIT. REMOVE SHELVING AS REQUIRED FOR NE	MPE PROJ#: 2013-079 Designed By: BWP Drawn By: RN Checked By: BWP Issue Date: 9/05/14 Drawing Scale: 1/4"=1'-0" Drawing Title: FLOOR PLAN DEMOLITION MECHANICAL 100 % CONSTRUCTION DOCUMENTS

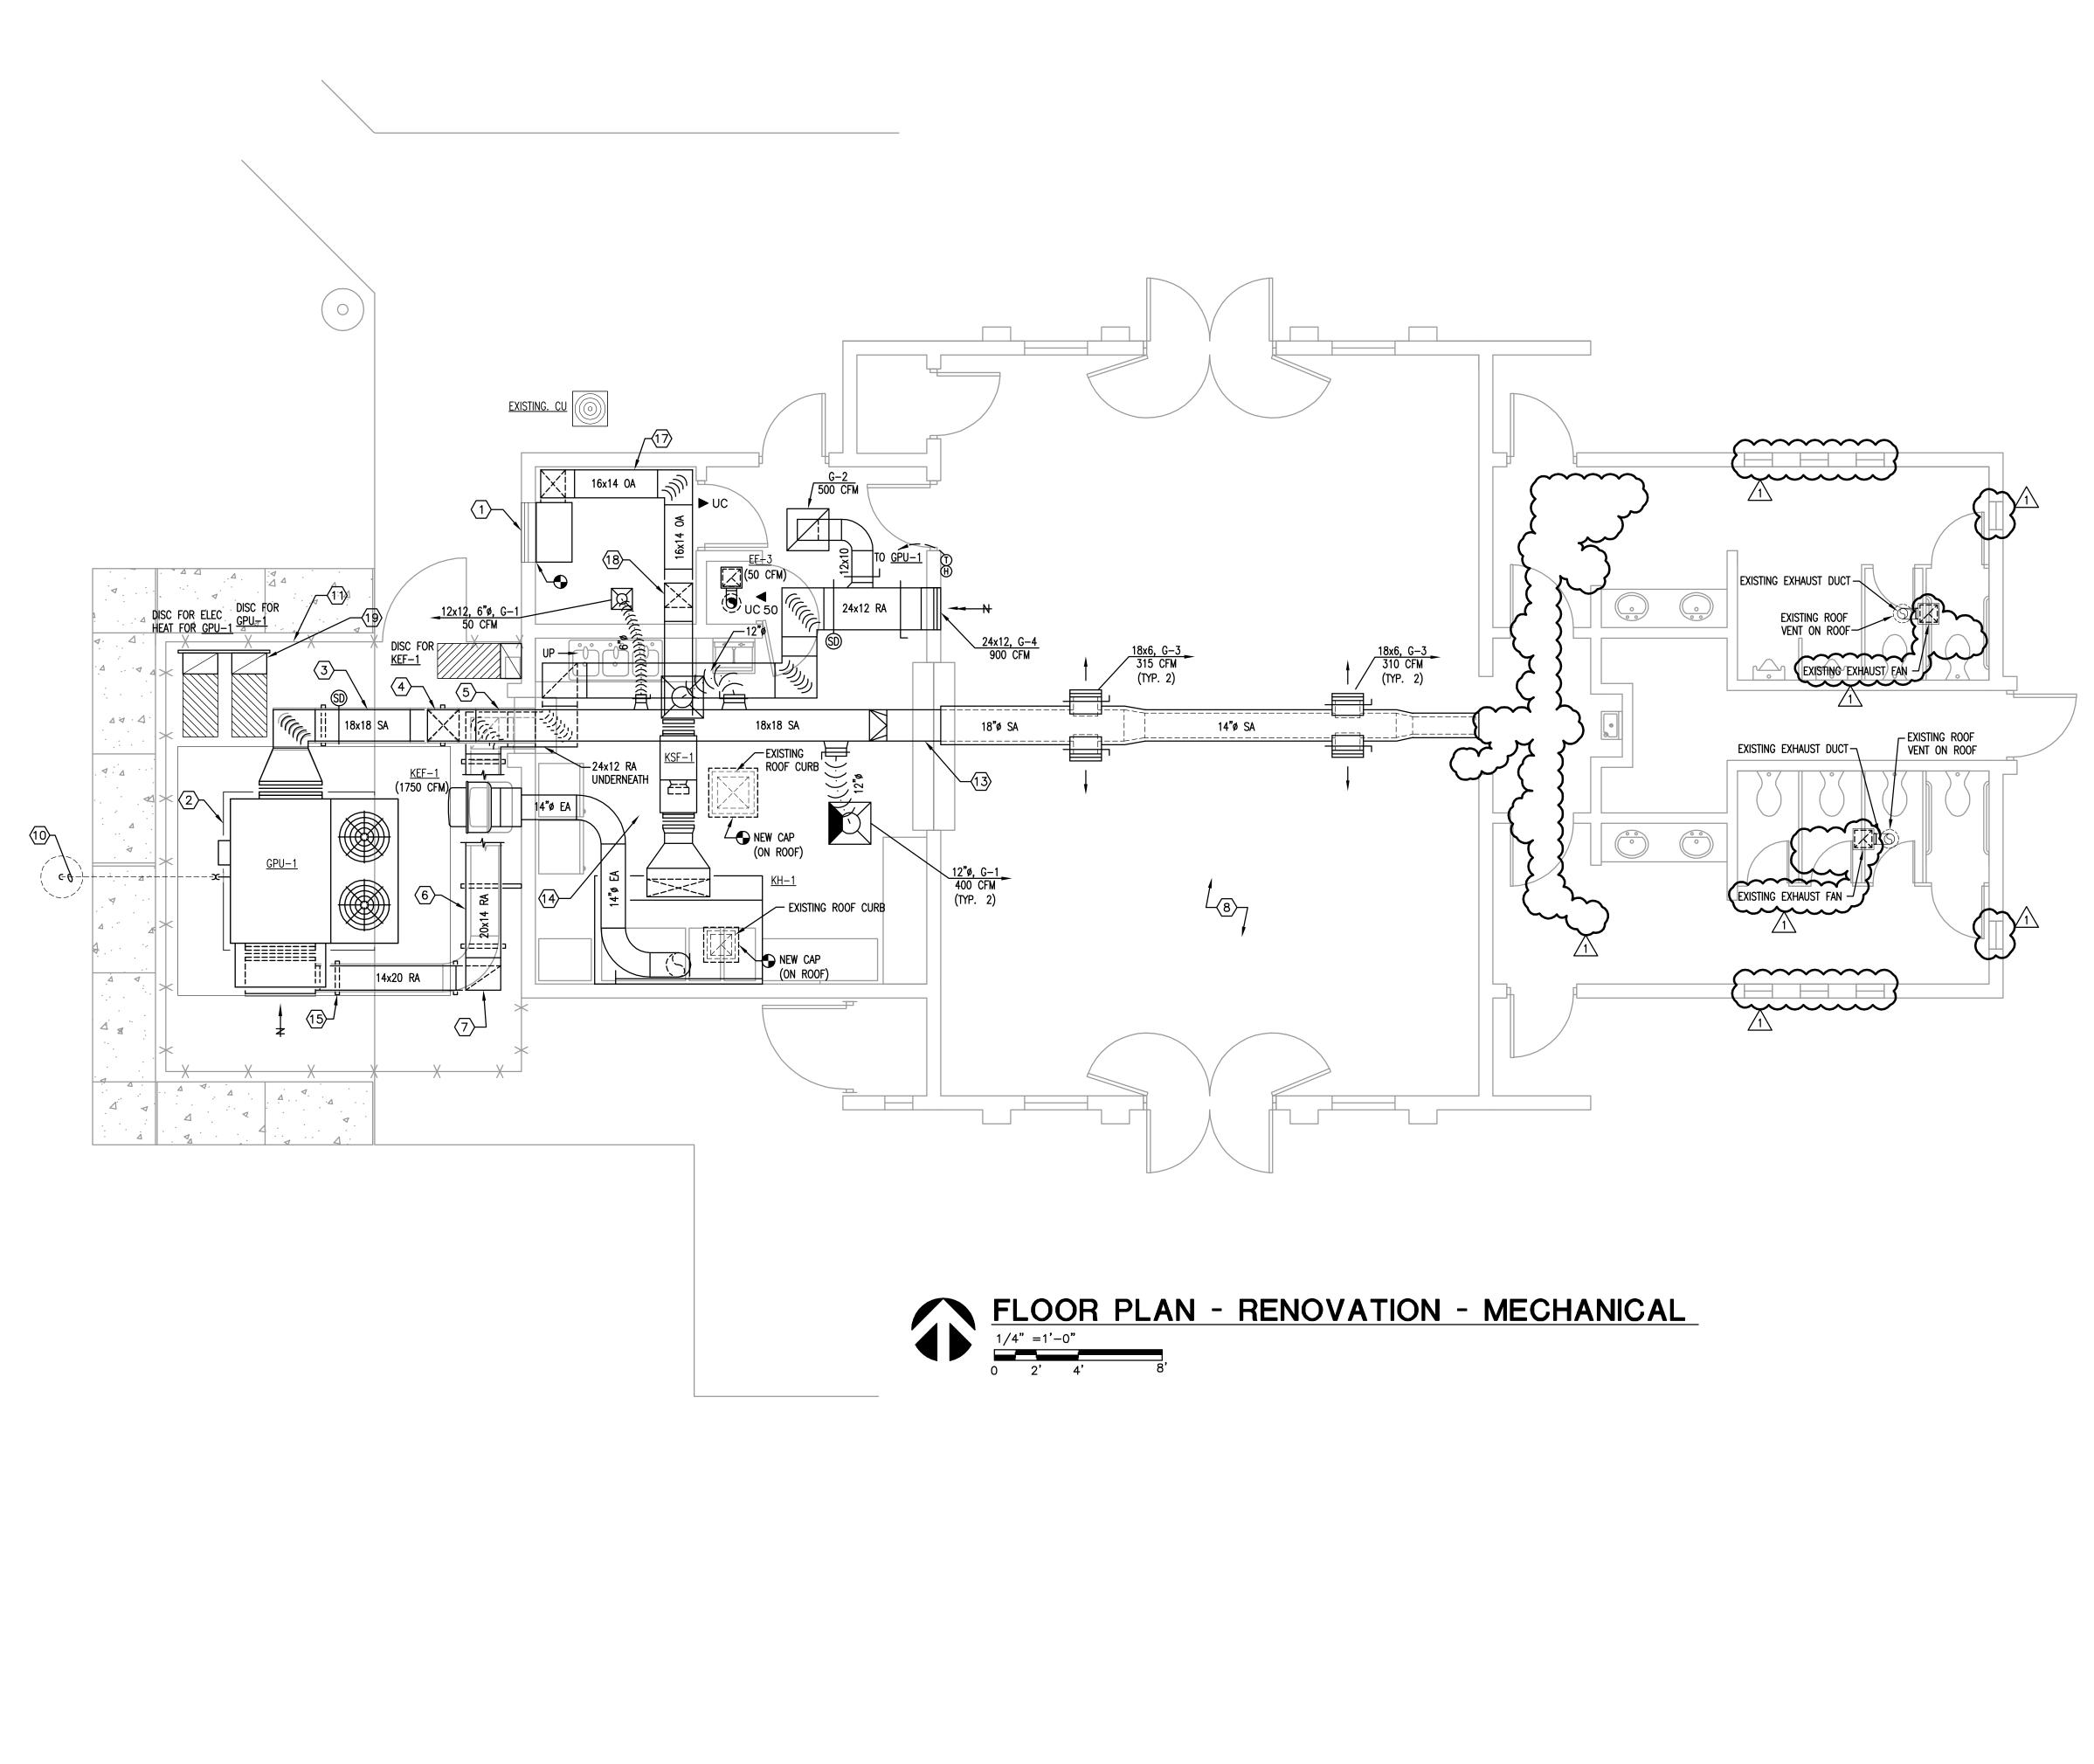



GENE	RAL NOTES			MATERN
1.	REFER TO GENERAL NOTES FOR THIS DISCIPLINE.			PROFESSIONAL
2.	REFER TO SPECIFICATIONS.			MEP/FP Engineering
3. 4.	ALL HEX NOTES NOT NECESSARILY USED ON ALL SHEETS. ALL AIR HANDLING SYSTEMS WILL UTILIZE A FULLY DUCTED RETURN			Consultants - A Solutions Based Firm
5.	AIR SYSTEM. PROVIDE A VOLUME DAMPER ON ALL BRANCH DUCTWORK AND ANY RUNOUT TO A DIFFUSER, WHETHER SHOWN OR NOT ON THE		-	rers I Jacksonville I Tampa nal Engineering, Inc
6.	ALL OUTSIDE AIR LOUVERS SHALL BE PROVIDED WITH 3/4" X 3/4" REMOVABLE BIRD SCREEN AND REMOVABLE FILTERS IN A FILTER RACK.	130 C Maitla	andace Driv nd, Fl 3275 E (407) 740-5020	/e 1-3331
_	THIS SHALL BE INSTALLED IN A CHANNEL AND SHALL BE EASILY REMOVED. SCREWED BIRD SCREEN TO THE LOUVER IS NOT ACCEPTABLE.	THIS DI ENGINE CONTR TRANSI BY THE	RAWING IS THE PROF ERING, INC. UNLES ACT, THE CONTENTS MITTED TO ANY OTHE ENGINEER.	ERTY OF MATERN PROFESSIONAL S OTHERWISE PROVIDED BY THE OF THIS DRAWING SHALL NOT BE R PARTY EXCEPT AS AGREED TO
7.	ALL LOUVER PLENUMS SHALL SLOPE BACK TOWARDS THE LOUVER ON THE EXTERIOR WALL. FINAL SIZE, HEIGHT, COLOR AND LOCATION OF THE LOUVERS SHOULD BE COORDINATED WITH THE ARCHITECTURAL ELEVATIONS AND GENERAL CONTRACTOR, PRIOR TO ORDERING TO LOUVERS.	0		ARCONA
8.	FULLY COORDINATE WITH THE ARCHITECTURAL REFLECTED CEILING PLANS FOR DIFFUSER LOCATIONS PRIOR TO INSTALLATION.			EMANS ARK
9.	2-HOUR DUCT WRAP FIRE ENCLOSURE IS REQUIRED FOR ALL GREASE DUCT EXHAUST.			
10.	ALL METAL DUCTWORK USED FOR THE CONVEYANCE OF GREASE-LADEN AIR SHALL BE CONSTRUCTED OF MINIMUM 18 GAUGE STAINLESS STEEL OR 16 GAUGE GALVANIZED STEEL.			OOMS & SSIONS
11.	ALL GREASE EXHAUST DUCTWORK JOINTS SHALL BE EITHER TELESCOPING OR BELL TYPE. BUTT-WELDED JOINTS ARE PROHIBITED.			HVAC
12.	ALL GREASE EXHAUST DUCTWORK SEAMS AND JOINTS SHALL BE CONTINUOUSLY WELDED WATER-TIGHT ON THE EXTERNAL SURFACE OF THE DUCT SYSTEM. ALL WELDING SHALL BE PERFORMED BY A CERTIFIED WELDER.	R	EPLA	CEMENT
13.	ALL GREASE EXHAUST DUCTWORK SHALL BE EXTERNALLY INSULATED WITH A UL 2221 LISTED AND LABELED GREASE DUCT ENCLOSURE SYSTEM. INSULATION SHALL BE INSTALLED IN ACCORDANCE WITH ITS LISTING AND THE MANUFACTURER'S INSTALLATION INSTRUCTIONS. REFER TO SPECIFICATION SECTION 23 07 00.			
14.	ACCESS PANELS SHALL BE PROVIDED AT ALL CHANGES IN DIRECTION OF THE GREASE EXHAUST DUCTWORK SYSTEM. ACCESS PANELS SHALL BE INSTALLED IN ACCORDANCE WITH THE INSULATION MANUFACTURER'S INSTALLATION INSTRUCTIONS AND SHALL BE LABELED AS FOLLOWS: "ACCESS PANEL – DO NOT OBSTRUCT".			
15.	ALL HORIZONTAL GREASE EXHAUST DUCTWORK SHALL BE INSTALLED WITH A MINIMUM 1/4" PER FOOT SLOPE AND SHALL BE PITCHED BACK TOWARD THE HOOD.			
16.	ALL GREASE DUCT SUPPORTS SHALL BE NONCOMBUSTIBLE MATERIAL.			
17.	REFER TO THE MANUFACTURERS RECOMMENDATIONS FOR ALL DEVICES SHOWN AND INSTALLED ON THIS PROJECT. THIS INCLUDES, BUT NOT	Rev	visions	
	LIMITED TO THE AIR FLOW MEASURING STATIONS, ELECTRIC DUCT HEATERS, MOTORIZED DAMPERS, SMOKE DETECTORS, AND DUCT ACCESSORIES.	No.	Date	Description
18.	FULLY COORDINATE ALL REQUIRED ELECTRICAL CLEARANCES FOR DISCONNECTS, AFD'S AND ELECTRIC DUCT HEATERS PRIOR TO INSTALLATION. THIS MUST BE INCLUDED ON ALL CONTRACTOR SHOP DRAWINGS, PRIOR TO INSTALLATION.		11/10/14	REVISION #1
19.	ALL AHU SUPPLY AND RETURN CONNECTIONS SHALL HAVE A CANVAS STYLE FLEXIBLE CONNECTOR.			
20.	PROVIDE AN AIR FLOW MEASURING STATION ON ALL OUTSIDE AIR			
	INTAKES. THEY SHALL BE PER THE SPECIFICATIONS NO SUBSTITUTIONS. FULLY COORDINATE THEIR INSTALLATION REQUIREMENTS AND CLEARANCES PRIOR TO CONSTRUCTION.			
HEX	NOTES			
$\langle 1 \rangle$	NEW 34x24 INTAKE LOUVER IN EXISTING OPENING WITH 20" DEEP			
	INSULATED SHEET METAL PLENUM.			
<u><2</u> >	6" CONCRETE HOUSEKEEPING PAD. CONNECT TO EXISTING SIDEWALK AS REQUIRED TO MAKE A LEVEL MOUNTING SURFACE.			
3	EXTERIOR SUPPLY DUCTWORK MOUNTED AT GRADE. REFER TO DETAIL.			
	SUPPLY DUCTWORK UP.			
	18x18 SUPPLY DUCT ABOVE 20X14 RETURN DUCT IN NEW KITCHEN SOFFIT.			
6	EXTERIOR RETURN DUCT MOUNTED TO WALL BELOW GREASE FAN.		Key	Plan
	RETURN DUCT DN TO GRADE.	MPE	PROJ #: 20 ⁻	3-079
8	DOUBLE-WALLED SPIRAL DUCTWORK IN THIS AREA, MOUNTED BELOW EXISTING CEILING. PAINT TO MATCH EXISTING CEILING.		ned By:BW	
9	NOT USED.		n By:RN	
	1–1/2" CD TO 24" DRYWELL.		•	D
\frown	NEW 6' HIGH FENCE ENCLOSURE. REFER TO ARCHITECTURAL.		ked By:BW	
	NOT USED.		Date:	9/05/14
13	TRANSITION FROM CONCEALED EXTERNALLY WRAPPED DUCTWORK TO DOUBLE-WALLED SPIRAL DUCTWORK AT WALL.		-	1/4"=1'-0"
	COORDINATE DUCT ROUTING WITH EXISTING TRUSS LAYOUT COORDINATED SHOP DRAWINGS OF THIS AREA SHALL BE SUBMITTED PER SPECIFICATIONS PRIOR TO INSTALLATION.	Drawing	FLOOF	R PLAN
(15)	GROUND MOUNTED DUCT SUPPORT.			VATION
(16)	6"ø EA UP TO NEW ROOF JACK ON ROOF.		MECH	ANICAL
	ROUTE OA DUCT TIGHT TO CEILING.			
	16x14 OA UP THROUGH CEILING INTO CEILING PLENUM.		N 00	
(19)	DISCONNECT SWITCHES MOUNTED ON UNI-STRUT RACK.	100 Drawing		CTION DOCUMENTS
		Di di Willi	M 1	$\bigcirc 1$
		1	U V U U	

			UNIT DATA						FAN DATA				
UNIT NO.	SERVING			SAT.	DEEDIO	TOTAL			EXT.		MOTOF	R DATA	
UNIT NO.	SERVING	CAPACITY MBH	COND. EAT F	SUCT. F	REFRIG TYPE	TOTAL CFM	PRIMARY AIR	MAX OA	STATIC P. IN H20	HP	RPM	VOLT	
GPU-1	CONCESSION BLDG	100.1	95	-	R-410A	2100	1400	700	1	1	-	230	


	EAT F LAT F DB DB KW V	VOLT PH NO. STEPS	NO. HP VOL	T PH QUANTITY	STEPS VOLT	PH RLA (ea) LF	RA (ea) VOLT	PH FLA		IANUFACTURER MC	DDEL OPERATING WEIGHT (LB	
OG 100.1 95 - R-410A 2100 1400 700 1 1 . 230 1 80.7 68.0 52.5 52.5 12.4 Image: Second se	<u>60</u> 75.0 10	230 1 2	2 1 230	1 2	2 230	1 21.7	117 230	1 -	66 80	ADDISON TRS	SA096 2045	1,2,3
TE HOUSEKEEPING PAD 6 REFER TO SPECIFICATION SECTION 23 77 00 FOR APPRO												
ICLUDES ALL EQUIPMENT EXCEPT ELEC. HEAT. ELEC. HEAT IS A SEPARATE POWER CONNECTION. 7 DIGITAL SCROLL COMPRESSORS RD CONTROLS AND DIGITAL PROGRAMMABLE THERMOSTAT/HUMIDISTAT.												
		UST FAN SCHEDU										<u>~~</u>
		NO. SERVIN	3	ТҮРЕ	CFM BLADE TYPE	SONES STAT		MOTOR DA	MICCI		ON BASED ON: R MODEL	RE
	KEF-1 KSF-1					10.8 0.7					CWB-161-7	
	EF-1 EF-2 EF-3	2 NOT USE	D	ILING CABINET FAN				45w 1050			SP-B70	$\overline{\mathbf{x}}$
	REMAR					, V.Z			<u> </u>			<u> </u>
		1 PROVIDE BACKDR 2 PROVIDE DISCON	NECT AT THE UNIT			6 INTERI		DOD FANS WITH	KITCHEN HOOD C			
		3 HIGH-WIND RATED ⁴ REFER TO SPECIF EQUIPMENT.		34 00 FOR APPROVED	EQUALS FOR THIS				OCIATED ACCESSO DTENTIOMETER DI	ORIES FOR THE GREAS	E FAN	
		GENERAL COMME				-		REMOVABLE AI	LUMINUM FILTERS	i		
		1. ALL ROOF MOU	NTED FANS TO BE FL	ORIDA PRODUCT APP	ROVED AND TIED DO	NN PER THE DETAI	LS SHEET					
			EXHAUST & M	AKE-UP AIR SC							1	
				DIM. /IDTH HEIGHT WEIGI	EXHAUST	DOD DATA COLLAR DATA I QTY COLL	4.5	PLY COLLAR DA .P. (IN QTY		SELECTION BASED O	R	EMARKS
		КН-1 КІТС	(IN)	Inclusion Inclusion Inclusion (IN) (IN) (LBS) 48 24 245) CFM W.G.)	NUM SIZ		W.G.) NUM 0.138 1	SIZE		ODEL EW-84-S SE	EE NOTE:
				TEEL WHERE EXPOSE					48 IN LONG 12 IN W NG LIP (PEL) TECH			
		4. 18 IN I		SURES - FRONT LEFT	RIGHT - FIELD INSTAL		ANDING SEAM CO	NSTRUCTION				
			DRY MOUNTED EXHAU									
	PEOPLE	AREA				Service	& Pipe Con	Thicknes		Requirements	Schedule	No
OCCUPANCY CATEGORY: RESORTS OCCUPANT OCCUPANT	UTDOOR IR RATE SQ. FT. OF	OUTDOOR DE AIR RATE	FAULT VALUES	TOTAL OUTDOOR	Outside Air I			Installed R				
SERVED ROOM	AREA M/PERSON	REQ'D CFM/SQ. FT. SQ. F			Supply Air D All low press	ucts sure exposed ductw	vork in public			orated inner liner and my	ylar film separating	Double \
BY ROOM GPU-1 KITCHEN/DINING ROOM RESTAURANT DINING ROOMS 52	7.5 1300	0.18 70	10	624	areas:			Installed R	Exposed:	n from air stream :Rigid fiberglass with co atherproof sheet metal ja	orner angles with	
	[TOTAL REQUIR				d outdoors or in so	ffit exposed to	Installed R	Flex-Clad Products	400 as manufacturered		
		TOTAL SUPPLI	D FOR GP0-1		weather: Terminal to 0	Dutlet:		Installed R		sity blanket.		
NOTE: 1. REQUIRED OUTSIDE AIR CFM VALUES BASED ON ANSI/ASHRAE STANDARD 62.1-2007.					Return Air D	ucts				Specified in Specification		
					Ducts locate	d outside:		Installed R-	4.2 33 00 or F Building F	g duct specificed in Spec Flex-Clad 400 as manufa Products Corp.	cturered by MFM	
					All other retu Exhaust Air I	urn air ductwork:		Installed R-		ed - 2" thick external wra gid board with corner an		
					All general re	estroom exhaust du d exhaust ducts:	icts:			lired I in 2 hour fire rated duct 3m Firemaster	wrap enclosure	
					Piping Condensate	Drain (CD): All sizes	8	1/2"		cell Elastomeric		
						sification and the	0.07.00 feeting		tion			
					NOTES:	cification section 23		y Conservation (Code sections 503.2	2.7 through 503.2.8		
					Refer to specific		FBC 2010 - Mecha			······	~~~~~~	
					Refer to spec Insulation m Insulation m	ust meet or exceed ust meet or exceed	ASHRAE 90.1-201					
GRILLE, REGISTER AND DIFFUSER SCHEDULE:					Refer to spec Insulation m Insulation m	ust meet or exceed ust meet or exceed	ASHRAE 90.1-201	~~~~		NCE SCHEDULE	СОММЕ	
UNIT NO.		JCTION DATA ATERIAL COLOR	SELECTION I		Refer to spec Insulation m Insulation m	ust meet or exceed	ASHRAE 90.1-201	~~~~		E.A. PRESSURE 1750 -1750 I 1400 I I	COMME KITCHEN EXHAUST KITCHEN SUPPLY	
UNIT NO. TYPE SERVICE MOUNTING DATA	W SHAPE MA SQUARE ALL	ATERIAL COLOR LUMINUM WHITE LUMINUM WHITE	MANUFACTURER TITUS TITUS		Refer to spec Insulation m Insulation m Insulation m REMARKS	ust meet or exceed	ASHRAE 90.1-201	A. R.A.	AIR BALAN O.A.	E.A. PRESSURE 1750 -1750 I 1400 I 50 -50 I	KITCHEN EXHAUST	
$\begin{array}{c c c c c c c c c c c c c c c c c c c $	W SHAPE MA SQUARE ALL RECT. ALL RECT. ALL	ATERIAL COLOR	MANUFACTURER	MODEL -	Refer to spec Insulation m Insulation m Insulation m REMARKS 1,2	ust meet or exceed	ASHRAE 90.1-201 UNIT S KEF-1 KSF-1 EF-3 GPU-1 21 TOTAL 21	A. R.A. 00 00 0	AIR BALAN O.A. 1400 700 2100	E.A. PRESSURE 1750 -1750 I 1400 I I 50 -50 I	KITCHEN EXHAUST KITCHEN SUPPLY JANITORS NEW PACKAGED DX (
$\begin{tabular}{ c c c c c c c c c c c c c c c c c c c$	W SHAPE MA SQUARE ALL RECT. ALL RECT. ALL	ATERIAL COLOR LUMINUM WHITE LUMINUM WHITE LUMINUM WHITE	MANUFACTURER TITUS TITUS TITUS	MODEL TMS-AA 50F 300FL	Refer to spec Insulation m Insulation m Insulation m REMARKS	ust meet or exceed	ASHRAE 90.1-201 UNIT S KEF-1 KSF-1 EF-3 GPU-1 21 TOTAL 21	A. R.A. 00 00 0	AIR BALAN O.A. 1400 700 2100	E.A. PRESSURE 1750 -1750 I 1400 I I 50 -50 I 700 I I 1800 300 I	KITCHEN EXHAUST KITCHEN SUPPLY JANITORS NEW PACKAGED DX (

+ +	T F WB	LAT F	BEER	EAT F DB			DLT	РН	NO. STEPS		HP	VOLT		QUANTI	TY ST		VOLT	PH RL	(ea) L	.RA (ea)	VOLT	UNIT E	FLA	MCA	моср	MANU	IFACTURE		-, OPE	RATING HT (LBS)	REMARKS
80.7	68.0 5	2.5 52.	5 12.4	60	75.0	10 2	30	1	2	2	1	230	1	2		2	230	1 2	1.7	117	230	1	-	66	80	A	DDISON	TRSA	096 2	2045	1,2,3,4,5,6,7
MOTOR	ZED DAMPER F		OOR AIR S	HROUD.																											
	ICATION SECT		0 FOR AP	PROVED	EQUALS	FOR THIS I	QUIPI	MENT.																							
	~~~~			~		$\sim$	$\sim$		$\sim$	$\sim$	$\sim$	$\sim$	$\sim$	$\sim$	$\sim$	$\sim$	$\sim$	$\sim$		$\sim$	$\sim$	$\sim$	$\sim$	$\sim$	$\sim$	$\sim$	$\sim$	$\sim$	$\cdots$	$\sim$	$\cdots$
					<u>' \</u>	EXHAU	ST F	AN S	CHEE	OULE:								_	то	TAL			MOTOR	DATA		EHPA		SELECTION	BASED ON:		
						UNIT NC			SERV					(PE		CFM	BLADE TYPE	SONE	н	TIC IN 20	FAN RPM	HP		VOLT		MISSILE IMPACT		ACTURER	мог		REMARKS
						KEF-1 KSF-1 EF-1	$\overline{}$			D EXHA						1750		10.8		75 86	995 1473	3/4	1725 1725	120 -120-		N ~~~~~~~~~~~~~~~~~~~~~~~~~~~~~~~~~~~~			CWB-	-161-7 30-VG	2,3,4,6,7 12,4,6,8,9
						EF-2 EF-3			NOTU			CEIL	ING C	ABINET FA		50				25	675	45w	1050	120	- 	ب	GREE		SP-1	<b>B70</b>	1,2,4,5
						REMAR	KS:																							<u></u>	
										DRAFT D		JNIT							-					-	-		SHUTOFF	-	MINUTES		
							4 R	EFER 1			ON SECT	TION 23 34	00 FO	R APPRO\	/ED EQL	UALS FO	r This				EASE DR. EC MOTO						es for the	E GREASE	FAN		
										MENTS:									9 SLOP	ED FILT	ER BOX,	1" REMO	VABLE	ALUMIN	IUM FIL	TERS					
											FANS TO	) BE FLOF	RIDA P	RODUCTA	APPROV	ED AND	TIED DO	WN PER	HE DETA	AILS SHE	ET										
							<b>KI</b>	С П Е і				Τ 9 ΝΛΑ		JP AIR S	<u>с</u>	ייוס 🗖															
																		IOOD DAT			¢1	IPPLY C		)ΑΤΔ		SI		BASED ON			
							UNI	IT NO.	HOO	D SERVE	D LEN		отн н	EIGHT W	EIGHT LBS)	CFM	S.P. (II W.G.)		COL	LAR ZE		S.P. (IN W.G.)	T	co	LLAR SIZE	MANUF	ACTURER	мог	EL	REM	ARKS
							к	<b>(</b> H-1	K	TCHEN	8	, ,			245	1,750	0.527	-			1,400	0.138	1		6x10	GREE	NHECK	GHEW	-84-S	SEE N	NOTES
							NOT	ES:	2. UL7	10 LISTE	ED W/O E	EXHAUST	FIRE D	HERE EXP DAMPER - U		1726			7. IN	CLUDES	PERFOR	RMANCE	ENHAN			2 IN WIDE TECHNO	LOGY				
									4. 18 I	N HIGH (	CEILING	R SPACE - ENCLOSI EXHAUS	URES -		EFT RIGH	HT - FIELI	D INSTAL	LLED	8. S1	ANDING	SEAM C	ONSTR	JCTION								
							L																								
														]													_				
VENTI	LATION R	ATE R	EQUIR			HEDULE		۲ <u>۵</u>												t & Pi	ipe Co	onstru			sula	tion R			chedule		
				EMEN PEOPLE OUTDOOF AIR RATE	R		AR OUTD	EA DOOR RATE		DEFAUL	T VALUE	S		TAL			toido Air		Duc Service	t & Pi	ipe Co		Thickn	ess				n <b>ents S</b> _{Type}	chedule		Notes
			PANT	PEOPLE	R E SC	9. FT. OF AREA	AR OUTD AIR F	DOOR RATE Q'D	OCC DENS	UPANT ITY/1000	COM OUTDO	BINED DOR AIR	OUTE	DOOR CFM		Sup	tside Air oply Air D	Duct Ducts	Service				Thickn Installed	ess I R-6	.75#	density b	lanket	Туре			Notes
		occu	PANT	PEOPLE OUTDOOI AIR RATE	R E SC	9. FT. OF AREA	AR OUTD AIR F	DOOR RATE	OCC DENS	UPANT		BINED	oute Air	DOOR CFM		Sup	oply Air E low pres	Duct	Service			1"	Thickn	ess I R-6 Iy lined	.75# with insu	density k perforate altion fro	ed inner line m air strear	Type er and myla n	r film separat	ting Dou	Notes uble Wall Duct
PACE CLA		OCCL CO	PANT	PEOPLE OUTDOOI AIR RATE	R = SC DN	9. FT. OF AREA	AR OUTD AIR F	DOOR RATE Q'D SQ. FT. 18	OCC DENS SC	UPANT ITY/1000 Q. FT. 70	COM OUTDO R/ CFM/P	BINED DOR AIR ATE ERSON	OUTE AIR REQU	DOOR CFM JIRED 24		Sup All are	oply Air E low pres as:	Duct Ducts sure expo	Service sed duct	work in J	public	1"	Thickn Installed internal	ess I R-6 Iy lined	.75# with insu Expo oute Flex	density k perforate altion fro osed: Rig r weather -Clad 400	ed inner line m air strear gid fiberglas proof shee as manufa	Type er and myla n ss with cor		ting Dou th	
PACE CLA	SIFICATION	OCCL CO	PANT JNT C	PEOPLE OUTDOOI AIR RATE FM/PERS0	R = SC DN	0. FT. OF AREA	AR OUTD AIR F REC CFM/S	DOOR RATE Q'D SQ. FT. 18 TOTA		UPANT ITY/1000 Q. FT.	COM OUTDO R/ CFM/P	BINED DOR AIR ATE ERSON		DOOR CFM JIRED		Sup All are Duc wea	oply Air E low pres as: cts locate ather:	Duct Ducts sure expo ed outdoo	Service sed duct	work in J	public	1"	Thickn Installed internal Installed	ess   R-6  y lined   R-6	.75# with insu Exp oute Flex Proo Con	density b perforate altion fro osed: Rig r weather -Clad 400 lucts Cor cealed: .	ed inner line m air strear gid fiberglas proof shee as manufa ps. 75# density	Type er and myla n ss with cor et metal jack cturered by	r film separat ner angles wit	ting Dou th	
PACE CLA	SIFICATION	OCCL CO	PANT JNT C	PEOPLE OUTDOOI AIR RATE FM/PERS0	R = SC DN	0. FT. OF AREA	AR OUTD AIR F REC CFM/S	DOOR RATE Q'D SQ. FT. 18 TOTA		UPANT ITY/1000 Q. FT. 70 JIRED FC	COM OUTDO R/ CFM/P	BINED DOR AIR ATE ERSON		24		Sup All are Duc wea Ter	oply Air I low pres as: cts locate	Duct Ducts sure expo ed outdoo Outlet:	Service sed duct	work in J	public	1"	Thickn Installed internal Installed	ess   R-6  y lined   R-6	.75# with insu Exp oute Flex Proo Con	density k perforate altion fro osed: Rig r weather -Clad 400 lucts Cor	ed inner line m air strear gid fiberglas proof shee as manufa ps. 75# density	Type er and myla n ss with cor et metal jack cturered by	r film separat ner angles wit	ting Dou th	
SPACE CLA	SIFICATION	OCCL CON	PANT JNT C	PEOPLE OUTDOOI AIR RATE FM/PERS0	R = SC DN	0. FT. OF AREA	AR OUTD AIR F REC CFM/S	DOOR RATE Q'D SQ. FT. 18 TOTA		UPANT ITY/1000 Q. FT. 70 JIRED FC	COM OUTDO R/ CFM/P	BINED DOR AIR ATE ERSON		24		Sup All are Duc wea Ter	oply Air I low pres as: cts locate ather: minal to	Duct Ducts sure expo ed outdoo Outlet:	Service sed duct	work in J	public	1"	Thickn Installed internal Installed	ess   R-6  y lined   R-6	.75# with insu Expo oute Flex Proo Con .75#	density k perforate altion fro osed: Rig r weather -Clad 400 lucts Cor cealed: . density k	ed inner line m air strear gid fiberglas proof shee as manufa ps. 75# density planket.	Type er and myla n ss with cor to metal jack cturered by blanket blanket cification S d in Specif	r film separat ner angles wit et sealed with MFM Buildin ection 23 31 0 cation Sectio	ting Dou th h ng D1. n 23	
PACE CLA	SIFICATION	OCCL CON	PANT JNT C	PEOPLE OUTDOOI AIR RATE FM/PERS0	R = SC DN	0. FT. OF AREA	AR OUTD AIR F REC CFM/S	DOOR RATE Q'D SQ. FT. 18 TOTA		UPANT ITY/1000 Q. FT. 70 JIRED FC	COM OUTDO R/ CFM/P	BINED DOR AIR ATE ERSON		24		Sup All are Duc wea Ter Ret Duc	oply Air I low pres as: cts locate ather: minal to urn Air D	Duct Ducts sure expo ed outdoo Outlet: Ducts	Service sed duct	work in J	public	1"	Thickn Installed internal Installed	ess   R-6  y lined   R-6	.75# with insu Expo oute Flex Proo Con .75#	density k perforate altion fro osed: Rig r weather -Clad 400 lucts Cor cealed: . density k mal Spec lating due 0 or Flex- ding Proc	ed inner line m air strear gid fiberglas proof shee as manufa ps. 75# density lanket. ified in Spe ct specifice Clad 400 as lucts Corp.	Type er and myla n ss with cor at metal jack cturered by blanket blanket cification S d in Specif s manufact	r film separat ner angles wit et sealed with MFM Buildin ection 23 31 0 cation Sectio irered by MFM	ting Dou th h ig D1. in 23 M	
PACE CLA	SIFICATION	OCCL CON	PANT JNT C	PEOPLE OUTDOOI AIR RATE FM/PERS0	R = SC DN	0. FT. OF AREA	AR OUTD AIR F REC CFM/S	DOOR RATE Q'D SQ. FT. 18 TOTA		UPANT ITY/1000 Q. FT. 70 JIRED FC	COM OUTDO R/ CFM/P	BINED DOR AIR ATE ERSON		24		Sup All area Duc wea Ter Ret Duc All Exh	oply Air I low pres as: cts locate ather: minal to urn Air D cts locate other ret	Duct Ducts sure expo ed outdoo Outlet: Ducts ed outside turn air du Ducts	Service sed duct	offit exp	public	1"	Thickn Installed internal Installed Installed	ess   R-6  y lined   R-6   R-8   R-6   R-8	.75# with insu Expo oute Flex Proc Con .75#	density k perforate altion fro osed: Rig r weather -Clad 400 ducts Cor cealed: . density k mal Spec lating duc 0 or Flex- ding Proc cealed - 2	ed inner line m air strear gid fiberglas proof shee as manufa ps. 75# density lanket.	Type er and myla n ss with cor to metal jack cturered by blanket blanket cification S d in Specif s manufact	r film separat ner angles wit et sealed with MFM Buildin ection 23 31 0 cation Sectio irered by MFM	ting Dou th h ig D1. in 23 M	
PACE CLA	SIFICATION	OCCL CON	PANT JNT C	PEOPLE OUTDOOI AIR RATE FM/PERS0	R = SC DN	0. FT. OF AREA	AR OUTD AIR F REC CFM/S	DOOR RATE Q'D SQ. FT. 18 TOTA		UPANT ITY/1000 Q. FT. 70 JIRED FC	COM OUTDO R/ CFM/P	BINED DOR AIR ATE ERSON		24		Sup All area Duc wea Ter Ret Duc All Exh	oply Air I low pres as: cts locate ather: minal to urn Air D cts locate other ret naust Air general r	Duct Ducts sure expo ed outdoo Outlet: Ducts ed outside	Service sed duct rs or in s : : : : : : :	offit exp	public	1"	Thickn Installed	ess   R-6  y lined   R-6   R-8   R-6   R-8	Inter Insu 33 0 Buil Con - 1-1	density k perforate altion fro osed: Rig r weather -Clad 400 ducts Cor cealed: . density k mal Spec lating duc 0 or Flex- ding Proc cealed - 2 /2" rigid k Required pped in 2	ed inner line m air strear gid fiberglas proof shee as manufa ps. 75# density lanket. ified in Spe ct specifice Clad 400 as lucts Corp. " thick exter board with o	Type er and myla n ss with cor of metal jack cturered by blanket blanket cification S d in Specif s manufact ernal wrap corner angl	r film separat ner angles wit et sealed with MFM Buildin ection 23 31 0 cation Sectio irered by MFM	ting Dou th h ig D1. on 23 M osed	
SPACE CLA	SIFICATION	OCCL CON	PANT JNT C	PEOPLE OUTDOOI AIR RATE FM/PERS0	R = SC DN	0. FT. OF AREA	AR OUTD AIR F REC CFM/S	DOOR RATE Q'D SQ. FT. 18 TOTA		UPANT ITY/1000 Q. FT. 70 JIRED FC	COM OUTDO R/ CFM/P	BINED DOR AIR ATE ERSON		24		Sup All area Duc wea Ter Ret Duc All Exh All Kito Pip	oply Air I low pres as: cts locate ather: minal to urn Air D cts locate other ret naust Air general n chen hoo ing	Ducts sure expo ed outdoo Outlet: Ducts ed outside turn air du Ducts restroom	Service sed duct rs or in s ctwork:	work in p	public	1"	Thickn Installed	ess   R-6  y lined   R-6   R-8   R-6   R-4.2   R-4.2	Inter Inter Insu 33 0 Buil Con - 1-1	density k perforate altion fro osed: Rig r weather -Clad 400 lucts Cor cealed: . density k rnal Spec lating duc 0 or Flex- ding Proc cealed - 2 /2" rigid k Required pped in 2 al to 3m F	ed inner line m air strear gid fiberglas proof shee as manufa ps. 75# density lanket. ified in Spe ct specifice Clad 400 as lucts Corp. " thick exte board with o	Type er and myla n ss with cor of metal jack cturered by blanket blanket cification S d in Specif s manufact ernal wrap corner angl	r film separat ner angles wit et sealed with MFM Buildin ection 23 31 0 cation Sectio urered by MFM Expo	ting Dou th h ig D1. on 23 M osed	
SPACE CLA	SIFICATION	OCCL CON	PANT JNT C	PEOPLE OUTDOOI AIR RATE FM/PERS0	R = SC DN	0. FT. OF AREA	AR OUTD AIR F REC CFM/S	DOOR RATE Q'D SQ. FT. 18 TOTA		UPANT ITY/1000 Q. FT. 70 JIRED FC	COM OUTDO R/ CFM/P	BINED DOR AIR ATE ERSON		24		Sup All are Duc wea Ter Ret Duc All Exh All Kito Pip Cor	oply Air I low pres as: cts locate ather: minal to urn Air D cts locate other ret naust Air general n chen hoo ing	Duct Ducts sure expo ed outdoo Outlet: Ducts ed outside turn air du Ducts restroom	Service sed duct rs or in s ctwork:	work in p	public	1"	Thickn Installed Installed Installed	ess   R-6  y lined   R-6   R-8   R-6   R-4.2   R-4.2	Inter Inter Insu 33 0 Buil Con - 1-1	density k perforate altion fro osed: Rig r weather -Clad 400 lucts Cor cealed: . density k rnal Spec lating duc 0 or Flex- ding Proc cealed - 2 /2" rigid k Required pped in 2 al to 3m F	ed inner line m air strear gid fiberglas proof shee as manufa ps. 75# density lanket. ified in Spe ct specifice Clad 400 as lucts Corp. " thick exte board with o hour fire ra iremaster	Type er and myla n ss with cor of metal jack cturered by blanket blanket cification S d in Specif s manufact ernal wrap corner angl	r film separat ner angles wit et sealed with MFM Buildin ection 23 31 0 cation Sectio urered by MFM Expo	ting Dou th h ig D1. on 23 M osed	
SPACE CLA	SIFICATION	OCCL CON	PANT JNT C	PEOPLE OUTDOOI AIR RATE FM/PERS0	R = SC DN	0. FT. OF AREA	AR OUTD AIR F REC CFM/S	DOOR RATE Q'D SQ. FT. 18 TOTA		UPANT ITY/1000 Q. FT. 70 JIRED FC	COM OUTDO R/ CFM/P	BINED DOR AIR ATE ERSON		24		Sup All are Duc wea Ter Ret Duc All Exh All Kito Cor Cor Ref	oply Air I low pres as: cts locate ather: minal to urn Air D cts locate other ret naust Air general n chen hoo ing ndensate TES: er to spe	Ducts Sure exponent add outdoo Outlet: Ducts ed outside turn air du Ducts restroom od exhauss eDrain (Cl ecification	Service sed duct rs or in s ctwork: exhaust c ducts: 0): All size	work in p offit exp lucts:	public osed to	1"	Thickn Installed Installed Installed Installed Installed Installed	ess   R-6  y lined   R-6   R-8   R-6   R-4.2   R-4.2   R-4.2	Inter Insu 33 0 Buil Con - 1-1 Not Wra equa	density k perforate altion fro osed: Rig r weather -Clad 400 ducts Cor cealed: . density k rnal Spec lating duc 0 or Flex- ding Proc cealed - 2 /2" rigid k Required pped in 2 al to 3m F	ed inner line m air strear gid fiberglas proof shee as manufa ps. 75# density lanket. ified in Spe ct specifice Clad 400 as lucts Corp. " thick exte board with o hour fire ra iremaster	Type er and myla n ss with cor to metal jack cturered by blanket cification S d in Specif s manufactu ernal wrap corner angl ated duct w	r film separat ner angles wit et sealed with MFM Buildin ection 23 31 0 cation Sectio urered by MFM Expo	ting Dou th h ig D1. on 23 M osed	
SPACE CLA	SIFICATION	OCCL CON	PANT JNT C	PEOPLE OUTDOOI AIR RATE FM/PERS0	R = SC DN	0. FT. OF AREA	AR OUTD AIR F REC CFM/S	DOOR RATE Q'D SQ. FT. 18 TOTA		UPANT ITY/1000 Q. FT. 70 JIRED FC	COM OUTDO R/ CFM/P	BINED DOR AIR ATE ERSON		24		Sup All are Duc wea Ter Ret Duc All Exh All Kito Pip Cor Ref Insu	oply Air I low pres as: cts locate ather: minal to urn Air D cts locate other ret naust Air general r chen hoo ing ndensate TES: er to spe ulation m	Ducts Sure exponent add outdoo Outlet: Ducts ed outside turn air du Ducts restroom od exhauss eDrain (Cl ecification	Service sed duct rs or in s ctwork: exhaust c ducts: ): All size section 2 or exceed	work in p offit expe lucts: es 23-07-00 d FBC 20 d FBC 20	public osed to osed to for more 010 - Ene 010 - Mec	details a rgy Con hanical	Thickn Installed internal Installed Installed ess   R-6  y lined   R-6   R-8   R-6   R-4.2   R-4.2   R-4.2   R-4.2	Inter Insu 33 0 Buil Con - 1-1 Not Wra equa sections	density k perforate altion fro osed: Rig r weather -Clad 400 ducts Cor cealed: . density k rnal Spec lating duc 0 or Flex- ding Proc cealed - 2 /2" rigid k Required pped in 2 al to 3m F sed Cell E	ed inner line m air strear gid fiberglas proof shee as manufa ps. 75# density lanket. ified in Spe ct specifice Clad 400 as lucts Corp. " thick exter board with of hour fire ra iremaster lastomeric	Type er and myla n ss with cor to metal jack cturered by blanket cification S d in Specif s manufactu ernal wrap corner angl ated duct w	r film separat ner angles wit et sealed with MFM Buildin ection 23 31 0 cation Sectio urered by MFM Expo	ting Dou th h ig D1. on 23 M osed	
STAURANT	SIFICATION	OCCL CON	PANT JNT C	PEOPLE OUTDOOI AIR RATE FM/PERS0	R = SC DN	0. FT. OF AREA	AR OUTD AIR F REC CFM/S	DOOR RATE Q'D SQ. FT. 18 TOTA		UPANT ITY/1000 Q. FT. 70 JIRED FC	COM OUTDO R/ CFM/P	BINED DOR AIR ATE ERSON		24		Sup All are Duc wea Ter Ret Duc All Exh All Kito Pip Cor Ref Insu	oply Air I low pres as: cts locate ather: minal to urn Air D cts locate other ret naust Air general r chen hoo ing ndensate TES: er to spe ulation m	Duct Ducts sure expo ed outdoo Outlet: Ducts ed outside turn air du Ducts restroom od exhaus e Drain (Cl ecification nust meet	Service sed duct rs or in s ctwork: exhaust c ducts: 0): All size section 2 or exceed or exceed or exceed	work in p offit expendence lucts: es 23-07-00 d FBC 20 d FBC 20 d ASHR/	public osed to for more 010 - Ene 010 - Mec AE 90.1-2	details a rgy Con hanical 010, Tab	Thickn Installed Installed ess I R-6 I R-6 I R-8 I R-6 R-4.2 R-4.2 R-4.2 Code s ctions 6	Inter Insu 33 0 Buil Con - 1-1 Wra equa Clos	density k perforate altion fro osed: Rig r weather -Clad 400 ducts Cor cealed: . density k mal Spec lating duc 0 or Flex- ding Proc cealed - 2 /2" rigid k Required pped in 2 al to 3m F sed Cell E s 503.2.7 ti ough 604.	ed inner line m air strear gid fiberglas proof shee as manufa ps. 75# density lanket. ified in Spe clad 400 as lucts Corp. " thick exter board with of hour fire ra iremaster lastomeric	Type er and myla ss with cor et metal jack cturered by blanket cification S d in Specif s manufacturer ernal wrap corner angle ated duct w	r film separat ner angles wit et sealed with MFM Buildin ection 23 31 0 cation Sectio urered by MFM Expo	ting Dou th h log	Jble Wall Duct
SPACE CLA	SIFICATION	OCCL CON	PANT JNT C	PEOPLE OUTDOOI AIR RATE FM/PERS0		0. FT. OF AREA		Q'D SQ. FT. 18 TOTA TOTA		UPANT ITY/1000 Q. FT. 70 JIRED FC	COM OUTDO R/ CFM/P	BINED DOR AIR ATE ERSON		24 24 24		Sup All are Duc wea Ter Ret Duc All Exh All Kito Pip Cor NO Ref Insu Insu	oply Air I low pres as: cts locate ather: minal to urn Air D cts locate other ret naust Air general r chen hoo ing ndensate er to spe ulation m ulation m	Duct Ducts sure expo ed outdoo Outlet: Ducts ed outside turn air du Ducts restroom od exhaus e Drain (Cl ecification nust meet	Service sed duct rs or in s ctwork: exhaust c ducts: 0): All size section 2 or exceed or exceed or exceed	work in p offit expendence lucts: es 23-07-00 d FBC 20 d FBC 20 d ASHR/	public osed to for more 010 - Ene 010 - Mec AE 90.1-2	details a rgy Con hanical 010, Tab	Thickn Installed Installed ess I R-6 I R-6 I R-8 I R-6 R-4.2 R-4.2 R-4.2 R-4.2 Ctions 60 Ctions 60 Ctions 60	Inter Insu 33 0 Buil Con - 1-1 Wra equa Clos	density k perforate altion fro osed: Rig r weather -Clad 400 ducts Cor cealed: . density k mal Spec lating duc 0 or Flex- ding Proc cealed - 2 /2" rigid k Required pped in 2 al to 3m F sed Cell E s 503.2.7 ti ough 604.	ed inner line m air strear gid fiberglas proof shee as manufa ps. 75# density planket. ified in Spe ct specifice Clad 400 as lucts Corp. " thick exter board with of hour fire ra iremaster lastomeric astomeric <b>E SCHEI</b> A. PRE	Type er and myla ss with cor to metal jack cification S d in Specific s manufacte corner angle ated duct w 2.8 2.8 CULE SSURE	r film separat her angles with MFM Buildin ection 23 31 0 cation Sectio urered by MFM Expo es	ting Dou th h ng Dou Dou th h ng Dou Dou Dou Dou Dou Dou Dou Dou Dou Dou	
SPACE CLA	SIFICATION	OCCL CON 1-2007.	PANT JNT C 2 2 A WALL	PEOPLE OUTDOOI AIR RATE FM/PERSO 7.5	R ON ON SHAPE	2. FT. OF AREA 1300		DOOR RATE Q'D SQ. FT. 18 TOTA TOTA DATA		UPANT ITY/1000 2. FT. 70 JIRED FC PLIED FO	COM OUTDO R/ CFM/P	BINED DOR AIR ATE ERSON		DOOR CFM JIRED 24 24 24 00 00 00 00 00 00 00 00 00 00 00 00 00		Sup All are Duc wea Ter Ret Duc All Exh All Kito Pip Cor NO Ref Insu Insu Insu	oply Air I low pres as: cts locate ather: minal to urn Air D cts locate other ret naust Air general r chen hoo ing ndensate TES: er to spe ulation m ulation m	Duct Ducts sure expo ed outdoo Outlet: Ducts ed outside turn air du Ducts restroom od exhaus e Drain (Cl ecification nust meet	Service sed duct rs or in s ctwork: exhaust c ducts: 0): All size section 2 or exceed or exceed or exceed	work in p offit expe lucts:	public osed to for more 010 - Ene 010 - Mec AE 90.1-2	details a rgy Con hanical 010, Tab	Thickn Installed Installed ess I R-6 I R-6 I R-8 I R-6 R-4.2 R-4.2 R-4.2 R-4.2 Ctions 60 Ctions 60 Ctions 60	.75# with insu Expoute Flex Prod Con .75# Intel Insu 33 0 Buil Con - 1-1 Not Wra equa clos 04.1 thro 04.1 thro Not R BA O.A.	density k perforate altion fro osed: Rig r weather -Clad 400 ducts Cor cealed: . density k mal Spec lating duc 0 or Flex- ding Proc cealed - 2 /2" rigid k Required pped in 2 al to 3m F sed Cell E s 503.2.7 t ough 604."	ed inner line m air strear gid fiberglas proof shee as manufa ps. 75# density lanket. ified in Spe ct specifice Clad 400 as lucts Corp. '' thick exter board with of hour fire ra iremaster lastomeric as corp. '' thick exter board with of board with of board with of board with of coard with of board with of coard with of board with of board with of board with of board with of coard with of board with of board with of coard with of board with of coard with of coard with of board with of coard with of board with of coard with of coa	Type  rype  rype	r film separat her angles with tet sealed with MFM Buildin ection 23 31 C cation Section urered by MFM Exponent Exponent Expone	ting Dou th h ng Dou th h ng Dou th h ng Dou th h ng Dou th h ng Dou th h ng Dou th h ng Dou th h ng Dou th h ng Dou th h ng Dou th h ng Dou th h ng Dou th h ng Dou th h ng Dou th h ng Dou th th h ng Dou th h ng Dou th th h ng Dou th th h ng Dou th th h ng Dou th th th h ng Dou th th th h ng Dou th th th th th th th th th th th th th	Jole Wall Duct
SPACE CLA	SIFICATION	OCCU CON 5 1-2007.		PEOPLE OUTDOOI AIR RATE FM/PERSO 7.5	SHAPE	2. FT. OF AREA 1300		DOOR RATE Q'D SQ. FT. 18 TOTA TOTA DATA 		UPANT ITY/1000 2. FT. 70 JIRED FC PLIED FO		BINED DOR AIR ATE ERSON		DOOR CFM JIRED 24 24 24 00 00 00 00 00 00 00 00 00 00 00 00 00		All are Duc wea Ter Ret Duc All Exh All Kito Pip Cor NO Ref Insu Insu Ref	oply Air I low pres as: cts locate ather: minal to urn Air D cts locate other ret naust Air general n chen hoo ing ndensate ItES: er to spe ulation m ulation m ulation m ulation m ulation m	Duct Ducts sure expo ed outdoo Outlet: Ducts ed outside turn air du Ducts restroom od exhaus e Drain (Cl ecification nust meet	Service sed duct rs or in s ctwork: exhaust c ducts: 0): All size section 2 or exceed or exceed or exceed	work in p offit expe diffit expension diffit expension di	public osed to for more D10 - Ene D10 - Mec AE 90.1-2	1"	Thickn Installed Installed ess I R-6 I R-8 I R-6 R-4.2 R-4.2 R-4.2 Code s Code	Inter Inter Inter Insu 33 0 Buil Con - 1-1 Var equa Clos Clos Inter Insu 33 0 Buil Con - 1-1 Var equa Clos Inter Insu 33 0 Buil Con - 1-1 Var Exprod	density k perforate altion fro osed: Rig r weather -Clad 400 ducts Cor cealed: . density k rnal Spec lating duc 0 or Flex- ding Proc cealed - 2 /2" rigid k Required pped in 2 al to 3m F sed Cell E as 503.2.7 t ough 604.	ed inner line m air strear gid fiberglas proof shee as manufa ps. 75# density lanket. ified in Spe Clad 400 as lucts Corp. " thick exte board with of hour fire ra iremaster lastomeric lastomeric brough 503. 13 <b>E SCHEI</b> A. PRE 50 - 1 0	Type  Type  r and myla  ss with cor the metal jacl cturered by blanket  cification S d in Specifi s manufact corner angl ated duct w  2.8  DULE SSURE 1750 KI 400 KI -50 JA 700 NE	r film separat her angles with tet sealed with MFM Buildin ection 23 31 0 cation Sectio urered by MFM Expo es rap enclosure	ting Dou th h ng Dou th h ng Dou th h ng Dou th h ng Dou th h ng Dou th h ng Dou th h ng Dou th h ng Dou th h ng Dou th h ng Dou th h ng Dou th h ng Dou th h ng Dou th h ng Dou th h ng Dou th th h ng Dou th h ng Dou th th h ng Dou th th h ng Dou th th h ng Dou th th th h ng Dou th th th h ng Dou th th th th th th th th th th th th th	Jole Wall Duct
SPACE CLA	SIFICATION	OCCU CON 5 1-2007.	PANT JNT C 2 2 A WALL 3H L0	PEOPLE OUTDOOI AIR RATE FM/PERSO 7.5		2. FT. OF AREA 1300		DOOR RATE Q'D SQ. FT. 18 TOTA TOTA TOTA DATA - (0 M M		UPANT ITY/1000 2. FT. 70 JIRED FC PLIED FO	COM OUTDO R/ CFM/P PR GPU-1 R GPU-1 SELE ANUFAC	BINED DOR AIR ATE ERSON		DOOR CFM JIRED 24 24 24 00 00 00 00 00 00 00 00 00 00 00 00 00		Sup All are Duc wea Ter Ret Duc All Exh All Kito Pip Cor NO Ref Insu Insu Ref	oply Air I low pres as: cts locate ather: minal to urn Air D cts locate other ret naust Air general n chen hoo ing ndensate TES: fer to spe ulation m ulation m ulation m	Duct Ducts sure expo ed outdoo Outlet: Ducts ed outside turn air du Ducts restroom od exhaus e Drain (Cl ecification nust meet	Service sed duct rs or in s ctwork: exhaust c ducts: b): All size or exceed or exceed or exceed or exceed	work in p offit expe lucts: lucts: es 23-07-00 d FBC 20 d FBC 20 d FBC 20 d FBC 20 d FBC 20 d ASHR/ WNIT KEF-1 KSF-1 EF-3 GPU-1	public osed to for more 010 - Ene 010 - Mec AE 90.1-2	1" 1" 1" 1" 1"	Thickn Installed Installed ess I R-6 I R-6 I R-8 I R-6 R-4.2 R-4.2 R-4.2 Clions 60 Clions 60 Al	.75# with insu Expoute Flex Prod Con .75# Intel Insu 33 0 Buil Con - 1-1 Not Wra equa Clos 04.1 thro Sections 04.1 thro Not IR BA O.A.	density k perforate altion fro osed: Rig r weather -Clad 400 ducts Cor cealed: . density k rnal Spec lating duc 0 or Flex- ding Proc cealed - 2 /2" rigid k Required pped in 2 al to 3m F sed Cell E s 503.2.7 t ough 604. <b>LANCI</b> 5 17	ed inner line m air strear gid fiberglas proof shee as manufa ps. 75# density lanket. ified in Spe ct specifice Clad 400 as lucts Corp. " thick exter board with of hour fire ra iremaster lastomeric brough 503. 13 <b>E SCHEI</b> A. PRE 50 - 10	Type  Type  rype  rype	r film separat her angles with tet sealed with MFM Buildin ection 23 31 0 cation Sectio arered by MFM Expo ess rap enclosure cation Sectio arered by MFM Expo ess rap enclosure	ting Dou th h ng Dou Dou th h ng Dou Dou Dou Dou Dou Dou Dou Dou Dou Dou	Jole Wall Duct
SPACE CLA	SIFICATION	OCCU CON 5 1-2007.		PEOPLE OUTDOOI AIR RATE FM/PERSO 7.5	SHAPE	2. FT. OF AREA 1300		DOOR RATE Q'D SQ. FT. 18 TOTA TOTA TOTA DATA - (0 M M		UPANT ITY/1000 2. FT. 70 JIRED FC PLIED FO		BINED DOR AIR ATE ERSON		DOOR CFM JIRED 24 24 24 24 24 24 24 20 20 21 24 24 24 20 20 20 20 20 20 20 20 20 20 20 20 20		Sup All are Duc wea Ter Ret Duc All Exh All Kito Pip Cor NO Ref Insu Insu Ref	oply Air I low pres as: cts locate ather: minal to urn Air D cts locate other ret naust Air general r chen hoo ing ndensate ulation m ulation m ulation m ulation m ulation m	Duct Ducts sure expo ed outdoo Outlet: Ducts ed outside turn air du Ducts restroom od exhaus e Drain (Cl ecification nust meet	Service sed duct rs or in s ctwork: exhaust c ducts: b): All size or exceed or exceed or exceed or exceed	work in p offit expe lucts: lucts: es 23-07-00 d FBC 20 d FBC 20 d FBC 20 d FBC 20 d FBC 20 d ASHR/ WNIT KEF-1 KSF-1 EF-3 GPU-1	public osed to for more 010 - Ene 010 - Mec AE 90.1-2	1" 1" 1" 1" 1"	Thickn Installed Installed ess I R-6 I R-6 I R-8 I R-6 R-4.2 R-4.2 R-4.2 Clions 60 Clions 60 Al	.75# with insu Expoute Flex Prod Con .75# Intel Insu 33 0 Buil Con - 1-1 Not Wra equa Clos 04.1 thro Sections 04.1 thro Not IR BA O.A.	density k perforate altion fro osed: Rig r weather -Clad 400 ducts Cor cealed: . density k rnal Spec lating duc 0 or Flex- ding Proc cealed - 2 /2" rigid k Required pped in 2 al to 3m F sed Cell E s 503.2.7 t ough 604. <b>LANCI</b> 5 17	ed inner line m air strear gid fiberglas proof shee as manufa ps. 75# density lanket. ified in Spe ct specifice Clad 400 as lucts Corp. " thick exter board with of hour fire ra iremaster lastomeric brough 503. 13 <b>E SCHEI</b> A. PRE 50 - 10	Type  Type  rype  rype	r film separat her angles with tet sealed with MFM Buildin ection 23 31 0 cation Sectio arered by MFM Expo ess rap enclosure cation Sectio arered by MFM Expo ess rap enclosure	ting Dou th h ng Dou Dou th h ng Dou Dou Dou Dou Dou Dou Dou Dou Dou Dou	


	EA DB 30.7	T F WB 68.0	LA DB 52.5	AT F WB 52.5	EER 12.4	EAT F DB 60	LAT F DB 75.0	КW 10	VOLT 230	PH 1	STE	0. EPS NC		IP	VOLT 230	PH 1	QUANTIT 2		EPS	VOLT 230		(ea) LRA	(ea)	VOLT 230	PH 1	FLA	MCA 66	MOCP 80		FACTURE		ODEL SA096	OPERATIN WEIGHT (LI 2045	BS)	EMARKS 2,3,4,5,6,
го	SPECII	ZED DAMPE VICATION SE COMPRESS	CTION												~~		~~			~~~												~~~			~~
						<u> </u>		EXHA		FAN S			:							BLAD	_	тота		FAN	M		ΔΤΑ		EHPA		SELECT	ION BAS	SED ON:		
										КІТСН			IAUST	v	VALL-M		PE	DRIVE	CFM 1750	TYPE		STATIC H20 0.75	IN	8PM 995			VOLT 120		MISSILE MPACT N	MANUF/ GREE			MODEL CWB-161-7		EMARKS
								KSF EF-			HEN NO	HOOD SL T USED		$\sim$			CTDRIV			-	-107	_			-3/4			- <b>1</b>					<u>- SO-130-VG</u>		2,4,6,8,9
								EF- EF-		JA		T USED	ET	$\leftarrow$	CEILI	NG CAI	BINET FA		- 50			0.25		675	45w	1050	120	Ý	÷	GREE	NHECK		SP-B70		1,2,4,5
									2 3 4	PROVID HIGH-W REFER EQUIPM <u>GENER</u>	DE DIS /IND F TO SI /IENT. AL CO		т ат т тіон s <u>3:</u>	HE UNI	N 23 34 (		APPROV ODUCT A					5 FAN TO 6 INTERLO 7 PROVIDI 8 VARI-GR 9 SLOPED HE DETAILS	CK KIT GREA EEN EC FILTER	CHEN H SE DRA C MOTO R BOX, 1	iood fai In and a R W/Mou	IS WITH LL ASS NTED F	H KITCH OCIATE OTENT	EN HO D ACC IOMETI	OD CONT ESSORIE ER DIAL	ROL PANE	EL		ITES		
									KI	TCHE	N H	OOD E	XHA	UST	& MA	KE-U	P AIR S	SCHE	DULE																
									U	NIT NO.	н	OOD SER	VED -			DIM.				XHAUST		ATA					-		SE		BASED	ON:		REMARK	S
										KH-1		KITCHE		(IN) 84	(IN)	) (	(IN) (I	(LBS) 245	CFM 1,750	S.P. ( W.G. 0.52	) NUM			FM	S.P. (IN W.G.) 0.138	QTY NUM	S	LAR ZE x10		ACTURER		IODEL EW-84-S	s s		ES
											4. 1	BACK INT 18 IN HIG FACTOR Y		ING EN	ICLOSU	RES - F	RONT LE	EFT RIG	HT - FIEL	.D INSTA	LLED	8. STAN	IDING S	SEAM CO	ONSTRU	TION									
<b>.</b>	ENII	LATION		TE RE		PEOPLE		HEDU	A	REA											S		& Pip	e Co				sulat	ion Re	equiren		Sche	edule	N	otes
							R E SO	HEDU A. FT. OF AREA	A OUT AIR R	REA DOOR RATE EQ'D /SQ. FT.	DE	DEFA CCUPAN NSITY/10 SQ. FT.		LUES COMBIN ITDOOI RATE	NED R AIR E	TOT/ OUTDO AIR C REQUI	DOR FM		Su All	-	Duct	ervice				Thickne stalled ternally	ss R-6 / lined	.75#	density b perforate	lanket d inner line	Type er and m		edule		otes Wall Duc
SPA	CLA		4	OCCUPA		PEOPLE OUTDOOI AIR RATE	R E SO	Q. FT. OF	A OUT AIR R CFM	TDOOR RATE EQ'D /SQ. FT. 0.18 TOTA	AL RE	CCUPAN NSITY/10	FOR GI	COMBIN ITDOOI RATE FM/PER 10 PU-1		OUTDO AIR C			Su All are Du we	pply Air low pres eas:	Ducts Soure exposed	ervice sed ductwo	rk in pu	blic		Thickne stalled	ss R-6 / lined R-6 R-8	.75# with insua Expo oute Flex- Prod Cond	density b perforate altion from sed: Rig r weather Clad 400 ucts Corp	lanket d inner line n air strear id fiberglas proof shee as manufa os. '5# density	Type er and m n ss with c et metal j	nylar film corner an jacket sea d by MFM	n separating ngles with ealed with		
SPA	JRANT	SSIFICATION	MS	OCCUPA COUNT 52		PEOPLE OUTDOOF AIR RATE	R E SO	Q. FT. OF AREA	A OUT AIR R CFM	TDOOR RATE EQ'D /SQ. FT. 0.18 TOTA	AL RE	CCUPAN NSITY/10 SQ. FT. 70	FOR GI	COMBIN ITDOOI RATE FM/PER 10 PU-1					Su All are Du we Tel Re Du	pply Air low pres eas: cts locat ather: rminal to turn Air I	Ducts Soure exposed and outdoor Outlet:	ervice sed ductwo	rk in pu	blic		Thickne stalled ternally stalled stalled	ss R-6 / lined R-6 R-8 R-6	.75# with insua Expo outer Flex- Prod Cond .75#	density b perforate altion from sed: Rig r weather Clad 400 ucts Corp cealed: .7 density b nal Speci ating duc o or Flex- ling Prod	lanket d inner ling n air strear id fiberglas proof shee as manufa os. '5# density lanket. fied in Spe t specifice Clad 400 as ucts Corp. " thick exte	Type er and m n ss with c et metal j acturerec v blanket v blanket ecificatio ed in Spe s manufa	nylar film corner an jacket sea d by MFM n Section acturered	n separating ngles with aled with A Building n 23 31 01. on Section 23		
SPA	JRANT	SSIFICATION	MS	OCCUPA COUNT 52		PEOPLE OUTDOOF AIR RATE	R E SO	Q. FT. OF AREA	A OUT AIR R CFM	TDOOR RATE EQ'D /SQ. FT. 0.18 TOTA	AL RE	CCUPAN NSITY/10 SQ. FT. 70	FOR GI	COMBIN ITDOOI RATE FM/PER 10 PU-1					Su All are Du we Te Re Du All All	pply Air low preseas: cts locat ather: rminal to turn Air I cts locat other re haust Air general	Duct Ducts ssure expo ed outdoor Outlet: Ducts ed outside: turn air duc	ervice sed ductwo s or in soff twork:	rk in pul	blic		Thickne stalled ternally stalled stalled	ss R-6 / lined R-6 R-8 R-6	.75# with insua Expo oute Flex- Prod Cond .75# Inter Insul 33 00 Build Cond - 1-1/	density b perforate altion from sed: Rig r weather Clad 400 ucts Corp cealed: .7 density b mal Speci ating duc o r Flex ling Prod cealed - 2 2" rigid b Required oped in 2	lanket d inner lind n air strear id fiberglas proof shee as manufa os. '5# density lanket. fied in Spe ct specifice Clad 400 as ucts Corp. " thick exte oard with o	Type er and m ss with c et metal j acturerec / blanket / blanket / blanket / blanket / blanket / blanket	nylar film corner an jacket sea d by MFM n Section acturered ap ngles	n separating ngles with aled with A Building n 23 31 01. on Section 23 d by MFM Exposed		
SPA	JRANT	SSIFICATION	MS	OCCUPA COUNT 52		PEOPLE OUTDOOF AIR RATE	R E SO	Q. FT. OF AREA	A OUT AIR R CFM	TDOOR RATE EQ'D /SQ. FT. 0.18 TOTA	AL RE	CCUPAN NSITY/10 SQ. FT. 70	FOR GI	COMBIN ITDOOI RATE FM/PER 10 PU-1					Su All are Du we Te Re Du All Ex All Kit	pply Air low pres eas: cts locat ather: rminal to turn Air I cts locat other re haust Ain general chen hoo	Ducts Ducts Sure exponent ed outdoor Outlet: Ducts ed outside: turn air duct restroom e	ervice sed ductwo s or in soff twork: xhaust duc ducts:	rk in pul	blic		Thickne stalled ternally stalled stalled	ss R-6 / lined R-6 R-8 R-6	Inter Insul 33 00 Build Cond - 1-1/	density b perforate altion from sed: Rig r weather Clad 400 ucts Corp cealed: .7 density b mal Speci ating duc ) or Flex- ling Prod cealed - 2 2" rigid b Required oped in 2 I to 3m F	lanket d inner lind n air strear id fiberglas proof shee as manufa os. '5# density lanket. fied in Spe ct specifice Clad 400 as ucts Corp. " thick exter oard with o	Type er and m ss with c et metal j acturerec / blanket / blanket / blanket / corner an corner an ated duc	nylar film corner an jacket sea d by MFM n Section acturered ap ngles	n separating ngles with aled with A Building n 23 31 01. on Section 23 d by MFM Exposed		
SPA	JRANT	SSIFICATION	MS	OCCUPA COUNT 52		PEOPLE OUTDOOF AIR RATE	R E SO	Q. FT. OF AREA	A OUT AIR R CFM	TDOOR RATE EQ'D /SQ. FT. 0.18 TOTA	AL RE	CCUPAN NSITY/10 SQ. FT. 70	FOR GI	COMBIN ITDOOI RATE FM/PER 10 PU-1					Su All are Du we Te Re Du All Ex All Kit Pi¢ Co NO Re Ins	pply Air low pres eas: cts locat ather: rminal to turn Air I cts locat other re haust Ain general chen hoo bing ndensate pTES: fer to spo sulation r	Duct Ducts ssure exposes ed outdoor Outlet: Ducts ed outside: turn air ducts restroom e od exhaust	ervice sed ductwo s or in soff twork: xhaust duc ducts: ): All sizes section 23-0 or exceed F or exceed F or exceed F	rk in pul t expose is: 07-00 fo BC 2010 BC 2010 SHRAE	blic ed to or more of 0 - Energy 0 - Mech E 90.1-20	Ins Ins Ins Ins Ins Ins Ins Ins Ins Ins	Thickne stalled ternally stalled stalled stalled F stalled F stalled F stalled F stalled S stalled F stalled F stalled F stalled S stalled S stall	ss R-6 / lined R-6 R-8 R-6 R-4.2 R-4.2 R-4.2 R-4.2 R-4.2 R-4.2 R-4.2 R-4.2 R-4.2 R-4.2 R-4.2 R-4.2 R-4.2 R-4.2 R-6 R-6 R-6 R-6 R-6 R-6 R-6 R-6 R-6 R-6	.75# with insua Expo outer Flex- Prod Cond .75# Inter Insul 33 00 Builo Cond - 1-1/ Wrap equa Clos 4.1 thro	density b perforate altion from sed: Rig r weather Clad 400 ucts Corp cealed: .7 density b nal Speci ating duc 0 or Flex-d ling Prod cealed - 2 2" rigid b Required oped in 2 I to 3m F ed Cell E 503.2.7 th ugh 604.1	lanket d inner line n air strear id fiberglas proof shee as manufa os. '5# density lanket. fied in Spe clad 400 as ucts Corp. " thick exte oard with o hour fire ra iremaster astomeric astomeric astomeric	Type er and m ss with c et metal j acturerec v blanket corner al ernal wra corner al ated duc	nylar film corner an jacket sea d by MFM n Section acturered ap ngles	n separating ngles with aled with A Building n 23 31 01. on Section 23 d by MFM Exposed	Double	Wall Duc
	E CLA	SSIFICATION	4 MS 62.1-20	0CCUPA COUNT 52		PEOPLE OUTDOOF AIR RATE		2. FT. OF AREA 1300		TDOOR RATE EQ'D /SQ. FT. 0.18 TOTA TOTA	AL RE	CCUPAN NSITY/10 SQ. FT. 70		COMBIN ITDOOI RATE M/PER 10 PU-1 PU-1					Su All are Du we Te Re Du All Ex All Kit Pi¢ Co NO Re Ins	pply Air low pres eas: cts locat ather: rminal to turn Air I cts locat other re haust Ain general chen hoo bing ndensate pTES: fer to spo sulation r	Duct Ducts ssure expose ed outdoor Outlet: Ducts ed outside: turn air duc Ducts restroom e od exhaust e Drain (CD ecification in nust meet o	ervice sed ductwo s or in soff twork: xhaust duc ducts: ): All sizes section 23-1 or exceed F or exceed F or exceed A or exceed A	rk in pul	blic ed to or more of 0 - Energ 0 - Mech E 90.1-20	Ins Ins Ins Ins Ins Ins Ins Ins Ins Ins	Thickne stalled ternally stalled stalled stalled F stalled F stalled F stalled F stalled S stalled F stalled F stalled F stalled S stalled S stall	ss R-6 / lined R-6 R-8 R-6 R-4.2 R-4.2 R-4.2 R-4.2 R-4.2 R-4.2 R-4.2 R-4.2 R-4.2 R-4.2 R-4.2 R-4.2 R-4.2 R-4.2 R-4.2 R-4 R-6 R-6 R-6 R-6 R-6 R-6 R-6 R-6 R-6 R-6	.75# with insua Expo oute Flex- Prod Cond .75# Inter Insul 33 00 Build Cond - 1-1/ Wrap equa Clos 4.1 thro	density b perforate altion from sed: Rig r weather Clad 400 ucts Corp cealed: .7 density b nal Speci ating duc 0 or Flex ling Prod cealed - 2 2" rigid b Required oped in 2 I to 3m F ed Cell E 503.2.7 th ugh 604.1	lanket d inner lind n air strear id fiberglas proof shee as manufa os. '5# density lanket. fied in Spe ct specifice Clad 400 as ucts Corp. " thick exter oard with of hour fire ra aremaster astomeric astomeric astomeric	Type er and m ss with c et metal j acturerec v blanket ecificatio ed in Spe s manufa corner an ated duc ated duc	nylar film corner an jacket sea d by MFM n Section acturered ap ngles et wrap er	n separating ngles with aled with A Building n 23 31 01. on Section 23 d by MFM Exposed nclosure		Wall Duc
	E CLA	SSIFICATION	4 MS 62.1-20	OCCUPA COUNT 52 007.		PEOPLE OUTDOOR AIR RATE 7.5		2. FT. OF AREA 1300		DOOR RATE EQ'D /SQ. FT. 0.18 TOT/ TOT/	AL RE	CCUPAN NSITY/10 SQ. FT. 70 GQUIRED JPPLIED		COMBIN ITDOOI RATE M/PER 10 PU-1 PU-1					Su All are Du We Te Re Du All Ex All Kit Pi¢ Co NO Re Ins Ins	pply Air low pres eas: cts locat ather: rminal to turn Air I cts locat other re haust Ain general chen hoo bing ndensate pTES: fer to spo sulation r	Duct Ducts ssure expose ed outdoor Outlet: Ducts ed outside: turn air duc Ducts restroom e od exhaust e Drain (CD ecification in nust meet o	ervice sed ductwo s or in soff twork: twork: xhaust duc ducts: ): All sizes section 23-0 or exceed F or exceed F or exceed A	rk in pul t expose is: 07-00 fo BC 2010 BC 2010 SHRAE SHRAE	blic ed to or more of 0 - Energ 0 - Mech E 90.1-20	Instantial Control of	Thickne stalled stalled stalled stalled F stalled F stalled F stalled F stalled F stalled S stalled F stalled F stalle StalleS stall F stalleS stalleS stallS stalleS stalleS stalleS	ss R-6 / lined R-6 R-8 R-6 R-4.2 R-4.2 R-4.2 R-4.2 R-4.2 R-4.2 R-4.2 R-4.2 R-4.2 R-4.2 R-4.2 R-4.2 R-4.2 R-4.2 R-4 R-6 R-4 R-6 R-6 R-6 R-6 R-6 R-6 R-6 R-6	.75# with insua Expo outer Flex- Prod Cond .75# Inter Insul 33 00 Build Cond - 1-1/ Not F Wrap equa Clos 4.1 thro R BA	density b perforate altion from sed: Rig r weather Clad 400 ucts Corp cealed: .7 density b nal Speci ating duc o or Flex ling Prod cealed - 2 2" rigid b Required oped in 2 I to 3m F ed Cell E 503.2.7 th ugh 604.1	lanket d inner line n air strear id fiberglas proof shee as manufa os. '5# density lanket. fied in Spe ct specifice Clad 400 as ucts Corp. " thick exte oard with o hour fire ra iremaster astomeric astomeric astomeric astomeric	Type er and m ss with c et metal j acturerec y blanket ecificatio es manufa ernal wra corner an ated duc ated duc es SURE 5SURE 1750 1400	nylar film corner an jacket sea d by MFM on Section acturered ap ngles et wrap er	n separating ngles with ealed with A Building n 23 31 01. n Section 23 d by MFM Exposed nclosure COMM N EXHAUST N SUPPLY		Wall Duc
	E CLA	SSIFICATION	62.1-20	OCCUPA COUNT 52 007.		PEOPLE OUTDOOR AIR RATE 7.5		2. FT. OF AREA 1300 CONSTR		TOOOR         RATE         EQ'D         /SQ. FT.         0.18         TOTA         TOTA         I DATA         AL         JM		CCUPAN NSITY/10 SQ. FT. 70 GUIRED JPPLIED	FOR GI FOR GI FOR GF	COMBIN ITDOOI RATE M/PER 10 PU-1 PU-1 PU-1 PU-1 PU-1 PU-1 PU-1			DOR FM RED		Su All are Du we Te Re Du All Ex All Kit Pic Co NO Re Ins Ins Ins	pply Air low pres eas: cts locat ather: rminal to turn Air I cts locat other re haust Ain general chen hoo bing ndensate fer to spo sulation r sulation r sulation r sulation r	Duct Ducts ssure expose ed outdoor Outlet: Ducts ed outside: turn air duc Ducts restroom e od exhaust e Drain (CD ecification in nust meet o	ervice sed ductwo s or in soff twork: twork: xhaust duc ducts: ): All sizes section 23-0 or exceed F or exceed F or exceed F or exceed A	rk in pul t expose is: 07-00 fo BC 2010 BC 2010 SHRAE VINIT EF-1 SF-1 EF-1 SF-1 EF-3 PU-1	blic ed to or more of 0 - Energy 0 - Mech 2 90.1-20	details an gy Conse hanical Co 10, Table	Thickne stalled ternally stalled stalled fatalled F stalled F stalled F stalled F stalled F stalled F stalled S stalled F stalled F stalle StalleS stalleS stalleS stallS stallS ss R-6 / lined R-6 R-8 R-6 R-4.2 R-4.2 R-4.2 R-4.2 R-4.2 R-4.2 R-4.2 R-4.2 R-4.2 R-4.2 R-4.2 R-4.2 R-4.2 R-4.2 R-4.2 R-4.2 R-4.2 R-4.2 R-4.2 R-4.2 R-4 R-6 R-6 R-6 R-6 R-6 R-6 R-6 R-6	.75# with insua Expo outer Flex- Prod Cond .75# Inter Insul 33 00 Build Cond - 1-1/ Wrap equa Clos 4.1 thro Clos 4.1 thro <b>R BA</b> O.A.	density b perforate altion from sed: Rig r weather Clad 400 ucts Corp cealed: .7 density b nal Speci ating duc 0 or Flex ling Prod cealed - 2 2" rigid b Required oped in 2 1 to 3m F ed Cell E 503.2.7 th ugh 604.1	lanket d inner ling n air strear id fiberglas proof shee as manufa os. '5# density lanket. fied in Spe t specifice Clad 400 as ucts Corp. " thick exte oard with o hour fire ra iremaster astomeric	Type er and m ss with c et metal j acturerec y blanket ecificatio ed in Spe s manufa ernal wra corner al ated duc ated duc es SURE 5SURE 1750 1400 -50 700	nylar film corner an jacket sea d by MFM n Section acturered ap ngles et wrap er kiTCHE KITCHE JANITO	n separating ngles with ealed with A Building n 23 31 01. n Section 23 d by MFM Exposed nclosure COMM N EXHAUST N SUPPLY	Double	Wall Duc
	E CLA	SSIFICATION	62.1-20	OCCUPA COUNT 52 007.		PEOPLE OUTDOOR AIR RATE 7.5		2. FT. OF AREA 1300 CONSTR E A A A		TDOOR RATE EQ'D /SQ. FT. 0.18 TOT/ TOT/		CCUPAN NSITY/10 SQ. FT. 70 CQUIRED JPPLIED	FOR GI	COMBIN TDOOI RATE M/PER 10 PU-1 PU-1 PU-1 PU-1					Su All are Du we Te Re Du All Ex All Kit Pic Co NC Re Ins Ins	pply Air low pres eas: cts locat ather: rminal to turn Air I cts locat other re haust Ain general chen hoo oing ndensate fer to spo sulation r sulation r sulation r	Duct Ducts ssure expose ed outdoor Outlet: Ducts ed outside: turn air duc Ducts restroom e od exhaust e Drain (CD ecification in nust meet o	ervice sed ductwo s or in soff twork: xhaust duc ducts: ): All sizes section 23 or exceed F or exceed F or exceed F or exceed A (	rk in pul t expose t expose ts: 07-00 fo BC 2010 BC 2010 BC 2010 SHRAE C SHRAE F-1 SF-1 EF-1 SF-1 EF-3 PU-1 DTAL	blic eed to or more of 0 - Energ 0 - Mech 2 90.1-20 0 - Mech	details an gy Conse hanical Co 10, Table	ternally stalled stalled stalled stalled F stalled F stalled F stalled F stalled F stalled S stalled F stalled S stalled S stalled S stalled F stalled F stalled S stalled S sta	ss R-6 / lined R-6 R-8 R-6 R-4.2 R-4.2 R-4.2 R-4.2 R-4.2 R-4.2 R-4.2 R-4.2 R-4.2 R-4.2 R-4.2 R-4.2 R-4.2 R-4.2 R-4 R-6 R-6 R-6 R-6 R-6 R-6 R-6 R-6	.75# with insua Expo oute Flex- Prod Cond .75# Inter Insul 33 00 Build Cond - 1-1/ Wrag equa Clos 4.1 thro Cond - 1-1/ Wrag equa	density b perforate altion from sed: Rig r weather Clad 400 ucts Corp cealed: .7 density b mal Speci ating duc 0 or Flex ling Prod cealed - 2 2" rigid b cealed - 2 503.2.7 th ugh 604.1	lanket d inner line n air strear id fiberglas proof shee as manufa os. '5# density lanket. fied in Spe ct specifice Clad 400 as ucts Corp. " thick exter oard with o hour fire ra iremaster lastomeric astomeric astomeric	Type er and m ss with c et metal j acturerec / blanket ecificatio ed in Spe s manufa corner al ated duc ess manufa corner al ated duc ess manufa corner al ated duc ess manufa ated duc ated duc ess manufa ated duc ated ated ated ated ated ated ated ated	nylar film corner an jacket sea d by MFM n Section acturered ap ngles et wrap er kiTCHE JANITO NEW PA	n separating ngles with ealed with A Building n 23 31 01. on Section 23 d by MFM Exposed nclosure COMM N EXHAUST N SUPPLY PRS		

Matern Profession 130 Candace Driv Maitland, FI 3275 PHONE (407) 740-5020 THIS DRAWING IS THE PROP ENGINEERING, INC. UNLESS CONTRACT, THE CONTENTS TRANSMITTED TO ANY OTHE BY THE ENGINEER. ENG. BUS. No. EB-000509 OCC CL/ HORS P/ RESTR CONCE BLDG	1-3331 FAX (407) 740-0365 ERTY OF MATERN PROFESSIONAL S OTHERWISE PROVIDED BY THE S OF THIS DRAWING SHALL NOT BE ER PARTY EXCEPT AS AGREED TO
Revisions	
No. Date	Description
1 11/10/14	REVISION #1
Key	Plan
MPE PROJ#:201	3–079
" Designed By:BW	
Drawn By:RN	
Checked By:BW	
Issue Date:	9/05/14
	DULES
	ANICAL
<b>100</b> % CONSTRUC Drawing No.	CTION DOCUMENTS
ME	501

-----

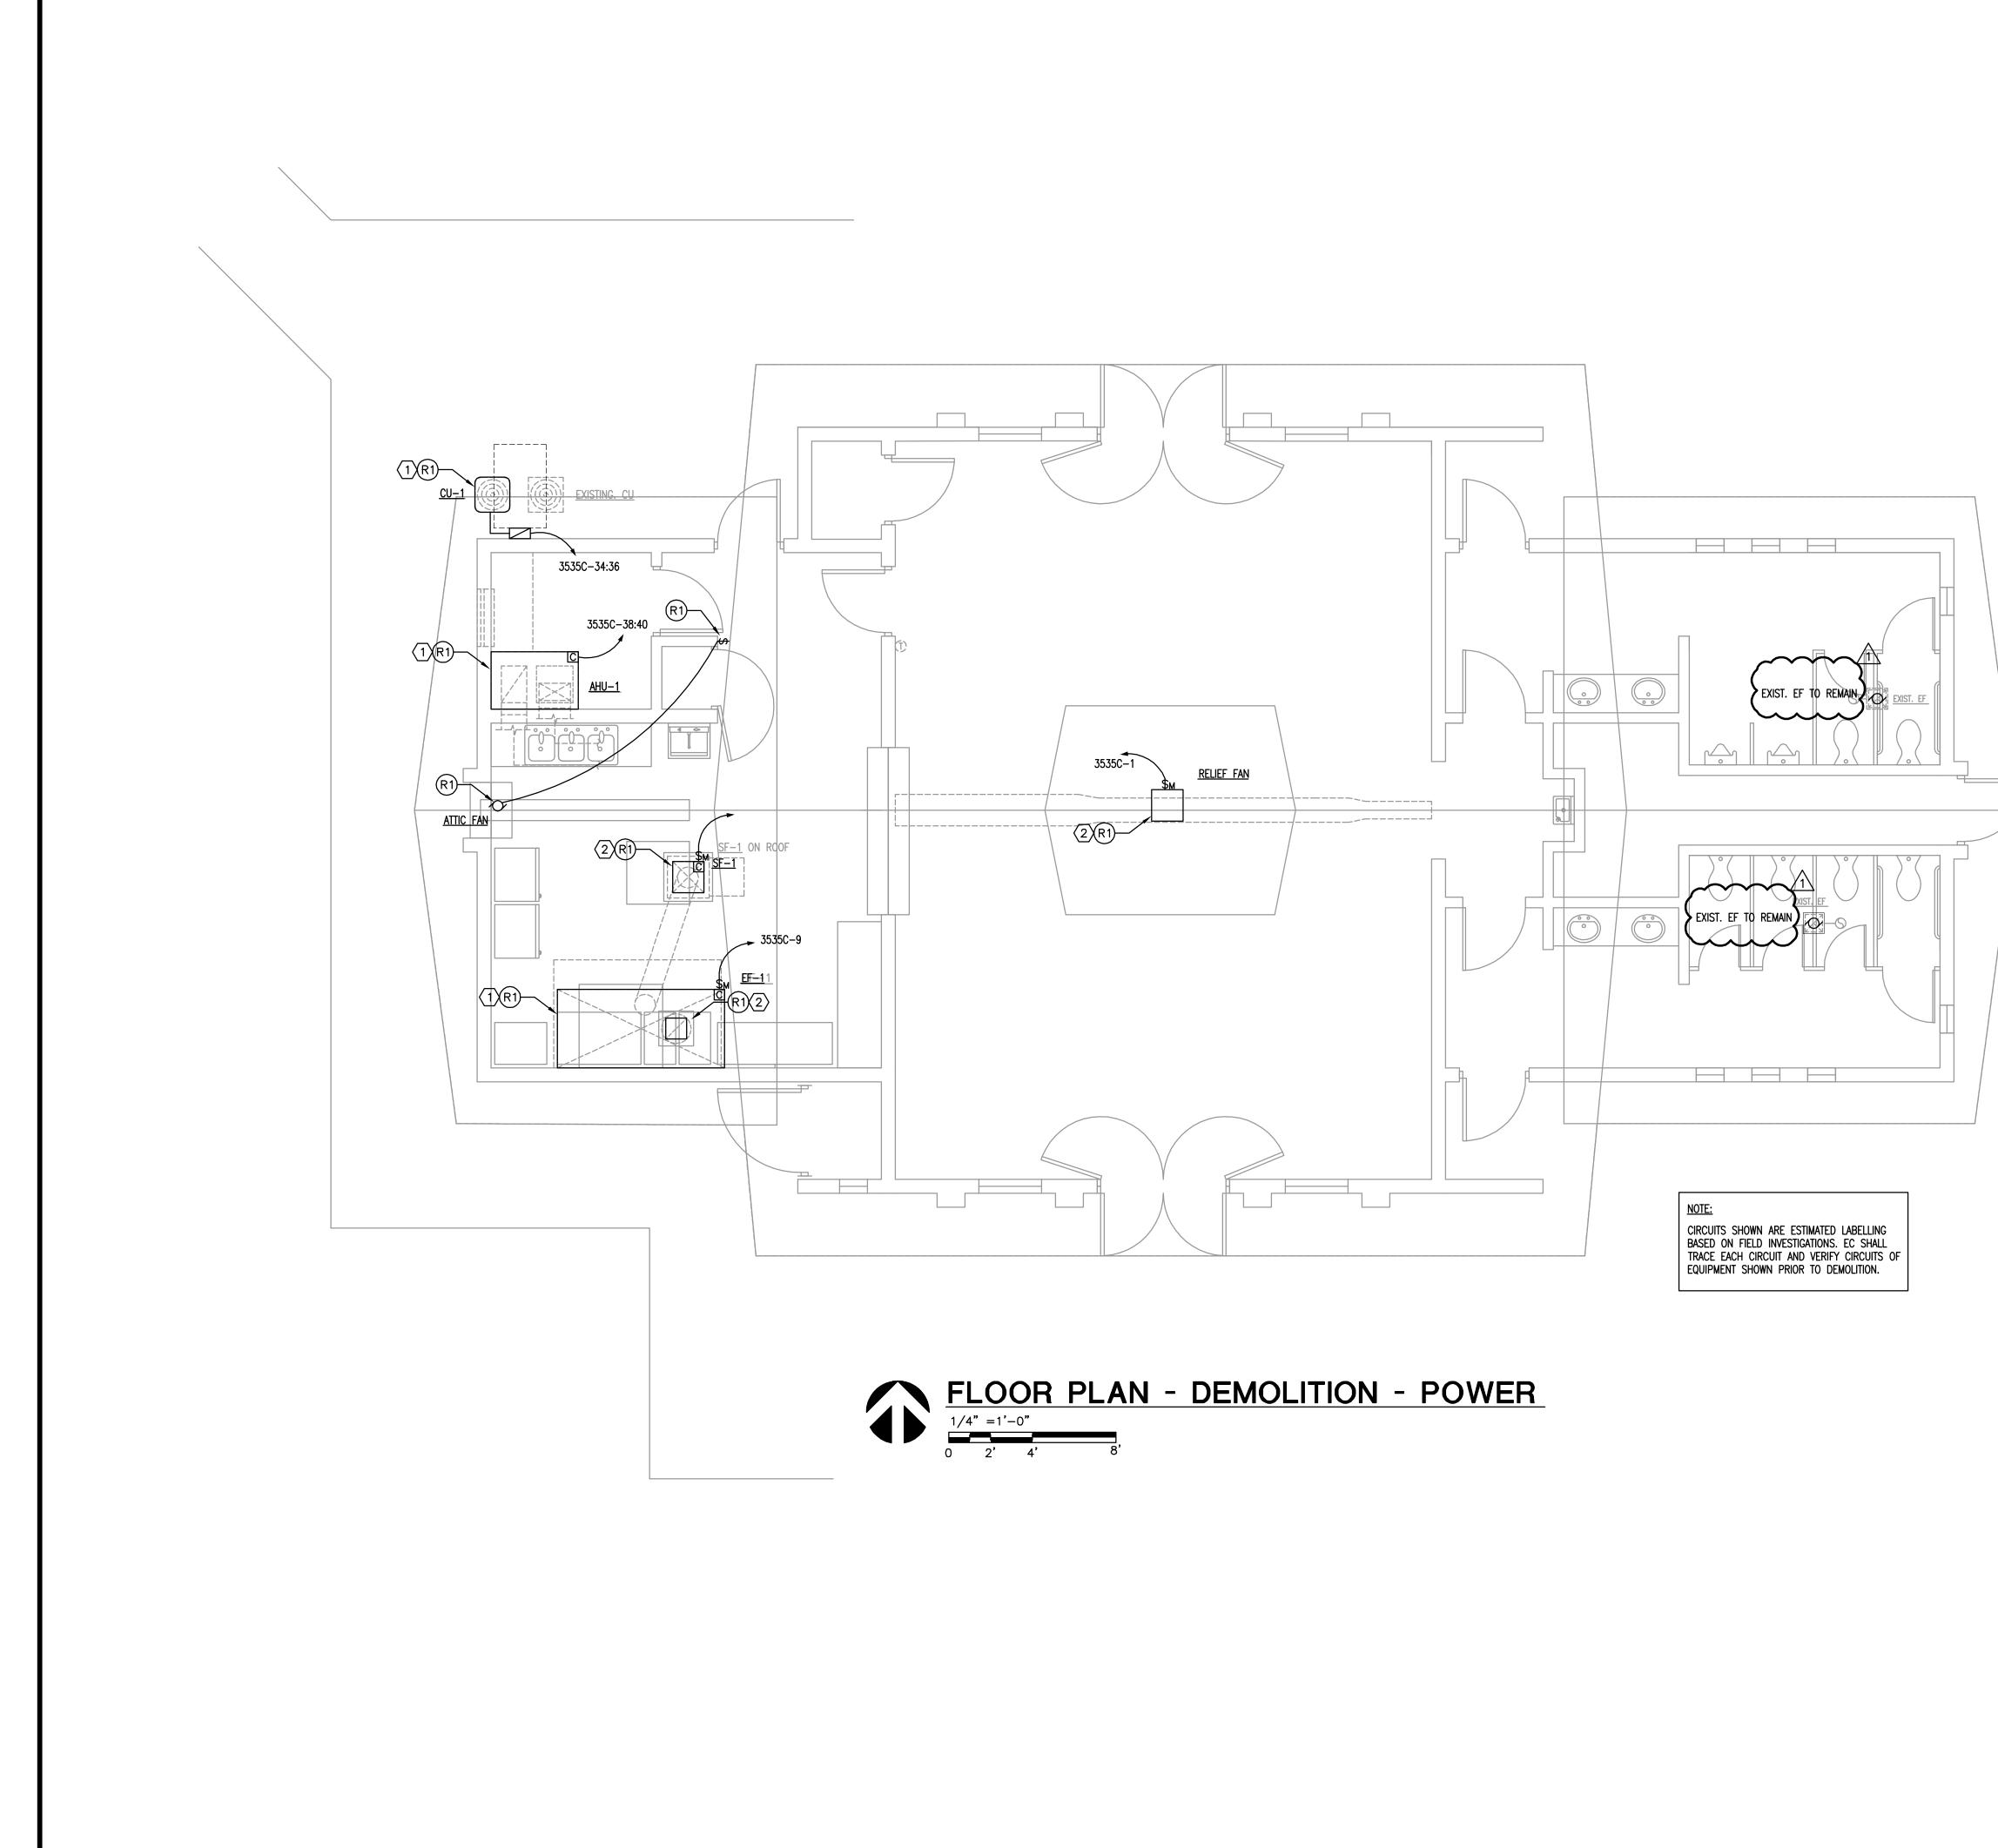

<ul> <li>GENERAL NOTES</li> <li>1) REFER TO GENERAL NOTES FOR THIS DISCIPLINE.</li> <li>2) REFER TO SPECIFICATIONS.</li> <li>3) NO MULTI-WIRE BRANCH CIRCUITS ARE TO BE USED. EACH CIRCUIT IS TO HAVE SEPARATE INDIVIDUAL NEUTRAL.</li> <li>4) ALL HEX NOTES NOT NECESSARILY USED ON ALL SHEETS.</li> <li>5) EXISTING CONDUIT ROUTING IS UNKNOWN.</li> <li>6) WHERE CONDUIT ROUTING IS SHOWN, THE CONDUITS ARE SHOWN FOR DUGRAMMATIC PURPOSES AND ARE NOT NECESSARILY REPRESENTATIVE OF EXACT PLACEMENT.</li> </ul>	<image/> <image/> <image/> <image/> <text><text><text><text><text><text></text></text></text></text></text></text>
HEX. NOTES         1)       MECHANICAL EQUIPMENT TO BE REPLACED. REMOVE ALL ELECTRICAL FOR THIS EQUIPMENT COMPLETE BACK TO ITS SOURCE.         (2)       EXISTING MECHANICAL EQUIPMENT TO BE REMOVED.         (3)       EXISTING CONDUIT RUN MAY BE RE-USED IN RENOVATIONS PROVIDED SIZE AND CONDITION MEETS CODE REQUIREMENTS AND ROUTING IN CONGRUENT WITH NEW CIRCUITING. REFER TO RENO DRAWINGS.	No.       Date       Description         1       11/10/14       REVISION #1         1       11/10/14       Image: state s
	Key Plan         MPE PROJ#: 2013-079         Designed By: RB         Drawn By: AG/RB         Checked By: CT         Issue Date:       9/05/14         Drawing Scale: 1/4"=1'-0"         Drawing Title:         FLOOR PLAN -         DEMOLITION -         POWER
	Drawing No.

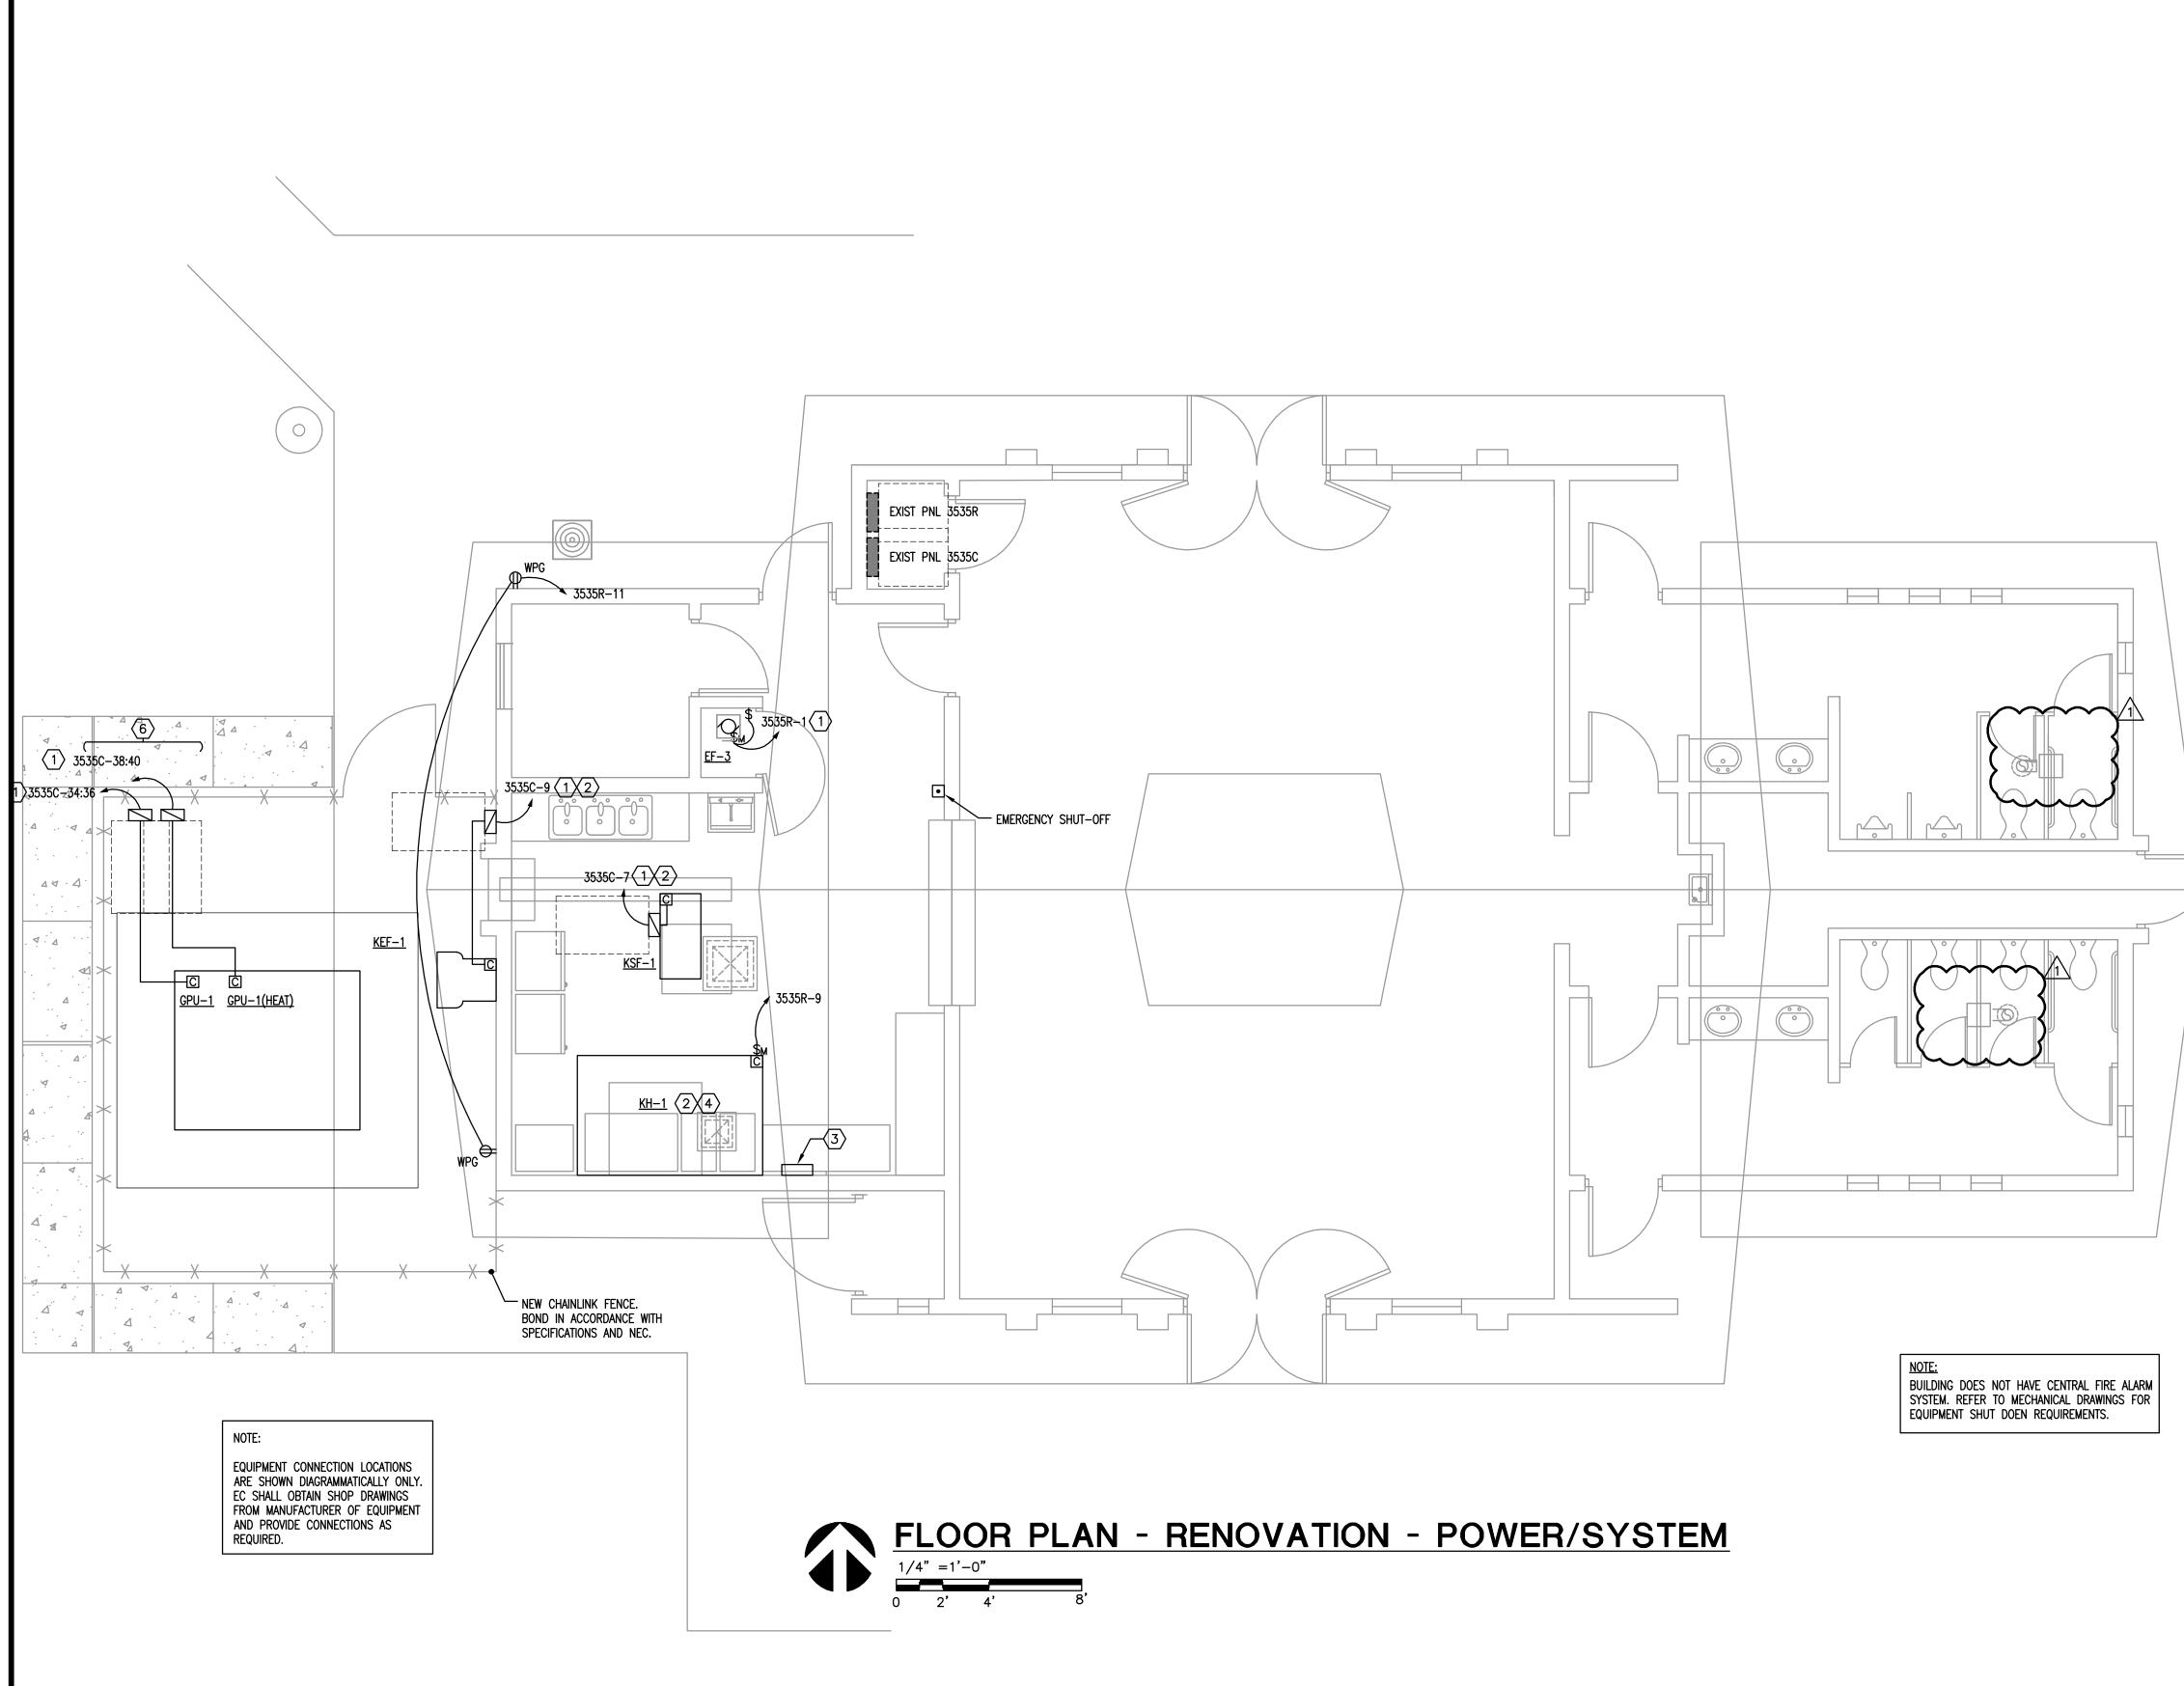

<u>GENE</u>	RAL NOTES	
1)	REFER TO GENERAL NOTES FOR THIS DISCIPLINE.	PROFESSIONAL
2)	REFER TO SPECIFICATIONS.	ENGINEERING MEP/FP Engineering
3)	NO MULTI-WIRE BRANCH CIRCUITS ARE TO BE USED. EACH CIRCUIT IS TO HAVE SEPARATE INDIVIDUAL NEUTRAL.	Consultants - A Solutions Based Firm
4)	REWORK/RELOCATE EXISTING ELECTRICAL AS REQUIRED TO FACILITATE REMODELING.	ORLANDO I Fort Myers I Jacksonville I Tampa
5)	CONTRACTOR SHALL MAINTAIN CONTINUITY TO EXISTING DEVICES REMAINING.	Matern Professional Engineering, Inc 130 Candace Drive Maitland, FI 32751-3331
6)	ALL DISCONNECTING MEANS (SWITCHES) FEEDING FAN TERMINAL BOXES SHALL BE MOTOR RATED SWITCHES.	PHONE (407) 740-5020 FAX (407) 740-0365 THIS DRAWING IS THE PROPERTY OF MATERN PROFESSIONAL ENGINEERING, INC. UNLESS OTHERWISE PROVIDED BY THE CONTRACT, THE CONTENTS OF THIS DRAWING SHALL NOT BE
7)	REFER TO MECHANICAL EQUIPMENT FEEDER AND PANEL SCHEDULES FOR ELECTRICAL REQUIREMENTS FOR MECHANICAL AND PLUMBING EQUIPMENT.	TRANSMITTED TO ANY OTHER PARTY EXCEPT AS AGREED TO BY THE ENGINEER. ENG. BUS. No. EB-0005096 CERT. OF AUTH. No. 5096
8)	MOUNT ALL DISCONNECT SWITCHES FOR MECHANICAL EQUIPMENT WITHIN SIX (6) FEET OF EQUIPMENT AS REQUIRED BY APPLICABLE CODES AND STANDARDS. RELOCATE DISCONNECT SWITCHES SHOWN ON DRAWINGS TO LOCATION REQUIRED TO COMPLY WITH THIS REQUIREMENT AND APPLICABLE CODES/STANDARDS. LOCATIONS FOR DISCONNECT SWITCHES SHOWN ON DRAWINGS IS FOR GENERAL INFORMATION ONLY.	OC CLARCONA HORSEMANS PARK RESTROOMS & CONCESSIONS BLDG HVAC REPLACEMENT
1	<u>K NOTES</u> REFER TO MECHANICAL FEEDER SCHEDULE. CONNECT VIA KITCHEN CONTROL SYSTEM. SEE WIRING DIAGRAM AND OTHER REQUIREMENTS ON KITCHEN HOOD DRAWING.	No.       Date       Description         1       11/10/14       REVISION #1
4) 4)	NEW HOOD CONTROL UNIT. RECONNECT ANY CONTROL POWER AND BUILDING ALARM SYSTEMS TO EXISTING CIRCUITS PREVIOUSLY SERVING EQUIPMENT BEING REPLACED. UPON ACTIVATION OF ANSUL SYSTEM, HOOD SHALL SHUNT POWER TO EQUIPMENT UNDER HOOD. PROVIDE CONNECTIONS TO EXISTING BREAKER SHUNT TRIPS AS REQUIRED. NOT USED.	
<u>_</u> /		
<u>_</u> /		Key Plan
<u>_</u> /		
<u>_</u> /		MPE PROJ#: 2013-079
<u>_</u> /		MPE PROJ#:2013-079 Designed By:RB
<u>_</u> /		MPE PROJ#:2013-079 Designed By:RB Drawn By:AG/RB
<u>_</u> /		MPE PROJ#: 2013-079 Designed By:RB Drawn By:AG/RB Checked By:CT
<u>_</u> /		MPE PROJ#: 2013-079 Designed By:RB Drawn By:AG/RB Checked By:CT Issue Date: 9/05/14
<u>_</u> /		MPE PROJ#: 2013-079 Designed By:RB Drawn By:AG/RB Checked By:CT Issue Date: 9/05/14 Drawing Scale: 1/4"=1'-0"
<u>_</u> /		MPE PROJ#: 2013-079 Designed By:RB Drawn By:AG/RB Checked By:CT Issue Date: 9/05/14
<u>_</u> /		MPE PROJ#: 2013-079 Designed By:RB Drawn By:AG/RB Checked By:CT Issue Date: 9/05/14 Drawing Scale: 1/4"=1'-0" Drawing Title: FLOOR PLAN - RENOVATION -

MOUNTING:     SURFACE     MCB     400       TYPE :     SH.TRIP       MFR :     EATON     GFP   NOTES AND REFERENCE NOTES:	EXISTING :       YES         CTIONS :       1         NEMA 3R :       MOUNTING :         Image: Subscript of the second secon	120       PANEL: 3535R (EXIST)         240       MLO(***)         1       MCB       200         SQ D       GFP	Image: WISED: 10/18/12       EXISTING : YES         SECTIONS :       1         NEMA 3R :	MATERN PROFESSIONA ENGINEERING MEP/FP Engineering Consultants - A Solutions Based Firm
GENERAL NOTES: <aic (**)="" rating="">         (1) ALL C.B.'S FEEDING HVAC EQUIPMENT TO BE HACR TYPE.       SERIES RATED       22       KA(*)         (2) ALL C.B.'S FEEDING ELEV EQUIP TO BE SHUNT-TRIP TYPE.       FULLY RATED       KA       \$ = NEW CB IN EXIST SPACE         (3) ALL C.B.'S FEEDING ELEV EQUIP TO BE SIZED AS REQ'D BY MFR.       (*) NOTE: MAY REQUIRE FULL RATING TO ACHIEVE       SH = SHUNT TRIP C.B.         (4) ALL C.B.'S FEEDING HID LTG TO BE HID RATED.       (*) NOTE: MAY REQUIRE FULL RATING TO ACHIEVE       SH = SHUNT TRIP C.B.         (5) NO MULTIWIRE BRANCH CKTS ARE ALLOWED       (*) NOT USED.       AF = ARC FAULT CB</aic>	(2) ALL C.B.'S FEEDING EI		MFR = SIZE CB PER MFR. RECOMMENDATIONS. \$ = NEW CB IN EXIST SPACE & = REPLACE EXIST CB WITH NEW SH = SHUNT TRIP C.B. AF = ARC FAULT CB	ORLANDO I Fort Myers I Jacksonville I Tampa Matern Professional Engineering, Inc 130 Candace Drive Maitland, FI 32751-3331 PHONE (407) 740-5020 FAX (407) 740-0365
BREAKER SIZE/AIC RATING AS CALLED FOR IN SCHEDULE.	64 KVA 267 AMPS ERROR CODE	54       (***) NOTE: SIZE SHOWN IS MINIMUM ACCEPTABLE MLO         54       AMPERAGE. INCREASE SIZE IF REQUIRED TO ACHIEVE         54       QUANTITY OF POLES OR BREAKER SIZE/AIC RATING AS         CALLED FOR IN SCHEDULE.	OPTIONAL CALCNOACTUAL CONN LOAD13KVA54AMPSDEMAND13KVA54AMPSDIVERSITY13KVA54AMPSTRANSFORMER SIZEKVA54AMPS	THIS DRAWING IS THE PROPERTY OF MATERN PROFESSIONAL ENGINEERING, INC. UNLESS OTHERWISE PROVIDED BY THE CONTRACT, THE CONTENTS OF THIS DRAWING SHALL NOT BE TRANSMITTED TO ANY OTHER PARTY EXCEPT AS AGREED TO BY THE ENGINEER. ENG. BUS. No. EB-0005096 CERT. OF AUTH. No. 5096
$ \begin{array}{ c c c c c c c c c c c c c c c c c c c$	DTH:         20         DEPTH:         5.75           CONN         TYPE         DESCRIPTION           5         4.0         SPACE           12         5.0         WINDOW A/C           12         5.0	LOAD         CONN         TYPE         AMPS         AMPS         C.B. AMPS         C.B. POLE         REF NOTE         CKT. NO.         REF NOTE         C.B. POLE         C.B. AMPS         AMPS         C.B. POLE         C.KT. NO.         REF NOTE         C.B. NOTE         C.B. POLE         C.B. AMPS         AMPS         AMPS           10         5.0         10         20         1         3         4         1         20         10           10         5.0         10         20         2         5         6         11         20         10           10         5.0         10           7         8         1         20	HAND DRYER - MEN'S RM     8     5.0       8     RECEPTS - ASSMBLY RM     8     5.0       LIGHTS - MEN'S RM     10     5.0       8     LIGHTS - ASSEMBLY RM     8     5.0	OC CLARCONA HORSEMANS PARK
HOOD EXHAUST FAN         8         5.0         8         20         1         9         10         1         20         10         110V CURTAIN RIGHT           REFRIGERATOR         12         7.0         12         20         1         11         12         1         20         10         KITCHEN LIGHTS           KITCHEN LIGHTS         120         2.0         10         20         1         13         14         1         20         10         KITCHEN LIGHTS           110V WINDOW LEFT         10         7.0         10         20         1         15         16         1         20         10         110V HOOD LEFT           10E MACHINE         12         7.0         12         20         1         17         18         1         20         10         110V CURTAIN RIGHT           WINDOW A/C         12         5.0         12         20         1         17         18         1         20         8         LIGHTS           110V ORDER CURTAIN LEFT         10         7.0         10         20         1         21         22         1         15         10         110V CURTAIN RIGHT           STORAGE OUTLET         10	10       7.0         1200       2.0         10       7.0         1000       2.0         100       7.0         100       2.0         100       2.0         100       7.0         100       2.0         100       2.0         SPACE	1       9       10       1       20       10         1       1       11       12       1       20       10         1       1       11       12       1       20       10         1       1       11       12       1       20       10         1       1       11       12       1       20       10         1       1       13       14       1       20       8         1       15       16       1       20       8         1       17       18       1       20       8         1       1       19       20       1       20         1       1       21       22       1       1         1       1       23       24       1       1         1       1       25       26       1       1       1	LIGHTS - LADIE'S RM105.08WATER COOLER85.0EXHAUST FAN - ASSEMBLY RM85.010RECEPTS - EQUIPMENT RM105.0LIGHTS - ASSEMBLY RM85.00LIGHTS - EXTERIOR102.0SPACESPACESPACESPACESPACESPACE	RESTROOMS & CONCESSIONS BLDG HVAC REPLACEMENT
SHUNT TRIP       2       5.0       2       20       1       27       28         26          EAST GRILL       32       7.0       32       50       2       29       30       2       20       10       TOASTER          32       7.0       32         31       32         10          SHUNT TRIP       1.5       50       1       33       34       2       35       20       0       CU-1         WEST GRILL       38       7.0       38       60       2       35       36         20            38       7.0       38       60       2       35       36        20           38       7.0       38         37       38       2       60       40           SHUNT TRIP       2       5.0       2       60       1       39       40        40          SPACE       50	26         7.0           10         7.0           20         11.1           20         11.1           40         12.3           40         12.3           SUBFEED LUGS/BREA	1     27     28     1       1     29     30     1       1     29     30     1       1     31     32     1       1     33     34     1       1     35     36     1       1     37     38     1       1     39     40     1	SPACE SUBFEED LUGS/BREAKER	
Image: Second state of the		120	VISED: 10/18/12	
VOLTS PH.:       240       PANEL: 3535C (EXIST.REVISED)         PHASE :       1       MLO(***)       MCB TYPE: LC       SH         MOUNTING :       SURFACE       MCB       400       SH         TYPE :       SH.TRIP       SH.TRIP       SH       SH         MFR :       EATON       GFP       NOTES AND REFERENCE NOTES:	EXISTING : YES       VOLTS PH.:         CTIONS : 1       PHASE :         NEMA 3R :       MOUNTING :	240         PANEL: 3535R (EXIST. REV)           1         MLO(***)           JRFACE         MCB         200           SQ D         SH.TRIP	EXISTING :       YES         SECTIONS :       1         NEMA 3R :	
(1) ALL C.B.'S FEEDING HVAC EQUIPMENT TO BE HACR TYPE.       SERIES RATED       22       KA(*)         (2) ALL C.B.'S FEEDING ELEV EQUIP TO BE SHUNT-TRIP TYPE.       FULLY RATED       KA       \$ = NEW CB IN EXIST SPACE         (3) ALL C.B.'S FEEDING ELEV EQUIP TO BE SIZED AS REQ'D BY MFR.       FULLY RATED       KA       \$ = NEW CB IN EXIST SPACE         (4) ALL C.B.'S FEEDING HID LTG TO BE HID RATED.       (*) NOTE: MAY REQUIRE FULL RATING TO ACHIEVE       SH = SHUNT TRIP C.B.         (5) NO MULTIWIRE BRANCH CKTS ARE ALLOWED       (*) NOT USED.       AF = ARC FAULT CB	(2) ALL C.B.'S FEEDING EI	VAC EQUIPMENT TO BE HACR TYPE.       SERIES RATED       22       KA(*)         LEV EQUIP TO BE SHUNT-TRIP TYPE.       FULLY RATED       KA         LEV EQUIP TO BE SIZED AS REQ'D BY MFR.       (*) NOTE: MAY REQUIRE FULL RATING TO ACHIEVE	MFR = SIZE CB PER MFR. RECOMMENDATIONS. \$ = NEW CB IN EXIST SPACE & = REPLACE EXIST CB WITH NEW SH = SHUNT TRIP C.B. AF = ARC FAULT CB	RevisionsNo.DateDescription111/10/14REVISION #1
TOTAL AMPS B PH       318       INCREASE SIZE IF REQUIRED TO ACHIEVE QUANTITY OF POLES OR BREAKER SIZE/AIC RATING AS CALLED FOR IN SCHEDULE.       DEMAND         INFO CODE:	77         KVA         320         AMPS           KVA         ERROR CODE	63       (***) NOTE: SIZE SHOWN IS MINIMUM ACCEPTABLE MLO         57       AMPERAGE. INCREASE SIZE IF REQUIRED TO ACHIEVE         QUANTITY OF POLES OR BREAKER SIZE/AIC RATING AS         CALLED FOR IN SCHEDULE.	OPTIONAL CALC <u>NO</u> ACTUAL CONN LOAD <u>14</u> KVA <u>60</u> AMPS DEMAND <u>14</u> KVA <u>60</u> AMPS DIVERSITY <u>14</u> KVA <u>60</u> AMPS TRANSFORMER SIZE <u>KVA</u>	
SECTION 1 WITH MAINS         SECTION 1 WITH MAINS         LOAD         Section 1         UTH MAINS         C.B.         C.B.         REF         NOTE         NOTE         REF         NOTE         N	DTH:         20         DEPTH:         5.75           CONN         TYPE           5         4.0           3         4.0           12         5.0           10         7.0           10         7.0           1000         2.0           10         7.0           SPACE         SPACE	LOAD         C.B.         C.B.         REF         CKT.         REF         C.B.         C.B.         AMPS         A	HAND DRYER - MEN'S RM85.08RECEPTS - ASSMBLY RM85.0LIGHTS - MEN'S RM105.08LIGHTS - ASSEMBLY RM85.010LIGHTS - LADIE'S RM105.08WATER COOLER85.02EXHAUST FAN - ASSEMBLY RM85.010RECEPTS - EQUIPMENT RM105.010LIGHTS - ASSEMBLY RM85.010LIGHTS - ASSEMBLY RM85.0	
WINDOW A/C       12       5.0       12       20       1       19       20       1       20       8       LIGHTS         110V ORDER CURTAIN LEFT       10       7.0       10       20       1       21       22       1       15       10       110V CURTAIN RIGHT         STORAGE OUTLET       10       5.0       10       20       1       23       24       1       40       SHUNT TRIP         EXIST LOAD - NO LABEL       10       7.0       10       20       1       25       26       2       40       26       CHARBROIL         SHUNT TRIP       2       5.0       2       20       1       27       28         26          EAST GRILL       32       7.0       32       50       2       29       30       2       20       10          10       1         10       1         10       1         10       1          10       1         10       1	1000       2.0         10       7.0         5.0       SPACE         26       7.0         26       7.0         10       7.0         10       7.0         67       11.1         67       11.1         42       12.3	1     19     20     1     20       1     21     22     1     1       1     23     24     1     1       1     25     26     1     1       1     27     28     1     1       1     29     30     1     1       1     31     32     1     1       1     33     34     1     1	0     LIGHTS - EXTERIOR     10     2.0       SPACE         SPACE        SPACE        SPACE        SPACE        SPACE        O        SPACE        SPACE        SPACE        SPACE	
SHUNT TRIP       2       5.0       2       60       1       39       40        42        42         SPACE       1       41       42       1       1       59       50       50       39     40       41     42       KER	SUBFEED LUGS/BREAKER	
EQUIPMENT DESCRIPTION       VOLTS       PH       Y/N       HP       FLA       LRA       FLA       LRA       KW       AMPS       AMPS       FLA       (10)       (10)         GPU-1       240       1       N       1.00       8.0       48.0       22       168       37.7       240.0       67       67       67	IT COPYRIGHT ME, LLC Version : W8 CP PANEL CB (5) CODE SIZE (1) FUSE (2) TYPE (3) CODE TYPE	REVISED: 10-30-2013       DATE: November 10, 2         WIRE PER       NEUTRAL       GROUND       WIRE       # OF       CONDUIT       % VD       NOTES         PHASE (6)       WIRE (7)       WIRE       WIRE       # OF       CONDUIT       % VD       NOTES         #3       #8       COPPER       1       1.00       0.68       E		Key Plan MPE PROJ#:2013-079 Designed By:RB
GPU-1 (HEAT)       240       1       N       -       -       -       10.0       41.7       42       -       -         KEF-1       120       1       Y       0.75       13.8       82.8       -       -       0     60     1     60     NF       35	#6       #10       COPPER       1       0.75       0.78         #12       #12       #12       COPPER       1       0.75       1.20         #12       #12       #12       COPPER       1       0.75       1.20       E         #12       #12       #12       COPPER       1       0.75       1.20       E         #12       #12       #12       COPPER       1       0.75       1.20         #12       #12       #12       COPPER       1       0.75       1.20         #112       #12       #12       COPPER       1       0.75       0.45         #10       #10       #10       COPPER       1       0.75       1.32	PER NEC, THE EXISTING 400A SERVICE IS ADEQUATE TO HANDLE AN INCREASE IN LOAD OF 70A. THE MAXIMUM MONTHLY DEMAND BEING ONLY 22KW (92A). 92A X 125% = 115A	Drawn By:AG/RB Checked By:CT Issue Date: 9/05/1
NOTES ( ) (1) PROVIDE DISC SW AT ALL PIECES OF EQUIPMENT AS REQUIRED BY THE N.E.C. AND AHJ UNLESS PROVIDED BY OTHERS (INCLUDING AT MOTORS AND AT STARTERS. (2) FUSES SHOWN FOR REFERENCE ONLY, PROVIDE FUSES AS RECOMMENDED BY EQUIPMENT MANUFACTURER. (3) PROVIDE NEMA OUTDOOR BATED ENCLOSURES FOR ALL DISC SWS MOUNTED OUTDOORS	MCP = MOTOR CIRCUIT PROTECTOR W/COMBINATION STARTER MMS = MANUAL MOTOR STARTER SWITCH WITH OVERLOADS AND PILOT LIGHT		115A + 70A = 185A	Drawing Scale: NO SCALE Drawing Title: ELECTRICAL
<ul> <li>(3) PROVIDE NEMA OUTDOOR RATED ENCLOSURES FOR ALL DISC SWS MOUNTED OUTDOORS.</li> <li>(4) COORDINATE STARTER TYPE WITH MECH EQUIP INSTALLER .</li> <li>(5) CONTRACTOR TO VERIFY THAT C.B. FOR COMPRESSORS IS SUFFICIENT TO ALLOW STARTING OF UNIT, IF REQUIRED FOR STARTING C.B. TO BE INCREASED TO A MAX ALLOWED BY N.E.C. CB TO BE HACR RATED.</li> <li>(6) #12 FEEDERS SHOWN AND OVER 50FT. LONG TO BE #10 FOR 120V CIRCUITS. #12 FEEDERS SHOWN AND OVER 100 FT. LONG TO BE #10 FOR 277 V CIRCUITS.</li> <li>(7) NEUTRAL CONDUCTOR TO BE SAME SIZE AS PHASE CONDUCTORS.</li> <li>(8) MOTOR CB IS SIZED BASED ON NEMA CODE 'F' OR HIGHER. CHANGE CB SIZE IF REQUIRED DUE TO NEMA CODE OF MOTOR PER N.E.C.</li> </ul>	I =NEMA I ENCLOSURE3R =NEMA 3R ENCLOSURE4SS =NEMA 4 WATER TIGHT STAINLESS STEEL ENCLOSURE4 =NEMA 4 WATER TIGHT NON-CORROSIVE ENCLOSUREVFD/AFD =VARIABLE (ADJUSTABLE-AFD) FREQ DRIVE UNITNF =NON-FUSED. WHERE ACCEPTABLE TO AHJ, CONTRACTOR MAY USE PROPERLY RATED MOTOR SWITCH FOR DISCONNECT SWITCH	<ul> <li>(D)=CONNECT VIA COMBINATION DISC/STARTER BY DIV. 15/23 CONTRACTOR.</li> <li>(E)=CONNECT VIA DISC SWITCH AT EQUIP. BY DIV. 15/23 CONTRACTOR.</li> <li>(F)=PROVIDE FULL SIZE NEUTRAL.</li> <li>(G)=MMS WITHOUT OVERLOADS.</li> <li>(H)=CONNECT VIA STARTER IN MCC (BY DIV 16/26).</li> <li>(I)=2 SPEED,1 WINDING MOTOR/STARTER.</li> </ul>		SCHEDULES
(9) ALL FEEDERS 100 AMP AND LESS ARE BASED ON 60 DEGREE CONDUCTOR/TERMINATION RATING. ALL OTHER FEEDERS ARE BASED ON 75 DEGREE CONDUCTOR TERMINATIONS. PROVIDE AND INSTALL PROPER TERMINATIONS ON ALL EQUIPMENT PROVIDED BY ANY DIVISION AND/OR SECTION OF THE CONTRACT DOCUMENTS. PROPER TERMINATIONS TO BE AS REQUIRED TO MATCH CONDUCTOR WITH REQUIRED AMPACITY. (10) BASED ON MANUFACTURER'S RECOMMENDATION. (11) OR BRANCH CIRCUIT SELECTION CURRENT WHEN AVAILABLE.	AHJ = AUTHORITY HAVING JURISDICTION. FNVR = FULL VOLTAGE NON-REVERSING DFNVR = DUAL VOLTAGE NON-REVERSING FVC = FULL VOLTAGE CONTACTOR	(J)=COORDINATE WITH DIV.15 TO BALANCE LOAD OF 1 PHASE FTB MOTORS. (K)=PROVIDE NEW STARTER IN MCC TO MATCH EXISTING. SEE MCC SCHED. (L)=WHERE MOTOR IS FED FROM MCC, PANEL CB NOT REQUIRED (M)=CONNECT EXIST DISC SWITCH AT MOTOR. MODIFY AS NOTED ON DRWGS (N)=CONNECT EXIST DISC SWITCH AT MOTOR. MODIFY AS NOTED ON DRWGS		100 % CONSTRUCTION DOCUMENTS Drawing No. $E501$

⁽P)=