

April 10, 2019
BOARD OF COUNTY COMMISSIONERS
ORANGE COUNTY, FLORIDA
ADDENDUM NO. 2 / IFB NO. Y19-747-RC
ORANGE COUNTY SHERIFF'S OFFICE COC IT SERVICES AREA REMODEL

THE REVISED BID OPENING DATE IS: April 18, 2019

This addendum is hereby incorporated into the bid documents of the project referenced above. The following items are clarifications, corrections, additions, deletions and/or revisions to, and shall take precedence over, the original documents. Underlining indicates additions, deletions are indicated by ~~strikethrough~~.

A. **The bid opening date has been revised from ~~April 16, 2019~~ to April 18, 2019 at 2:00 P.M.**

B. Additions, Deletions and Clarifications

1. **Question:** Sheets A110 and A111 have no keynotes for the extent of demolition and replacement of ACT ceiling system. Can you provide?

Answer: See attached revised A110 sheet.

C. ACKNOWLEDGEMENT OF ADDENDA


- a. The Bidder/Proposer shall acknowledge receipt of this addendum by completing the applicable section in the solicitation or by completion of the acknowledgement information on the addendum. Either form of acknowledgement must be completed and returned not later than the date and time for receipt of the bid or proposal.
- b. All other terms and conditions of the IFB remain the same.
- c. **Receipt acknowledged by:**

Authorized Signature

Date Signed

Title

Name of Firm

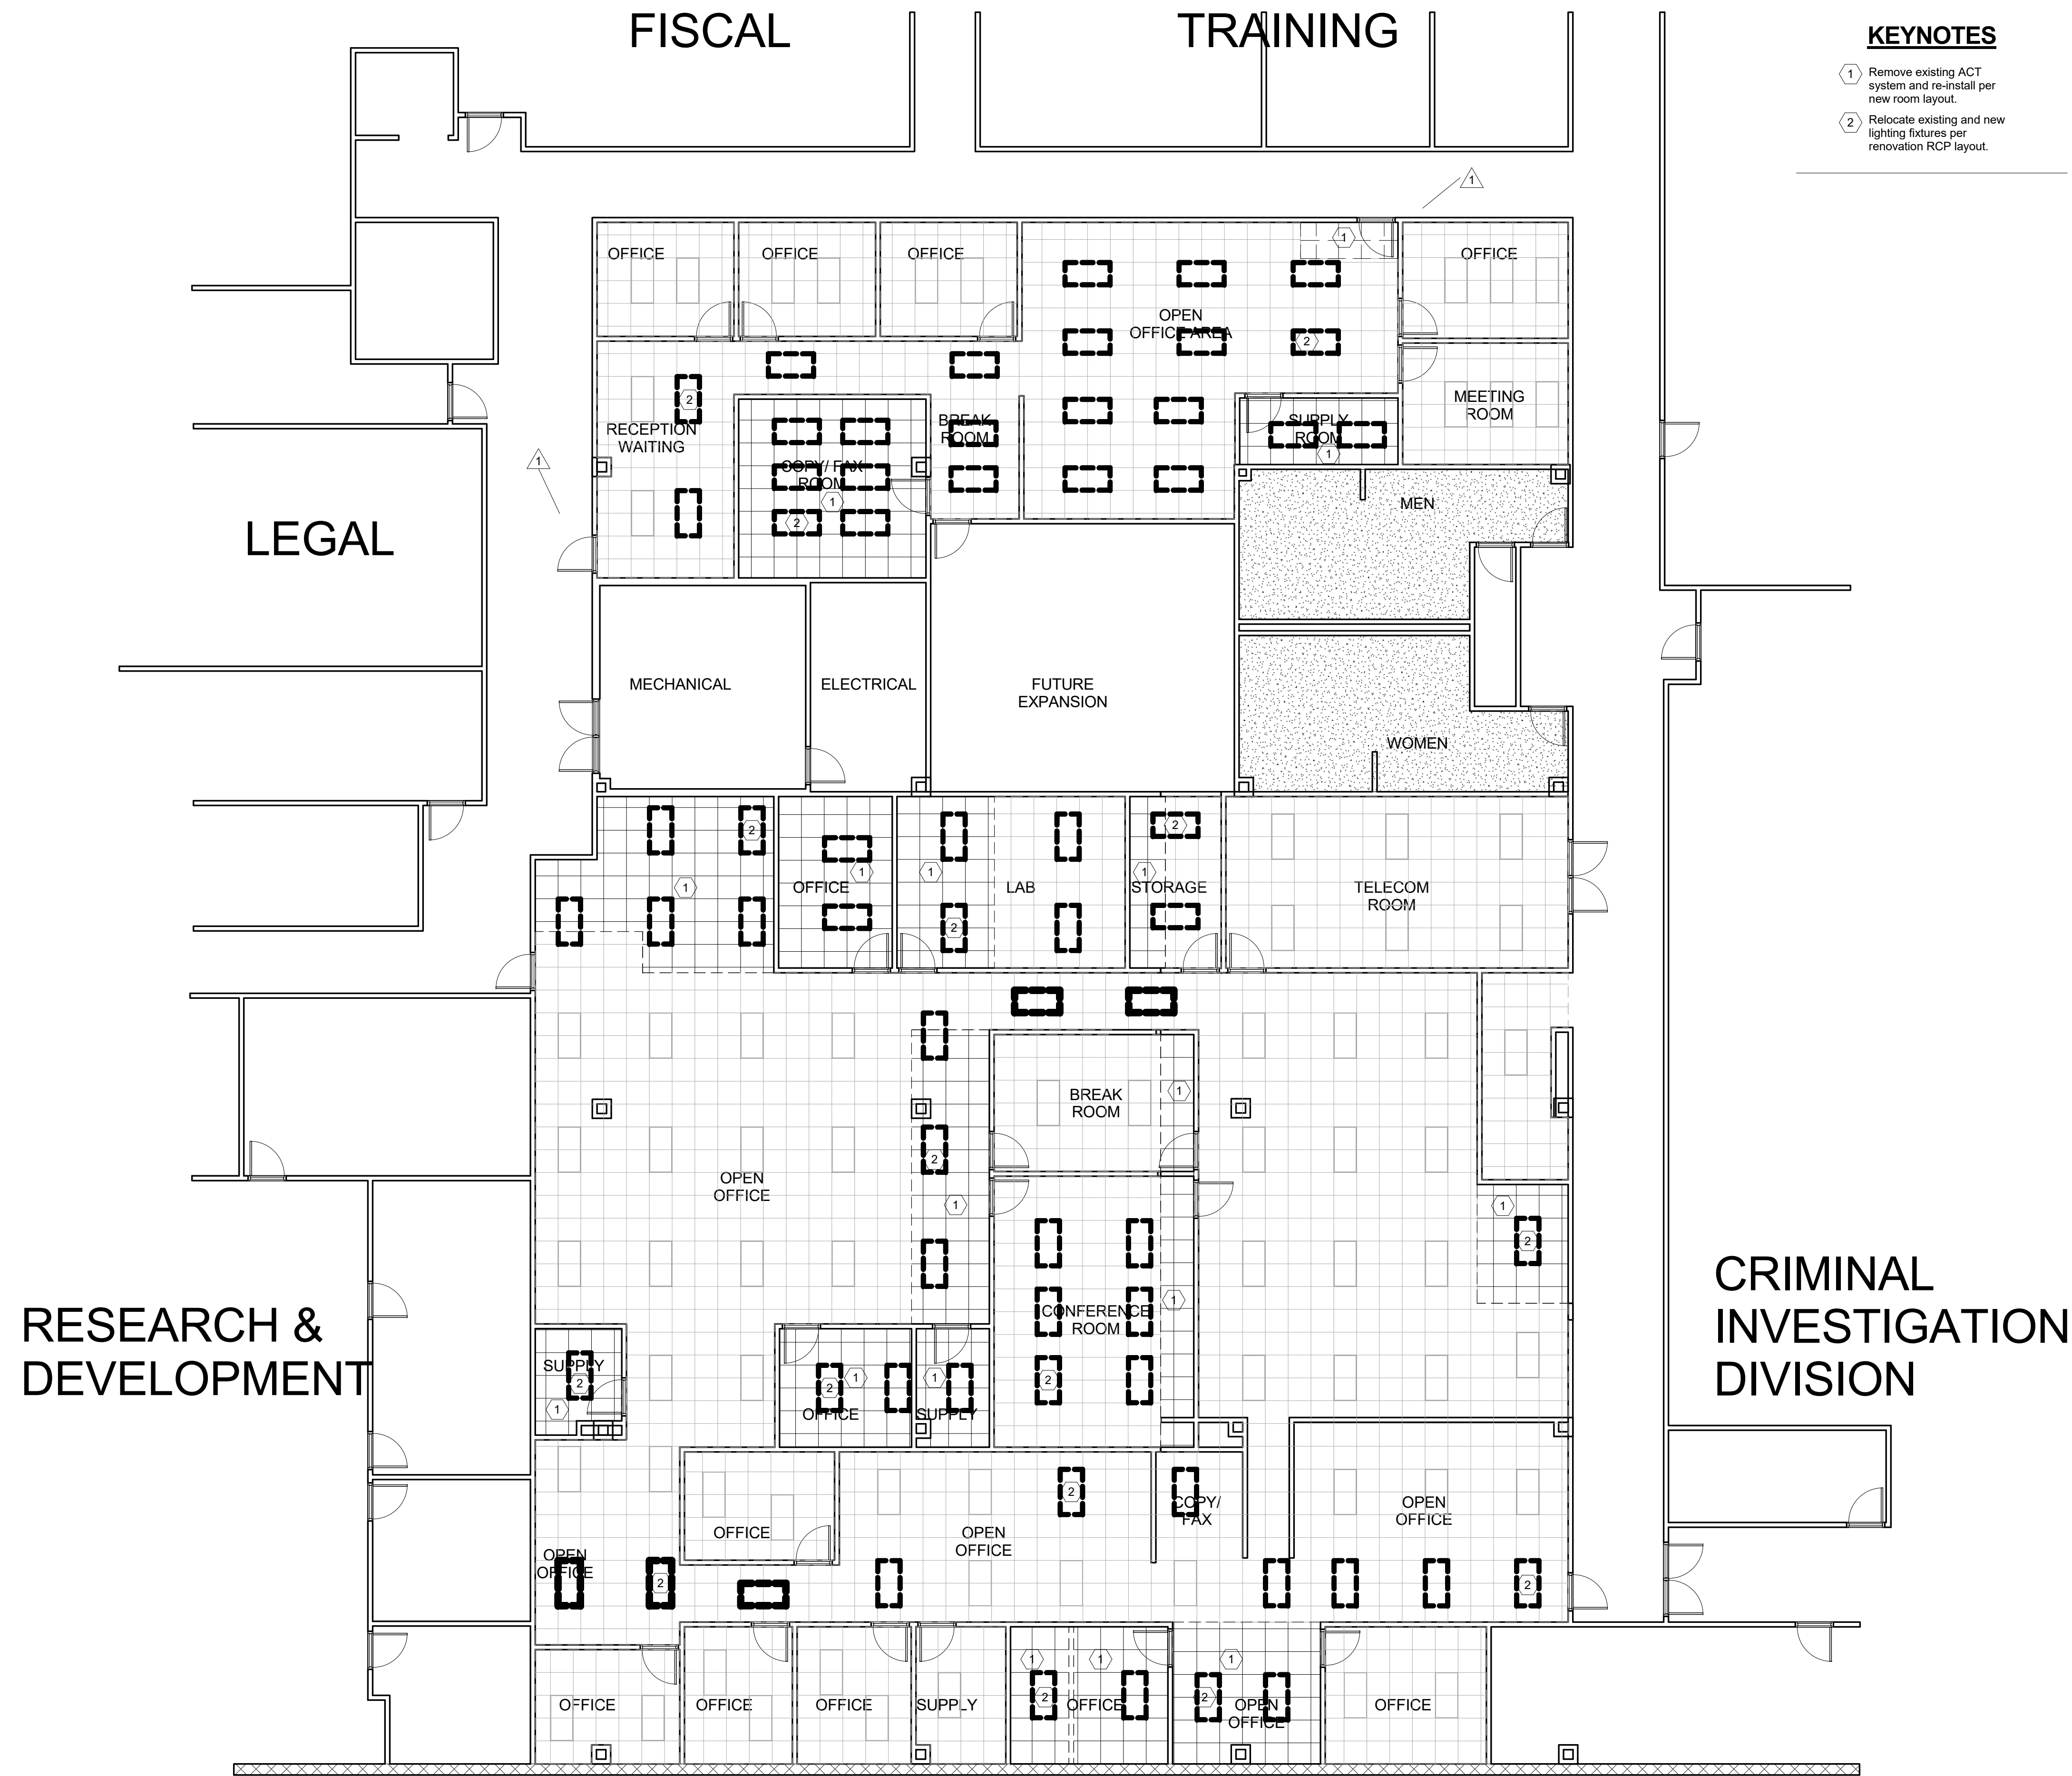

- KEYNOTES**
- 1 Remove existing ACT system and re-install per new room layout.
 - 2 Relocate existing and new lighting fixtures per renovation RCP layout.

WALL LEGEND
 WALL TO BE REMOVED
 EXISTING WALL
 NEW WALL

OC SHERIFF'S OFFICE IT SERVICES RENOVATION

PROJECT No. 17-147	DATE 12.12.18	REV. 1	DESCRIPTION Permit	PROJECT ADDRESS 2500 West Colonial Dr Orlando, Florida	SHEET TITLE DEMO REFLECTED CEILING PLAN	CONSULTANTS BORRELLI + PARTNERS ARCHITECTURE PLANNING LANDSCAPE INTERIORS AND DESIGN 720 Vassar Street, Orlando, FL 32804 407.418.1338 :: fax 407.418.1342	SIGNATURE AND DATED SEAL
PHASE 100% CONSTRUCTION DOCUMENTS	SCALE As indicated	DRAWN BY RP	CHECKED BY JLM	OWNER NAME AND ADDRESS Orange County Sheriff's Office			ALFONSO AVILA, JR. LIC # AR 0017222
DATE 10.4.18							