

August 28, 2018
BOARD OF COUNTY COMMISSIONERS
ORANGE COUNTY, FLORIDA
Addendum No. 2, IFB Y18-789-EB
BARBER PARK PLAYGROUND IMPROVEMENTS

New Bid Opening Date: September 6, 2018

This addendum is hereby incorporated into the bid documents of the project referenced above. The following items are clarifications, corrections, additions, deletions and/or revisions to, and shall take precedence over, the original documents. Underlining indicates additions, deletions are indicated by ~~strike through~~.

A. The new bid opening date is September 6, 2018 at 2:00 P.M.

B. Additions, Revisions, Deletions, Clarifications, Questions and Answers:

- 1. Question:** On sheet C.5 of the revised drawings, there is a detail in the top right corner that seems to be missing a layer. Please provide the full detail for bidding purposes. **Answer:** The detail has been amended and revised sheet C.5 is included with this Addendum.
- 2. Question** There is no detail concerning the edge of new concrete surfaces where it will meet the new pour-in-place surfacing. Will new concrete have turn-down edges where it meets new pour-in-place surfacing? **Answer:**The detail on the revised sheet C.5 shows and calls out the turned down edge.
- 3. Question:** On sheet C.5 of the revised drawings, the Safety Surface/Footing Fill Detail calls for #89 granite stone as a sub-base for the new pour-in-place surfacing. This type of granite stone is typically difficult to find in Florida. Will any alternate sub-base material be acceptable for the project? **Answer:** No substitutions will be allowed. #89 Granite shall be utilized as the aggregate base as shown on the plans and specifications.
- 4. Question:** On sheet P.3 of the revised drawings, the bottom right corner has a note detailing three manufacturers as the basis of design (Landscape Structures, Little Tykes Commercial, and Playmore Recreational). Will any alternate manufacturers of play equipment be accepted? **Answer:** No.
- 5. Question:** On sheet P.2, left hand side under Surfacing it states 2,124 SF of Poured In Place Rubber. That is in conflict with the Note on Sheet C.5 that states that area is 3,125 SF of Poured in Place. 1,000 SF difference could have a large impact on the project and quotes. Will you please help clarify which is correct for construction 2,124,SF or 3,125,SF ? **Answer:** For clarification the approximate quantity is 3,125 square feet. However as this is a lump sum project, square footage shall not be dictated by a note on the documents.

6. **Question:** Can Miracle Playgrounds be a substitute for what was spec out here?

Answer: No, three manufacturers have been specified.

7. **Question:** Can NoFault do the PIP rubber surface? **Answer:** Yes, refer to the contract documents.

C. ACKNOWLEDGEMENT OF ADDENDA

- a. The Bidder/Proposer shall acknowledge receipt of this addendum by completing the applicable section in the solicitation or by completion of the acknowledgement information on the addendum. Either form of acknowledgement must be completed and returned not later than the date and time for receipt of the bid or proposal.
- b. All other terms and conditions of the IFB remain the same.
- c. **Receipt acknowledged by:**

Authorized Signature

Date Signed

Title



Name of Firm

S:\ACTIVE PROJECT FILES\170033_BARBER PARK SPLASH PAD_ORLANDO\CADD\DWG\LAYOUTS\170033_DEMO-GRADING-PLAYGROUND.DWG


NOTES:

- CONTRACTOR SHALL VERIFY ACTUAL FIELD CONDITIONS UPON REMOVAL OF POURED IN PLACE SAFETY SURFACE INCLUDING, BUT NOT LIMITED TO, EXISTING DRAIN PIPE INVERT ELEVATIONS, FINISH SURFACE GRADES OF EXISTING POURED IN PLACE CONCRETE BASE, AND TOPS OF EXISTING FOOTINGS TO REMAIN. CONTRACTOR SHALL VERIFY ACTUAL FIELD CONDITIONS UPON REMOVAL OF POURED IN PLACE SAFETY SURFACE INCLUDING, BUT NOT LIMITED TO, EXISTING DRAIN PIPE INVERT ELEVATIONS, FINISH SURFACE GRADES OF EXISTING POURED IN PLACE CONCRETE BASE, AND TOPS OF EXISTING FOOTINGS TO REMAIN.
- LOCATION AND GRADES OF THE EXISTING DRAIN PIPES ARE APPROXIMATE.
- FINAL UNDERDRAIN & YARD DRAIN LOCATIONS TO BE MARKED ON SITE BY CONTRACTOR FOR REVIEW AND APPROVAL BY COUNTY PRIOR TO CONSTRUCTION.
- FINAL DRAIN PIPE INVERT ELEVATIONS ARE TO BE REVIEWED AND APPROVED IN THE FIELD BY THE COUNTY PRIOR TO POURING THE CONCRETE WALKWAY SURROUNDING THE PLAYGROUND.
- LOCATION AND GRADES OF THE EXISTING DRAIN PIPES ARE APPROXIMATE.
- ALL DRAIN PIPES TO BE CONSTRUCTED TO HAVE A POSITIVE SLOPE TOWARDS THE OUTLET.
- ANY DAMAGE TO EXISTING DRAINAGE PIPES (TO REMAIN) IS TO BE REPAIRED AT CONTRACTOR'S EXPENSE.


- ANY DRAINAGE PIPE RELOCATION IS TO BE COORDINATED WITH THE PLAYGROUND AND SHADE STRUCTURE INSTALLERS.
- DRAINAGE PIPE INSTALLATION TO BE FIELD DOCUMENTED WITH DIGITAL PHOTOGRAPHS. PHOTOGRAPHS TO BE DELIVERED TO COUNTY PRIOR TO POURING CONCRETE WALKWAY AND FOOTINGS.
- MAXIMUM SLOPE OF THE POURED IN PLACE SAFETY SURFACE (EDPM) TO BE 2%.
- MAXIMUM SLOPE OF THE CONCRETE WALKWAY SURROUNDING THE PLAYGROUND TO BE 2%.
- CONTRACTOR TO SUBMIT A CONCRETE JOINT LAYOUT PLAN FOR APPROVAL BY COUNTY PRIOR TO POURING CONCRETE WALKWAYS. ALL SAW CUTS SHALL BE WET CUT.
- SUBGRADE AT DRAIN SHALL BE INSPECTED PRIOR TO AGGREGATE BASE INSTALLATION.

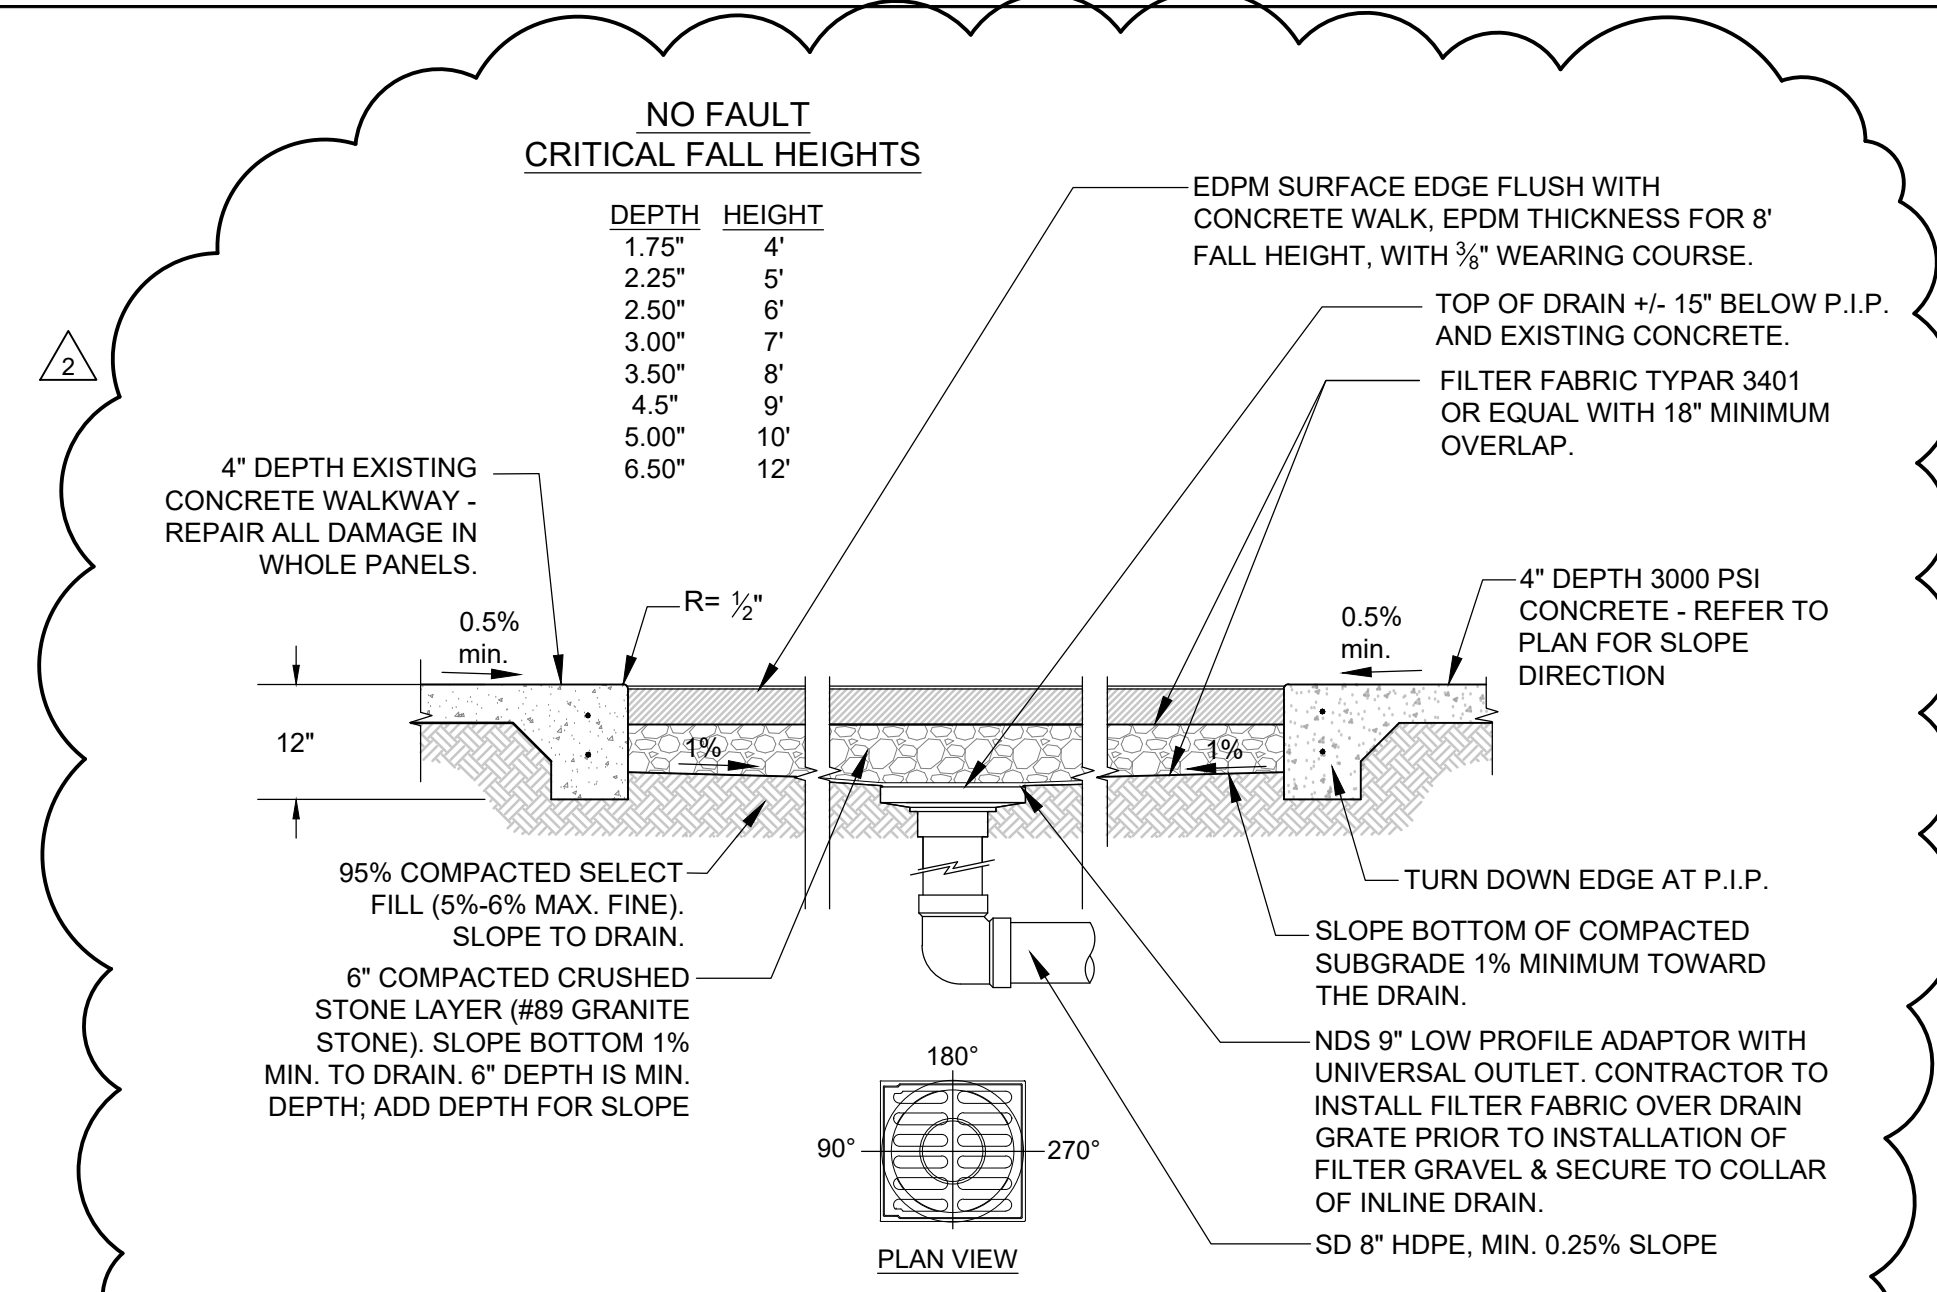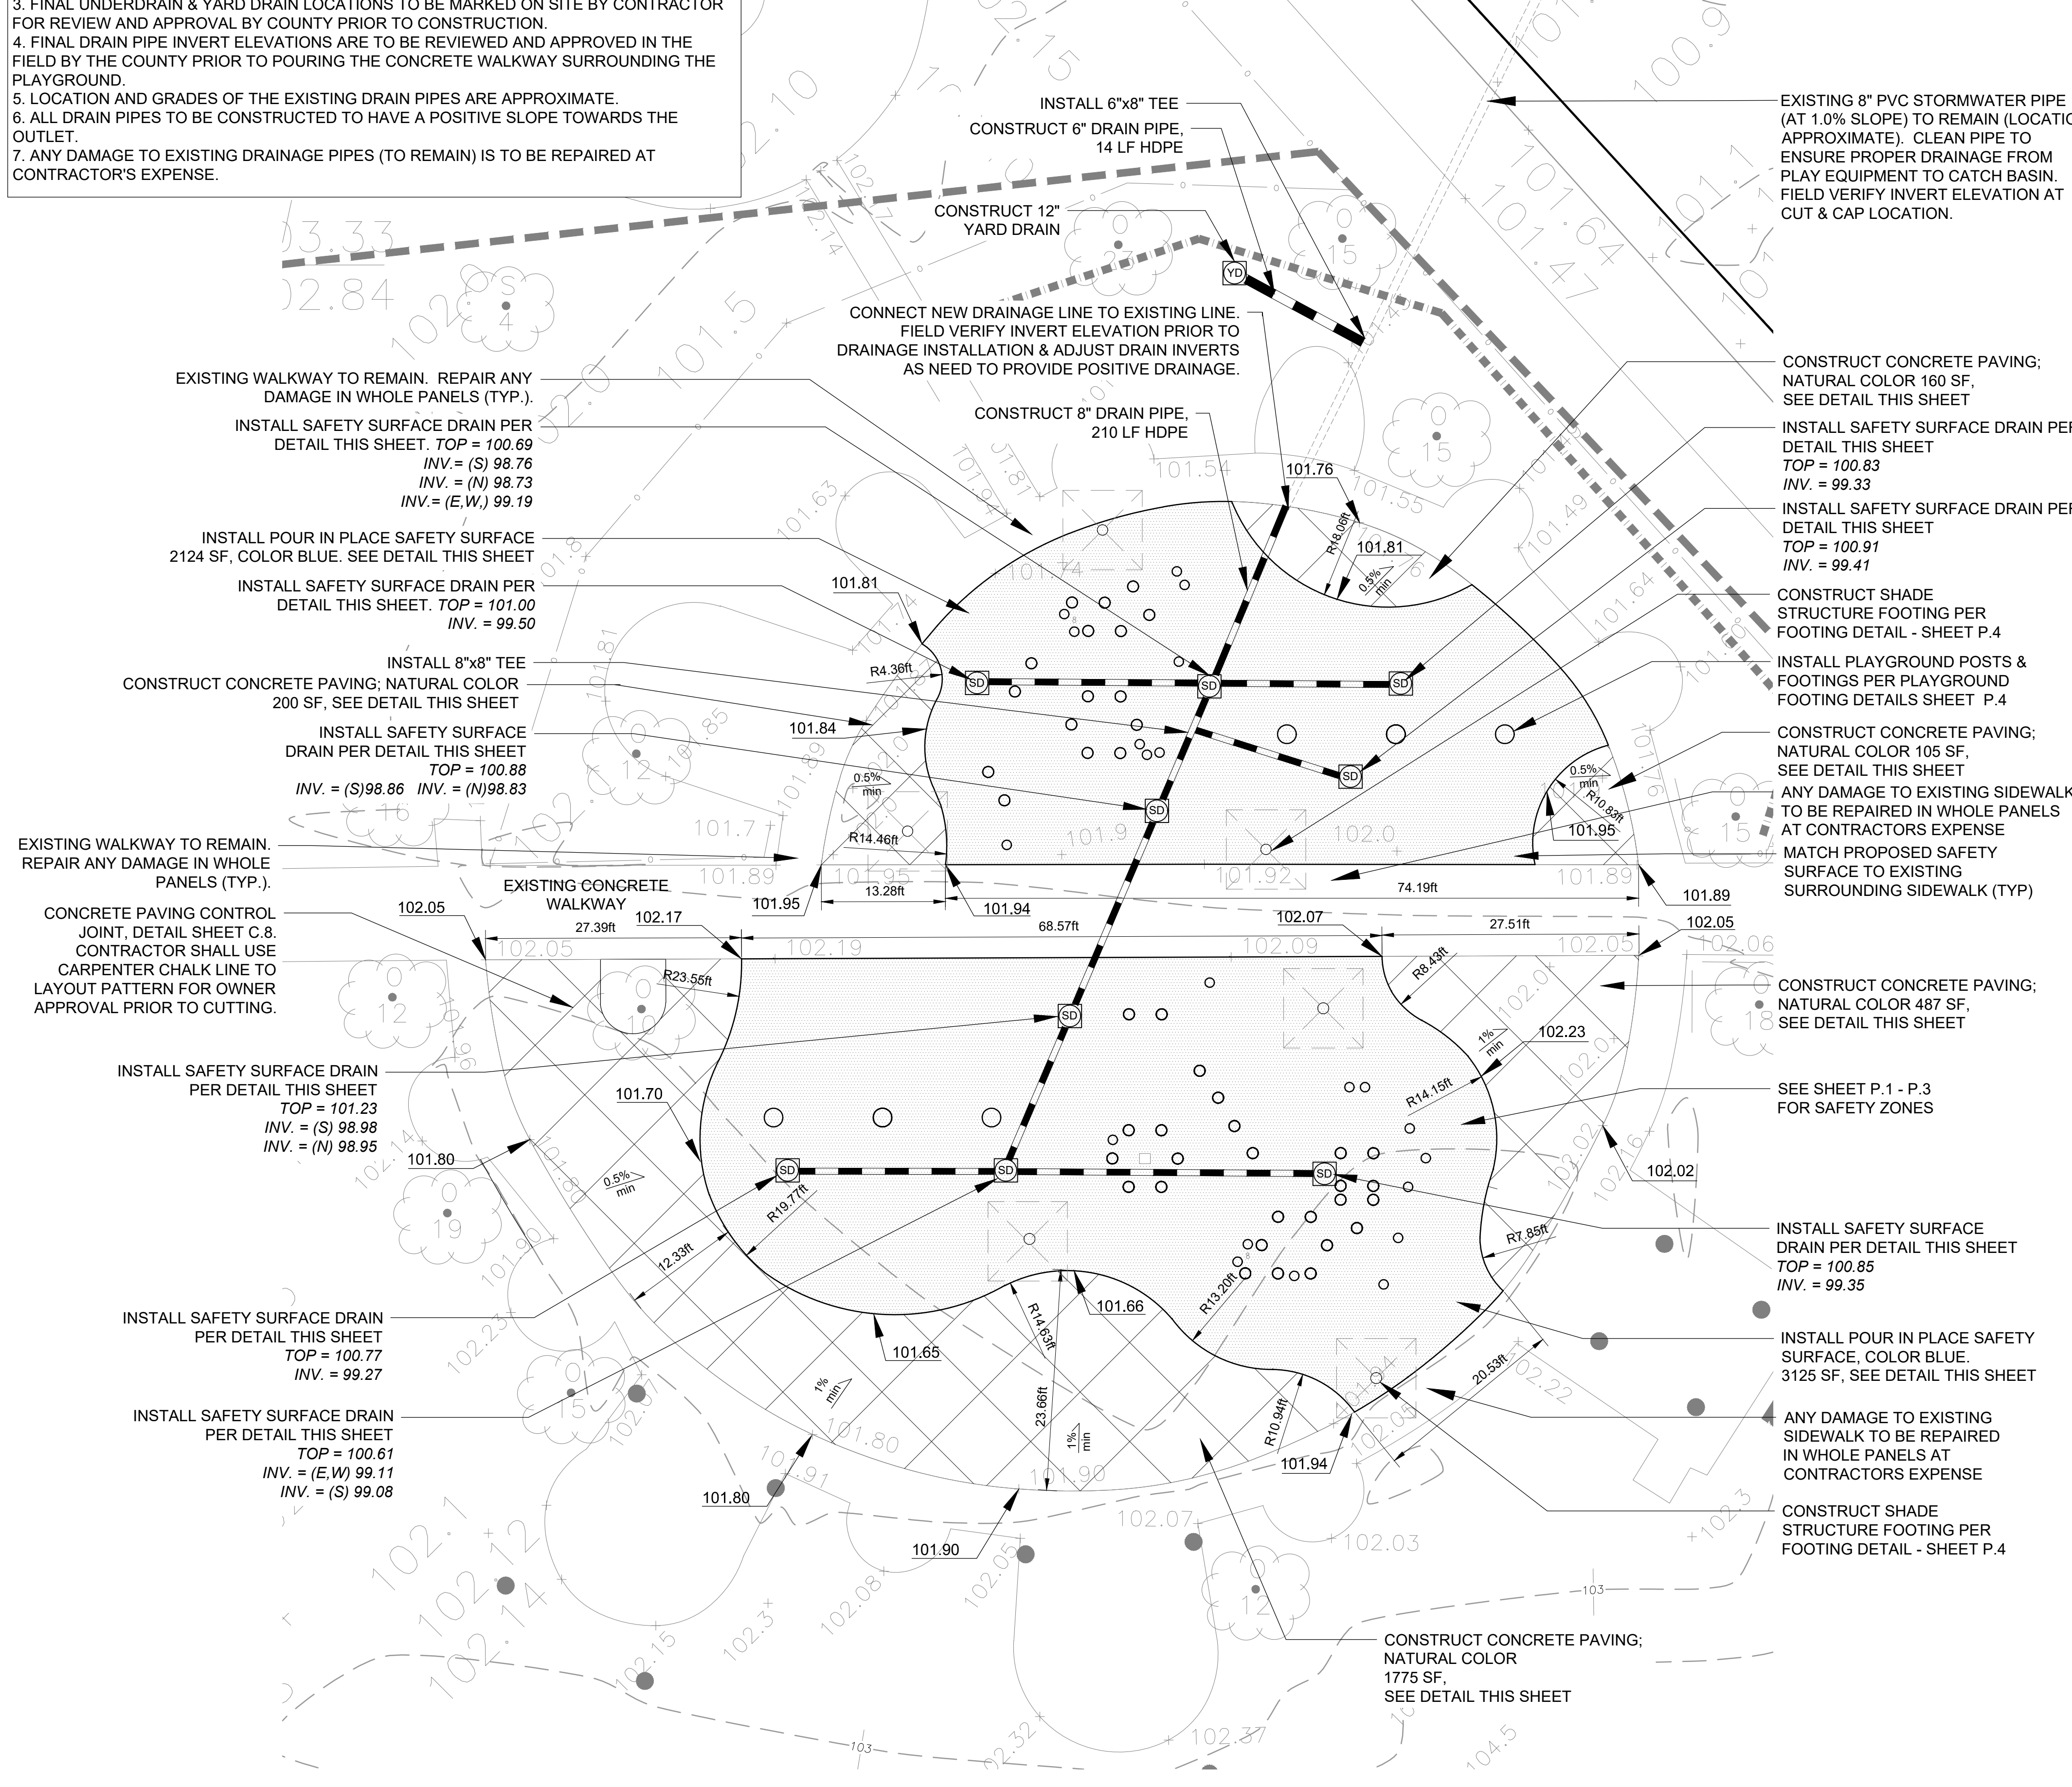



SAFETY SURFACE DRAINAGE DETAIL NTS

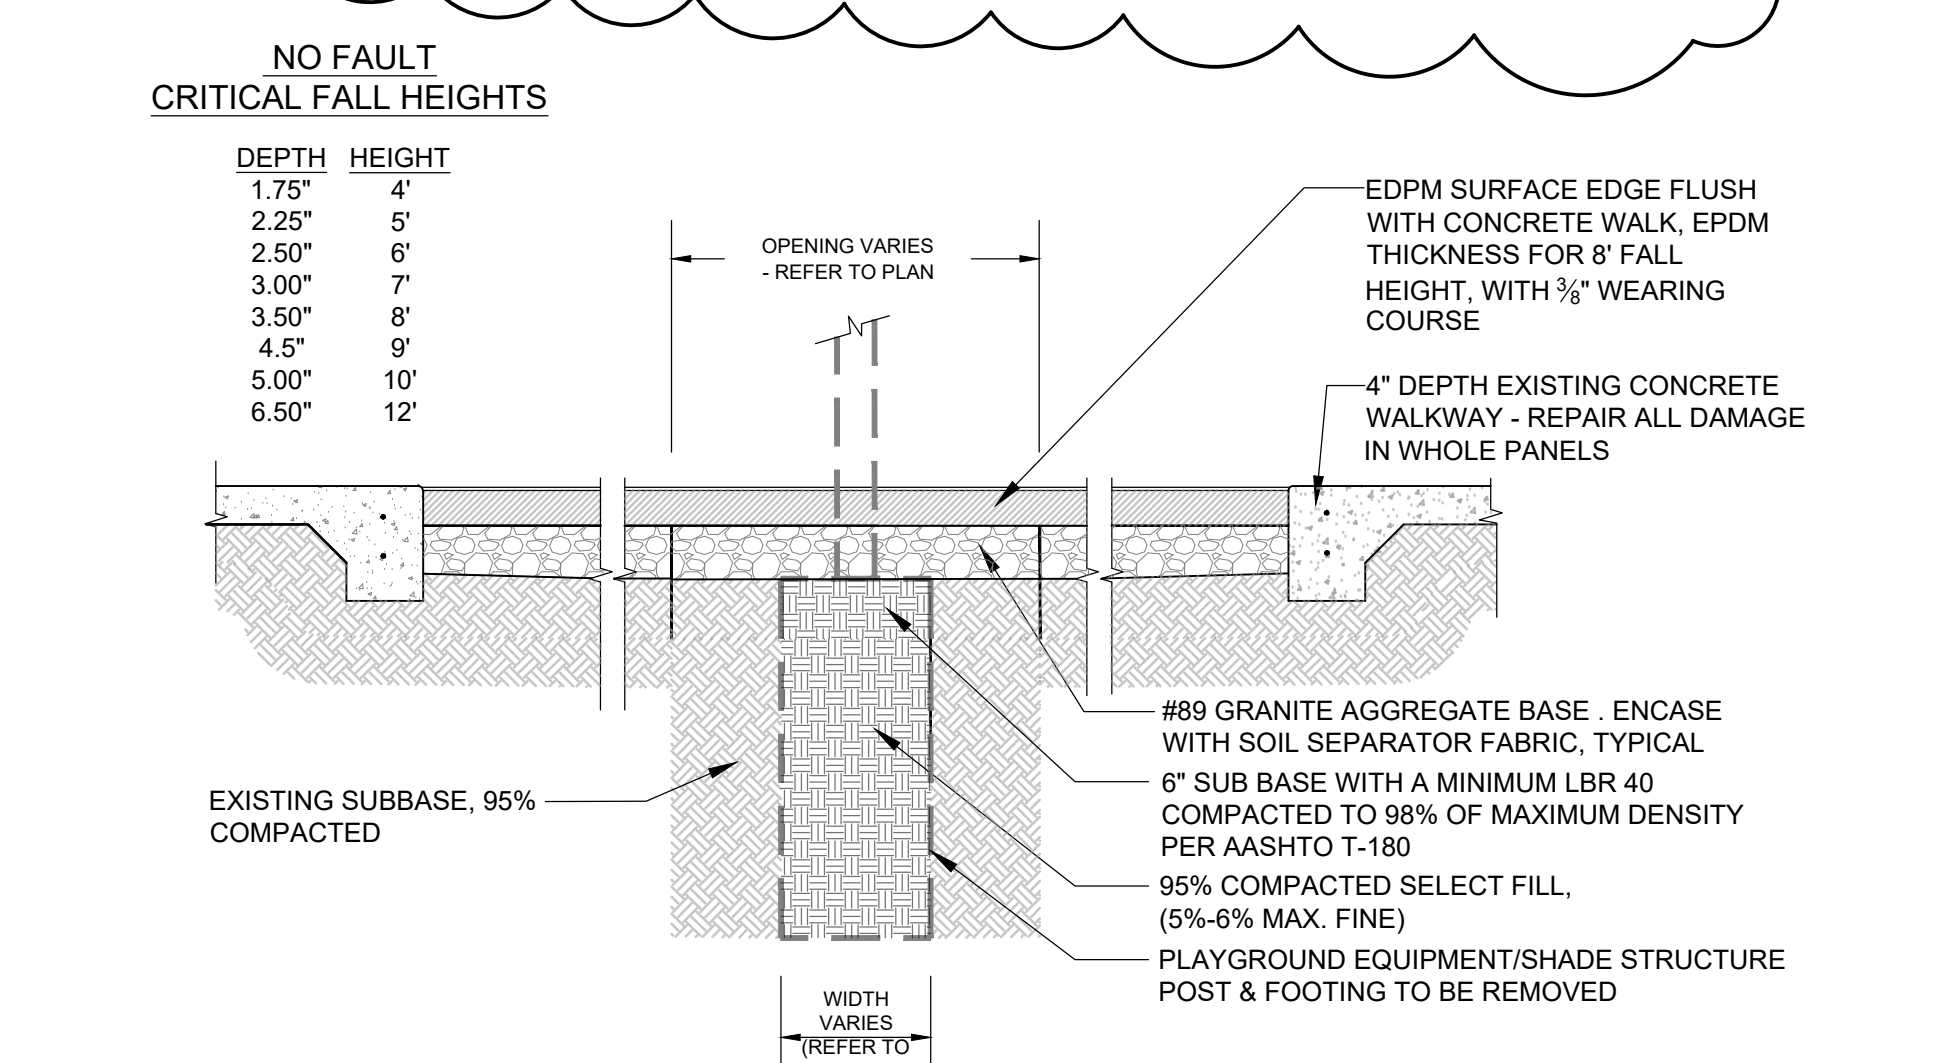

SAFETY SURFACE/FOOTING FILL DETAIL NTS

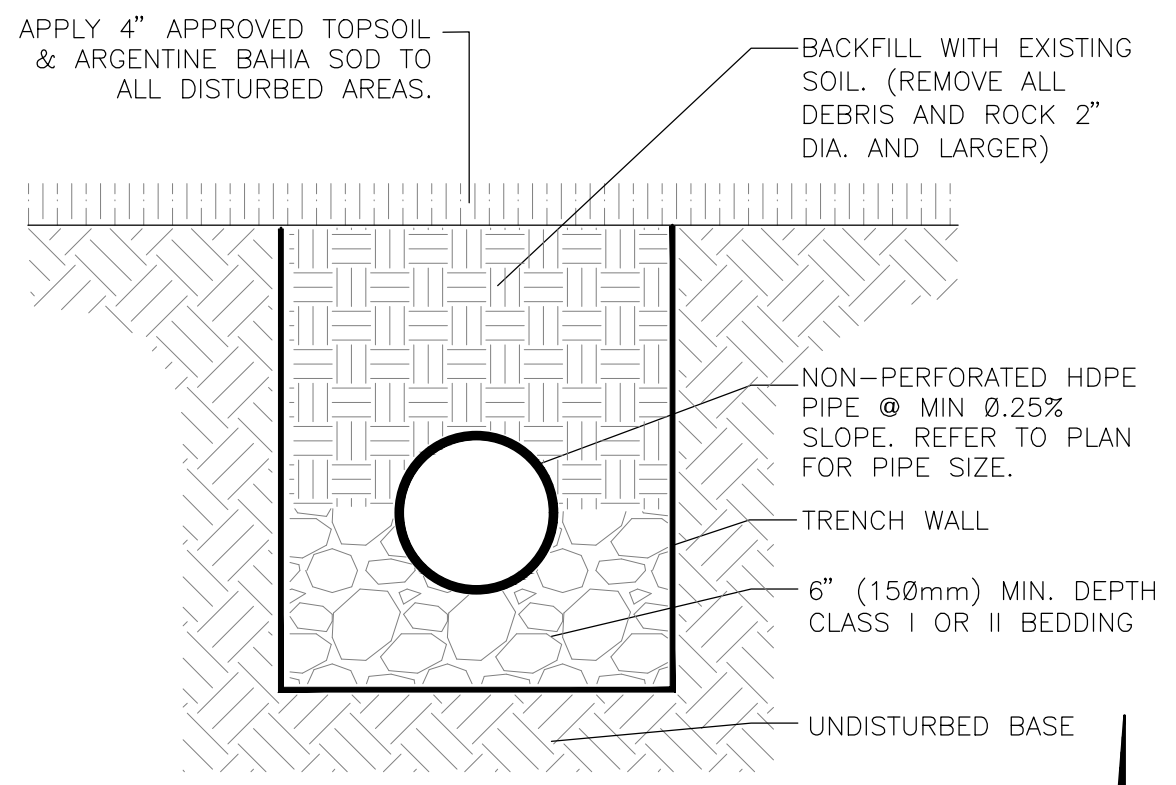

TRENCH DETAIL NTS

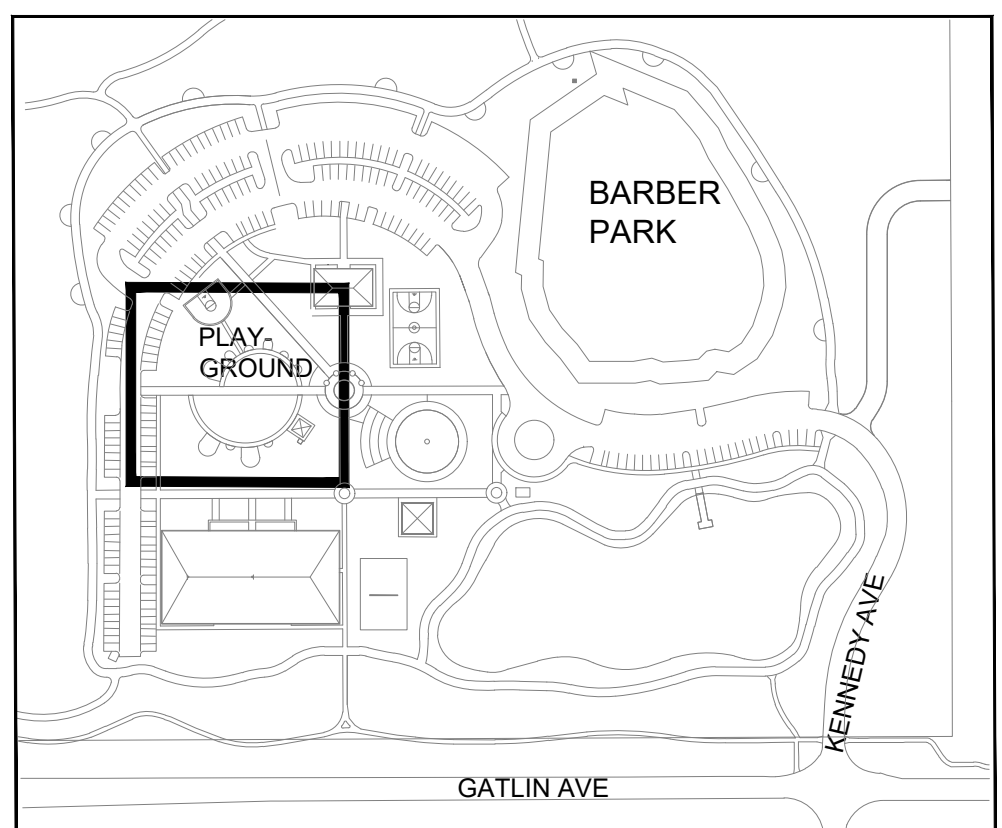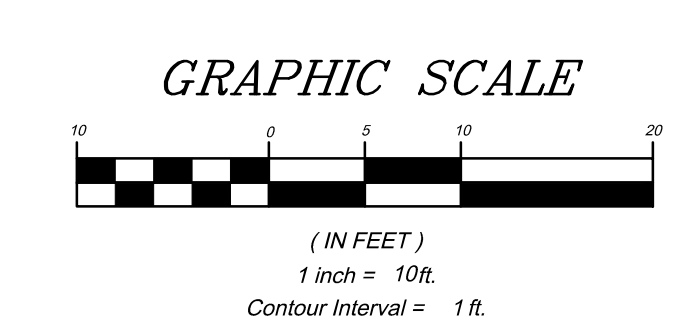

KEY MAP NTS

NO.	DATE	REVISION
4	08/24/2018	Addendum 1
3	08/17/2018	
2	09/28/2017	100% Submission
1	06/09/2017	60% Submission

ADC
ARCHITECTURAL DESIGN
COLLABORATIVE
945 N. PENNSYLVANIA AVENUE
WINTER PARK, FLORIDA 32789
(407) 628-1188

TEAM Engineering, LLC
TEAM ENGINEERING
2215 WEMBLEY PLACE
ORLANDO, FL 32765
(407) 267-8905
COA-298113

JEFFREY EARHART, PE, ENGINEER OF RECORD FLORIDA REG.
PROF. ENGINEER No.: 49935

ORANGE COUNTY GOVERNMENT FLORIDA

BARBER PARK
PLAYGROUND IMPROVEMENTS
3701 GATLIN AVENUE, ORLANDO, FL 32812

GRADING PLAN - PLAYGROUND

SHEET NUMBER
C.5
OF 19 SHEETS