

**JUNE 5, 2019
BOARD OF COUNTY COMMISSIONERS
ORANGE COUNTY, FLORIDA
ADDENDUM NO. 2, IFB Y19-754-RC
ORANGE COUNTY FIRE RESCUE FIRE STATION #30 HVAC
REPLACEMENT**

THE REVISED BID OPENING DATE IS: JUNE 25, 2019

This addendum is hereby incorporated into the bid documents of the project referenced above. The following items are clarifications, corrections, additions, deletions and/or revisions to, and shall take precedence over, the original documents. Underlining indicates additions, deletions are indicated by ~~strikethrough~~.

- A. The bid opening date has been revised from ~~June 6, 2019~~ to June 25, 2019 at 2:00 P.M.**

Second Site visit has been scheduled for **Friday June 14, 2019 1:30 PM**

B. Questions and Answers:

1. QUESTION: Who is the existing BMS in this facility

ANSWER: There is currently no BMS at this location.

2. QUESTION: Who is the existing fire alarm?

ANSWER: Signature Systems is the existing Fire Alarm Monitoring company.

3. QUESTION: Please confirm the contractor will have exclusive access to the areas highlighted on drawing A-1.1.4 during each phase. There is a substantial amount of overhead work to be done inside the Fire Station and this is necessary for the safety of the Fire Fighters

ANSWER: The contractor will have full access within the respective phasing space they are working in at the time.

4. QUESTION: How will this phasing plan effect the occupants when the sleeping quarters are under construction seeing how this is a 24 hour facility? Will the county provide alternate sleeping arrangements?

ANSWER: The firefighters will have to sleep in another section of the station while the work going on in the sleeping quarters. The firefighters will make their own sleeping arrangements.

5. QUESTION: During the walk through contractors were not allowed to look above the ceilings to see existing conditions due to liability of being on a ladder. Can pictures be provided of:

- The perimeter wall above the ceiling where the contractor is to install the vapor barrier, in various locations (more than one)?
- General pictures of above ceilings where all the duct work modifications will occur?
- General pictures of above ceiling where the existing ducts to remain are to be professionally cleaned? To assess the labor which will be involved.
- Various pictures to properly assess the labor involved in installing the insulation to the underside of the roof decking?
- Pictures of the through wall penetrations where the fire dampers will need to be installed (taken from the side of the living quarters)?

ANSWER: Second Site visit has been scheduled for **Friday June 14, 2019 1:30 PM** See attached “ ORANGE COUNTY, FLORIDA AGREEMENT ASSUMING RISK OF INJURY OR DAMAGE RELEASE OF LIABILITY AND INDEMNITY AGREEMENT “ which will need to be signed and completed to permit participation.

6. QUESTION: When is the county planning on awarding this project and issuing NTP?

ANSWER: The award date will be revised depending on the number of addendums issued. NTP will be issued after the contract is awarded.

7. QUESTION: Can the NTP be issued once submittals have been approved and once the permit has been issued? If not, will the county extend the substantial completion time frame to account for the time it will take to obtain these items due to the fact that all physical construction will not be able to start until these items have been obtained.

ANSWER: The NTP will be issued after contract award. The county will review the substantial completion date with the contractor with regards to submittals and permits.

8. QUESTION: Who is responsible for removing and storing owner/occupant's furniture and personal belongings?

ANSWER: The contractor will be responsible for relocating the furniture and any other items that must be moved with the exception of any items belonging to the Firefighters themselves (e.g. personal affects, firefighting gear, etc).

9. QUESTION: Drawing M-001, Mechanical General Notes, Note #2 appears to be missing, please clarify.

ANSWER: General Note 2 is “Not Used”.

10. QUESTION: Drawing M-001, Mechanical General Notes, Note #11 states “All HVAC equipment location & weight shall be coordinated and approved by the structural engineer...”. Who is responsible for hiring and paying for the structural engineer?

ANSWER: Where size and weight of new equipment differs substantially from the existing being replaced, contractor shall engage structural engineer to verify adequacy of support structure.

11. QUESTION: Drawing M-100, Plan Key Notes, Note #4 states to remove existing drywells and provide new. It was noticed at the Prebid meeting that from the Hastings Street entrance (east side of building) that the area indicated on the plans as the location of one of the two drywells is under an existing concrete drive way (see attached photos). Is the contractor expected to cut and remove the concrete, which will hinder the fire department from accessing that bay for an indefinite amount of time, to remove and replace the drywell then patch the concrete when finished? If so please provide a specification for that specific drywell to include DOT/traffic ratings. Please provide a detail on how to patch the concrete in this area.

ANSWER: Please see revised drawing sheets M-100 and M-101 as well as NDS Flo-Well Drywall Spec.

12. QUESTION: For the drywell to be installed on the west side of the facility which is in a non-traffic area will the attached drywell submittal be acceptable? If not, please provide a specification.

ANSWER: Please see revised drawing sheets M-100 and M-101 as well as NDS Flo-Well Drywall Spec. Provide drywells in the turfed areas as shown in the revised drawings. The attached "Flo-Well" drywell is acceptable.

13. QUESTION: Drawing M-101, Plan Key Notes, Note #3 states "Provide new 14" DIA. return duct and register and connect to existing return as indicated." At the #3 hex note on the Mezzanine Plan view shows only a 20"x28" and a 20"x26" duct. No 14"Ø ducts are found in this area nor are any registers shown, please clarify.

ANSWER: See the floor plan; a new 14"Ø duct is shown from the Dayroom returning to the main AHU-1 return duct.

14. QUESTION: I cannot seem to find where the condensing units are being fed from. Drawings state there is an existing breaker that is to be reused but fail to show where in the building it is located. Please clarify from where the condensing units are being fed and if there is indeed an existing breaker or not.

ANSWER: Please see revised drawing sheets E-101 and E-601.

C. Clarifications

- a. Please see revised architectural drawings that change the mechanical equipment pads to full concrete slab.

D. ACKNOWLEDGEMENT OF ADDENDA

1. The Bidder/Proposer shall acknowledge receipt of this addendum by completing the applicable section in the solicitation or by completion of the acknowledgement information on the addendum. Either form of acknowledgement must be completed and returned not later than the date and time for receipt of the bid or proposal.

2. All other terms and conditions of the IFB remain the same.

3. Receipt acknowledged by:

Authorized Signature

Date Signed

Title

Name of Firm

Client Name:

ORANGE COUNTY
FIRE STATION #30
 20 SOUTH HASTINGS ST.
 ORLANDO, FL 32835




Issue: 100% PERMIT DOCUMENTS 02-07-19

NO.	DESCRIPTION	DATE
1	PRE-BID RFI	05/15/19

Project Name:

ORANGE COUNTY
FIRE STATION #30
HVAC REPLACEMENT

Scale: As indicated Seal:
 Design By: GJ
 Drawn By: GJ
 Checked By: JS
 Engineer of Record:
 License Number:

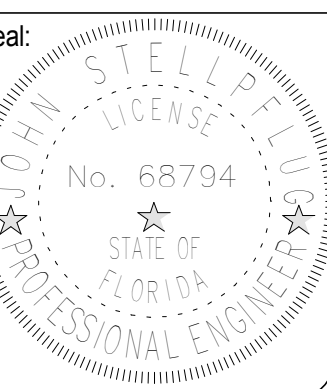

Sheet Name:

MECHANICAL
DEMOLITION FLOOR PLAN

Sheet Number:


M-100

GENERAL NOTES:

- A. REFER TO SHEET M0.01 FOR GENERAL NOTES.
- B. ROUTE NEW AHU CONDENSATE DRAINS FULL SIZE OF NEW UNIT TO EXISTING CONDENSATE DRAINS WITHIN MECHANICAL ROOM.
- C. RECONNECT EXISTING DUCT SMOKE DETECTOR SMOKE CONTROLS TO NEW AHU'S (TYP).
- D. CONTRACTOR SHALL PROVIDE TEMPORARY COOLING IN ALL AREAS WHERE THE COOLING SYSTEM WILL BE DOWN FOR REPLACEMENT. TEMPORARY COOLING SHALL CONSIST OF SPOT COOLERS FURNISHED BY CONTRACTOR. CONTRACTOR SHALL MAINTAIN AND DRAIN SPOT COOLERS AS REQUIRED DURING THE DAY AND BEFORE LEAVING FOR THE NIGHT. ALL PHASES SHALL BE PROVIDED WITH TEMP. COOLING WHILE OCCUPIED.
- E. SEE PHASING DRAWING FOR CONSTRUCTION PHASING. AHU'S SHALL BE REPLACED IN A MANNER THAT FOLLOWS THE PHASING PLAN. AHU-1 SHALL BE REPLACED & DUCTWORK MODIFICATIONS ACCOMPLISHED DURING PHASES 1,2 & 3 WITH PHASE 2 RESTROOMS AVAILABLE WITH TEMPORARY COOLING DURING AHU-1 REPLACEMENT. AHU-2 SHALL BE REPLACED & DUCTWORK MODIFICATIONS ACCOMPLISHED DURING PHASE 5 & 6, AFTER AHU-1 IS UP AND RUNNING.
- F. REBALANCE ALL HVAC SYSTEMS ONCE AHU REPLACEMENT AND HVAC MODIFICATIONS HAVE BEEN ACCOMPLISHED. NEW CONTROLS SHALL BE COMMISSIONED WITH OWNER REPRESENTATIVE PRESENT TO VERIFY EQUIPMENT OPERATIONS AND ALLOW FOR TRAINING OF CONTROLS AND FOR NEW HVAC SYSTEMS.

PLAN KEY NOTES: (XX)

1. CLEAN ALL EXISTING SUPPLY AND RETURN ROUND BRANCH DUCTWORK AND RECONNECT TO EXISTING MAIN SUPPLY AND RETURN DUCTWORK.
2. DEMOLISH SUPPLY AND RETURN MAIN DUCTWORK PREPARE FOR NEW. COORDINATE EXISTING ROUND SUB-MAINS THAT CONNECT WITH MAIN IN FIELD AND ADJUST ACCORDINGLY.
3. DEMOLISH EXHAUST FAN, DUCTWORK AND GRILLE. CAP EXHAUST GRILLE IN SOFFIT. DEMOLISH RETURN REGISTER IN LINEN CLOSET AND DUCT CONNECTION; PREPARE FOR NEW.
4. REMOVE EXISTING CONDENSATE TO GRADE. PREPARE PIPING BELOW GRADE FOR CONNECTION TO NEW DRYWELL EXCAVATE BY HAND AS REPLACED TO AVOID DAMAGE TO EXISTING UTILITIES.
5. DEMOLISH AND REMOVE CONDENSING UNITS; DEMOLISH REFRIGERANT PIPING TO WITHIN BLDG. AND SEAL BLDG PENETRATIONS WATERTIGHT.
6. DEMOLISH AHU AND ASSOCIATED DUCTWORK AND PIPING TO ALLOW FOR NEW. DEMOLISH DUCT HEATER AND PREPARE FOR NEW. DEMOLISH EXISTING OA DUCTWORK TO ALLOW FOR NEW MOTOR OPERATED DAMPER.
7. DEMOLISH EXHAUST GRILLE AND PATCH REPAIR DUCTWORK.

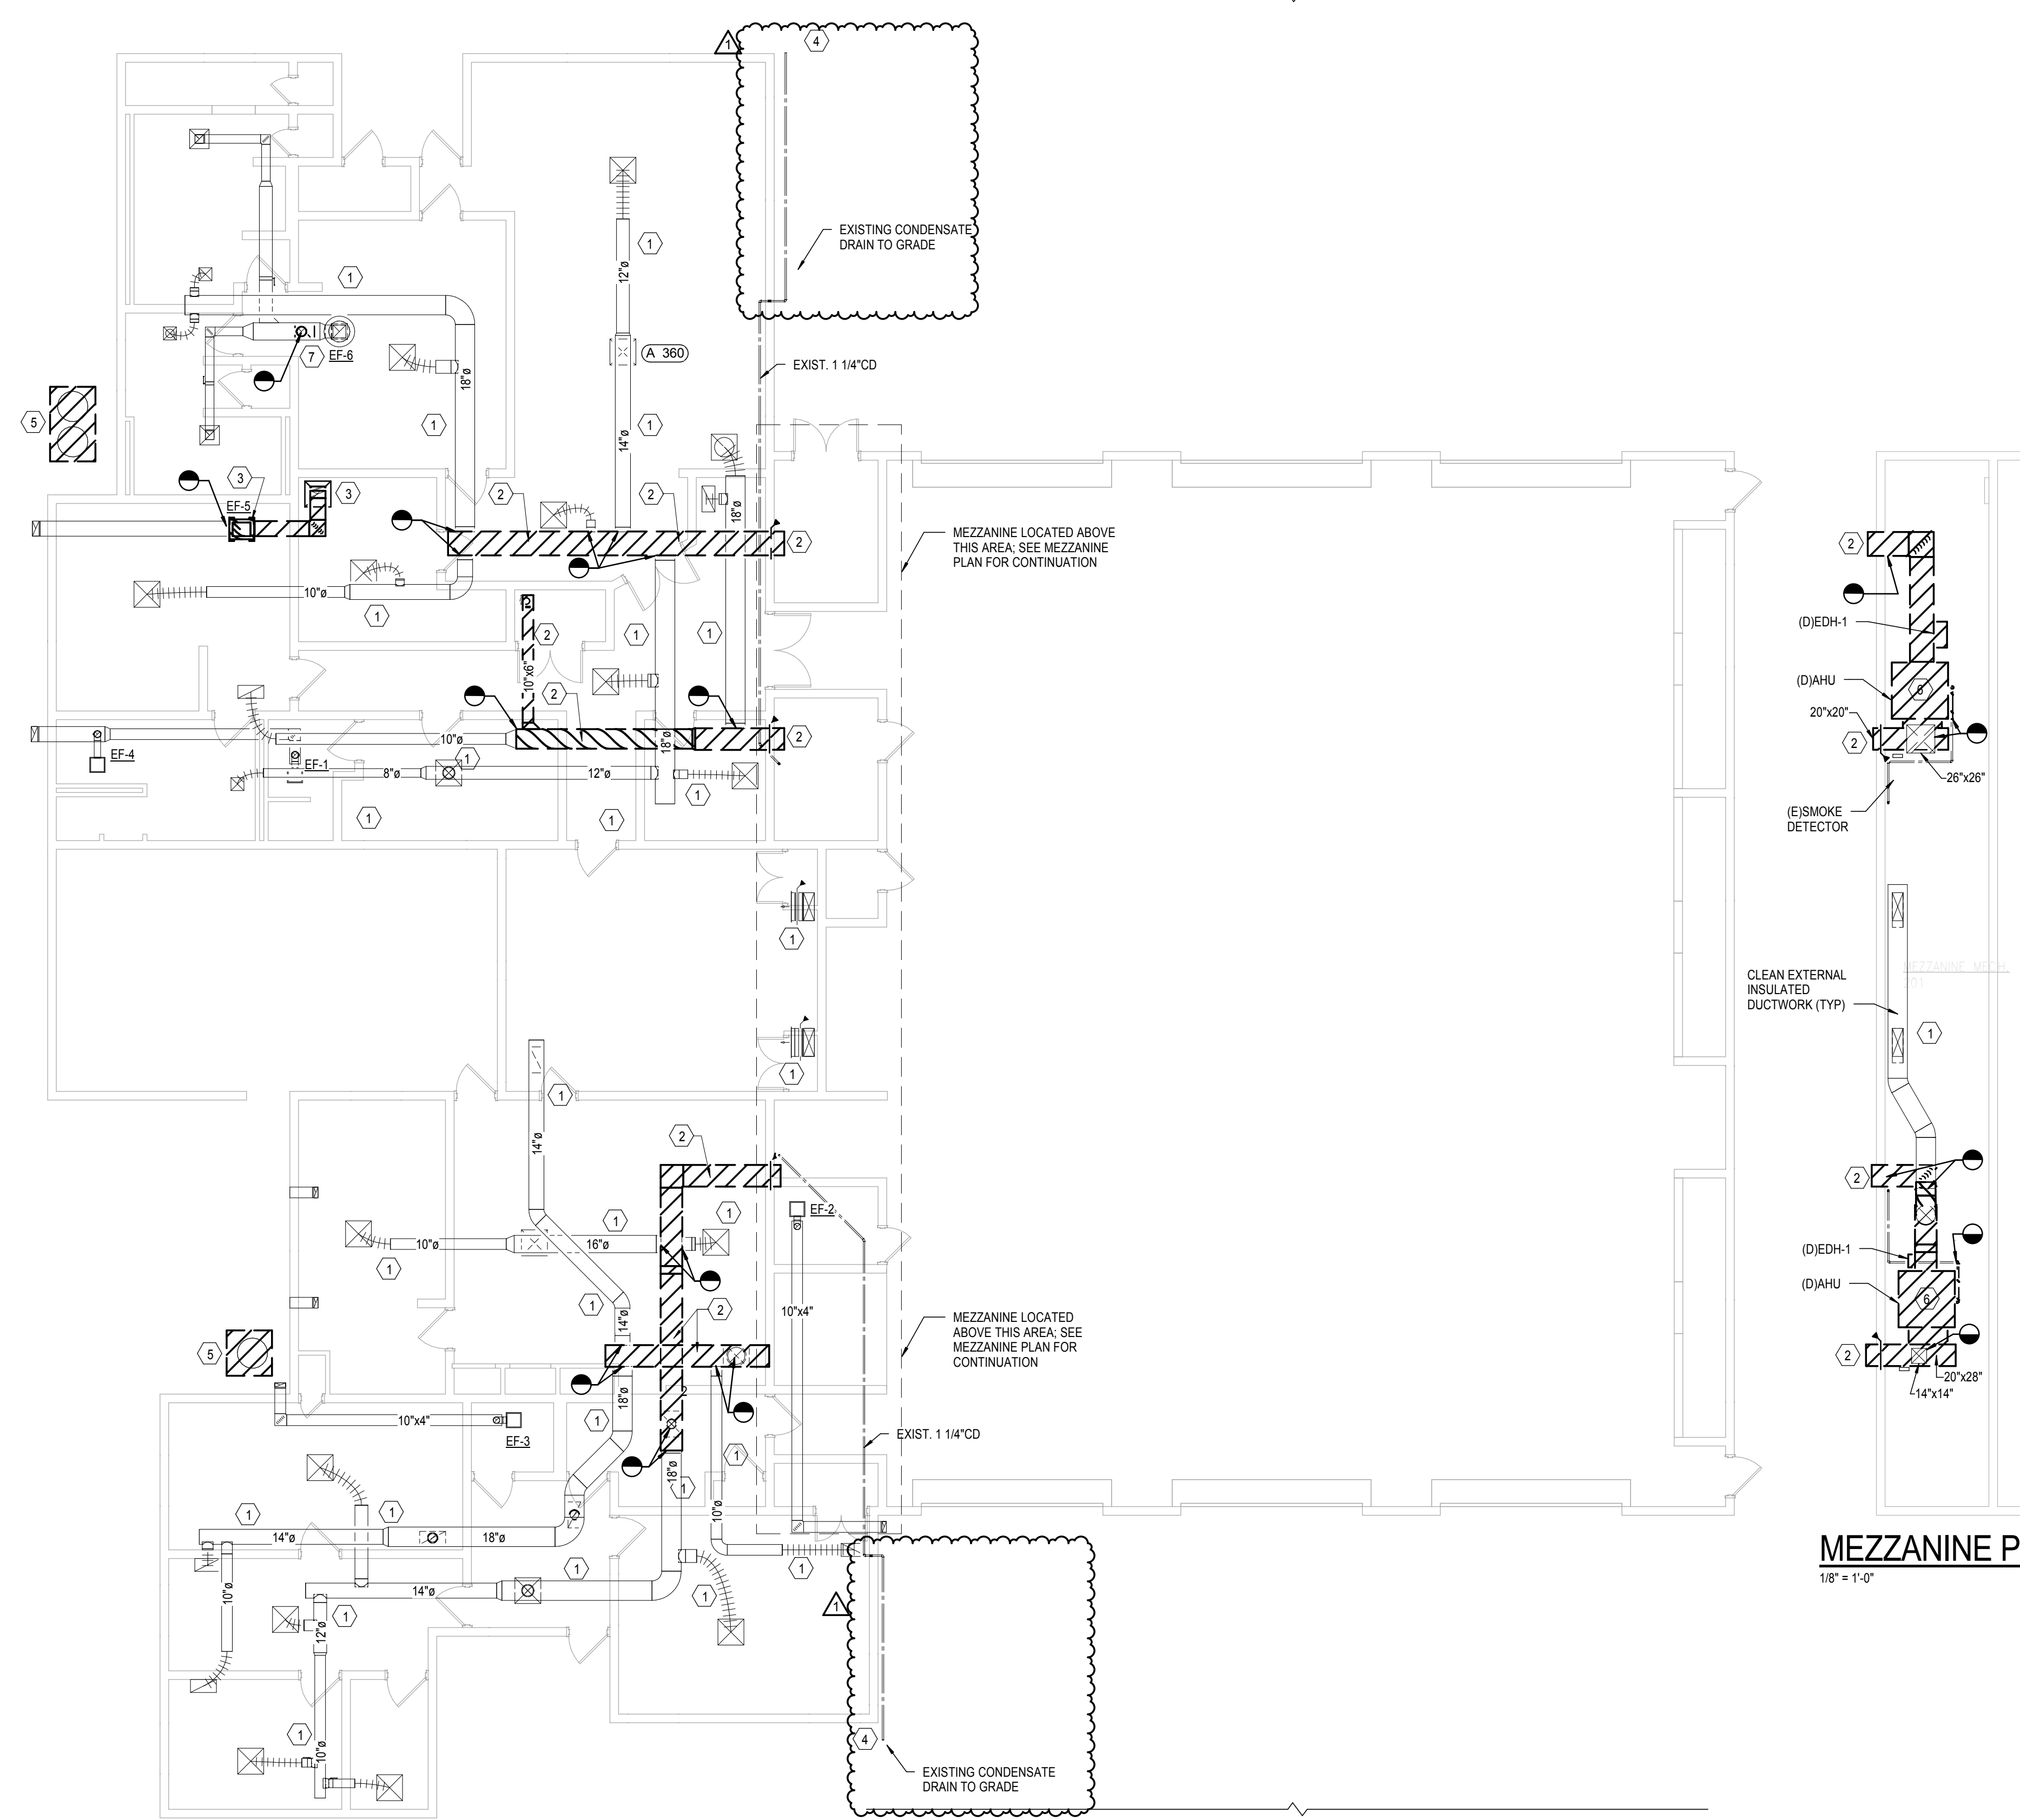

MEZZANINE PLAN
 1/8" = 1'-0"

MASTER KEYNOTE LEGEND

KEY	TEXT
02 41 19.0001	TYP. REMOVE EXISTING ACOUSTICAL CEILING TILE, GRID & WIRES COMPLETE.
02 41 19.0002	TYP. REMOVE EXISTING GYPSUM DRYWALL CEILING COMPLETE.
02 41 19.0003	TYP. REMOVE EXISTING ALUMINUM SOFFIT SYSTEM COMPLETE.
06 10 00.0034	TYP. 3/4" C.D.X. PLYWOOD ALONG OUTSIDE EDGE OF EXTERIOR WALLS.
06 10 00.0100	TYP. WHITE, RUSTIC STYLE HARDIE BOARD. PAINTED. 3/4" X 10"
06 10 00.0712	TYP. WHITE, RUSTIC STYLE HARDIE BOARD. PAINTED. 3/4" X 7 1/2"
07 21 16.0030	TYP. BLANKET INSULATION, R-30 SECURED WITH GALVANIZED STEEL MESH OVER ALL AREAS IN SCOPE, EXCLUDING MEZZANINE.
07 42 93.0000	TYP. ALUM SYSTEM SOFFIT & CEILING.
07 81 10.0000	TYP. FIRE STOPPING MATERIAL.
07 89 00.0000	TYP. DRAFTSTOPPING MATERIAL AT PENETRATIONS, VERTICAL OR HORIZONTAL AT WALLS.
09 21 16.0058	TYP. 5/8" GWB"
09 51 23.0000	TYP. ACCOUSTIC LAY IN PANELS AND GRID SYSTEM.
09 51 23.0001	TYP. VINYL FACED GYPSUM: 24" X 24" X 5/8" CLASS A, MOLD AND MILDEW RESISTANT, HUMIGUARD WITH 15/16" PRELUDE LAY IN CEILING PANELS. ARMSTRONG KITCHEN ZONE #673 OR APPROVED EQUAL.
09 91 00.0000	TYP. PAINT

MASTER KEYNOTE LEGEND


KEY	TEXT
-----	------

MASTER KEYNOTE LEGEND

KEY	TEXT
-----	------

ABBREVIATIONS

A/C	AIR CONDITION.-ED.-ER.-ING	L.L.H.	LONG LEG HORIZONTAL
ADJ.	ADJUSTABLE	L.L.V.	LONG LEG VERTICAL
A.F.F.	ABOVE FINISH FLOOR	MAT. MAT'L	MATERIAL
ALUM.	ALUMINUM	MAX.	MAXIMUM
&	AND	MECH.	MECHANICAL
L	ANGLE	MFRS.	MANUFACTURER
APPROX.	APPROXIMATELY	MIN.	MINIMUM
@	AT	MISC.	MISCELLANEOUS
BLDG.	BUILDING	M.O.	MASONRY OPENING
B.O.	BOTTOM OF	MTD.	MOUNTED
CEIL./CLG.	CEILING	MTL.	METAL
C.J.	CONTROL JOINT	N.	NATURAL; NORTH
C	CENTER LINE	NO., #	NUMBER
CLO./CL.	CLOSET	NOM.	NOMINAL
CLR.	CLEAR	N.I.C.	NOT IN CONTRACT
COL.	COLUMN	O.C.	ON CENTER
CONC.	CONCRETE	OD	OUTSIDE DIAMETER
CONST.	CONSTRUCTION	OPNG.	OPENING
CONT.	CONTINUOUS	PL.	PLATE
C.M.U.	CONCRETE MASONRY UNIT	PLY.	PLYWOOD
D.F.	DRINKING FOUNTAIN	P.P.	POWER POLE
DIA. / Ø	DIAMETER	PT./PTD.	PAINT / PAINTED
DIM.	DIMENSION	P.T.	PRESSURE TREATED
DISP.	DISPENSER / DISPOSAL	P.T.D.	PAPER TOWEL DISPENSER
DN.	DOWN	P.T.H.	PAPER TOWEL HOLDER
DR.	DOOR	P.V.C.	POLYVINYL CHLORIDE
DTL./DET.	DETAIL	PNL.	PANEL
DWG.	DRAWING	R., RAD.	RADIUS OF GYRATION
E.	EAST	R.C.P.	REINFORCED CONCRETE PIPE
EA.	EACH	R.D.	ROOF DRAIN
E.J.	EXPANSION JOINT	RECT.	RECTANGULAR
ELEC.	ELECTRICIAN, ELECTRICAL	REINF.	REINFORCEMENT
ELEV.	ELEVATOR	REQ'D.	REQUIRED
ENCL.	ENCLOSURE	RM.	ROOM
EQ.	EQUAL	R.O.	ROUGH OPENING
EQUIP.	EQUIPMENT	R.O.W.	RIGHT-OF-WAY
E.W.C.	ELECTRIC WATER COOLER	S.	SUCTION; SINGLE ENTRANCE; SOUTH
EXIST.	EXISTING	SCH.; SCHED.	SCHEDULE
EXT.	EXTERIOR	S.D.	SOAP DISPENSER
F.D.	FLOOR DRAIN	S.H.	SOAP HOLDER
F.E.	FIRE EXTINGUISHER	SHT.	SHEET
F.F.	FINISH FLOOR	S.M.S.	STRUCTURAL METAL STUD
F.H.	FIRE HYDRANT	SPC.	SPACE
F.H.C.	FIRE HOSE CABINET	SPECS.	SPECIFICATIONS
FIN.	FINISH	SQ.	SQUARE
FLR.	FLOOR	S.S.	STAINLESS STEEL / SERVICE SINK
F.R.	FIRE RESISTANT	STD.	STANDARD
FT.	FEET / FOOT	ST.; STL.	STEEL
FTG.	FOOTING	STRUCT.	STRUCTURAL
GA.	GAUGE	T.	TOILET
GALV.	GALVANIZED	T.B.	TIE BEAM
G.B.	GRAB BAR	T & G.	TONGUE AND GROOVE; TAR AND GRAVEL
G.C.	GENERAL CONTRACTOR	T.O.	TOP OF
G.W.B.	GYPSUM WALL BOARD	T.P.H.	TOILET PAPER HOLDER
GYP.	GYPSUM	TYP.	TYPICAL
HCPD.	HANDICAPPED	U.O.N.	UNLESS OTHERWISE NOTED
H.M.	HOLLOW METAL	UR.	URINAL
HORIZ.	HORIZONTAL	V.C.P.	VITREOUS CLAY PIPE
HT.	HEIGHT	VERT.	VERTICAL
INV.	INVERT	W	WIRE; WATT; WIDE; WEST
JAN.	JANITOR	W	WITH
JT.	JOINT	W.C.	WATER COLUMN; WATER CLOSET
LAM.	LAMINATED	WD.	WOOD
LAV.	LAVATORY	W.H.	WATER HEATER

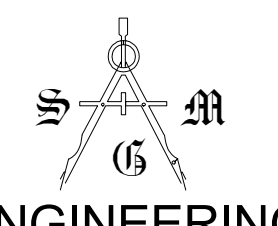

SGM ENGINEERING, INC.
MEP CONSULTING ENGINEERS
CA-0006208
935 Lake Baldwin Lane
Orlando, FL 32814
Phone: 407-767-5188
Fax: 407-767-5772
www.sgmengineering.com
Copyright © 2018 SGM Engineering, Inc.
SGM Project Number 2018-233



MLM-MARTIN ARCHITECTS, INC.
668 N. Orlando Avenue
Suite 107
Maitland, FL 32751
407 897 6764 ph.
407 894 1338 fax

Client Name:
**ORANGE COUNTY
FIRE STATION #30
20 SOUTH HASTINGS ST.
ORLANDO, FL 32835**



Issue: PERMIT DOCUMENTS 02-07-19

NO.	DESCRIPTION	DATE

Project Name:
**ORANGE COUNTY
FIRE STATION #30
HVAC REPLACEMENT**

Scale:	AS NOTED	Seal:
Design By:	Designer	
Drawn By:	Author	
Checked By:	Checker	
Architect of Record:	MIGUEL LAZARO MARTIN	
License Number:	AR 8255	

Sheet Name:
**ABBREVIATIONS
SYMBOLS AND SHEET
INDEX**






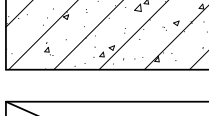
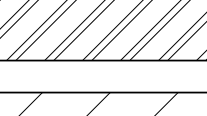
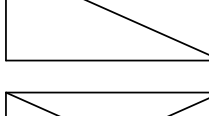
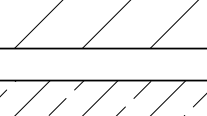
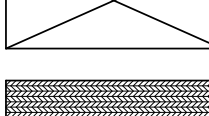

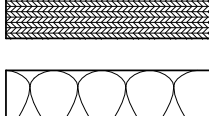
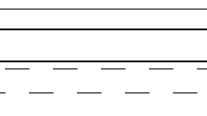
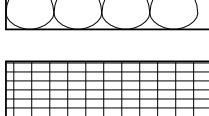
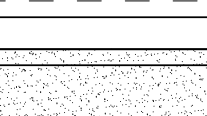
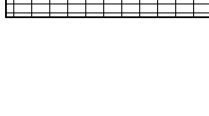
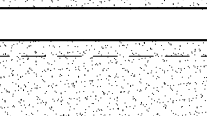
 
Sheet Number:

IS-0.0.1



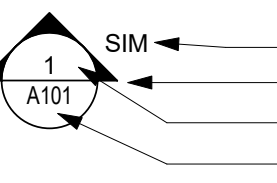
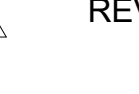
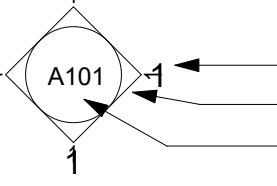

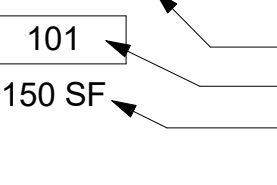

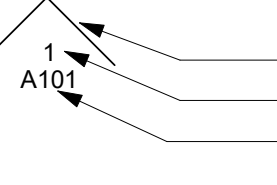





INDEX OF DRAWINGS

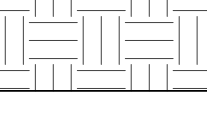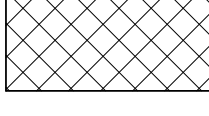
Δ NO.	DATE	DESCRIPTION
GENERAL		
IS-0.0.1		ABBREVIATIONS SYMBOLS AND SHEET INDEX
ARCHITECTURE - DEMOLITION		
AD-2.1.1		DEMO FLOOR PLAN
AD-2.2.1		DEMO CEILING PLAN
ARCHITECTURE		
A-1.1.1		LIFE SAFETY
A-1.1.2		DETAILS PENETRATION TYP.
A-1.1.3		UL DETAIL PENETRATIONS
A-1.1.4		PHASING PLAN
A-2.1.1		FLOOR PLAN
A-2.1.2		MEZZANINE PLAN
A-2.2.1		CEILING PLAN
A-5.1.1		BUILDING SECTIONS
A-7.1.1		ROOM FINISH SCHEDULE
A-8.1.1		DETAILS
A-8.1.2		DETAILS

MATERIALS LEGEND

	COMPACT FILL (EARTH)		MASONRY (CMU)
	CAST-IN-PLACE CONCRETE		MASONRY (BRICK)
	GROUT		PRE-CAST CONCRETE
	STEEL		WOOD (BLOCKING)
	ALUMINUM		ROUGH WOOD FRAMING
	ORNAMENTAL METAL (INDICATE TYPE)		PLYWOOD (ROUGH)
	GLASS		INSULATION (LOOSE OR BATT)
	PLASTIC		RIGID INSULATION
	GWB		
	LATH AND STUCCO		

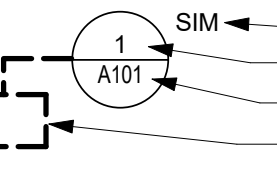SYMBOL LEGEND

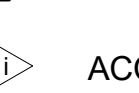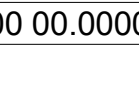	CALLOUT REFERENCE SIM., TYP., OH, ETC. DETAIL NUMBER DRAWING NUMBER CALLOUT INDICATOR		GRID LINE MARKER
	ELEVATION / SECTION REFERENCE SIM., TYP., OH, ETC. DIRECTION INDICATOR DETAIL NUMBER DRAWING NUMBER		REVISION MARKER
	INTERIOR ELEVATION REFERENCE DETAIL NUMBER DIRECTION INDICATOR DRAWING NUMBER		PARTITION TYPE MARKER
	Room name ROOM MARKER ROOM NAME ROOM NUMBER GROSS FLOOR AREA		WINDOW TYPE MARKER
	SITE PHOTOGRAPHY REFERENCE DIRECTION INDICATOR DETAIL NUMBER DRAWING NUMBER		LOUVER TYPE MARKER
			DOOR MARKER
			CENTER LINE
			ACCESSORY MARKER
			KEYNOTE MARKER

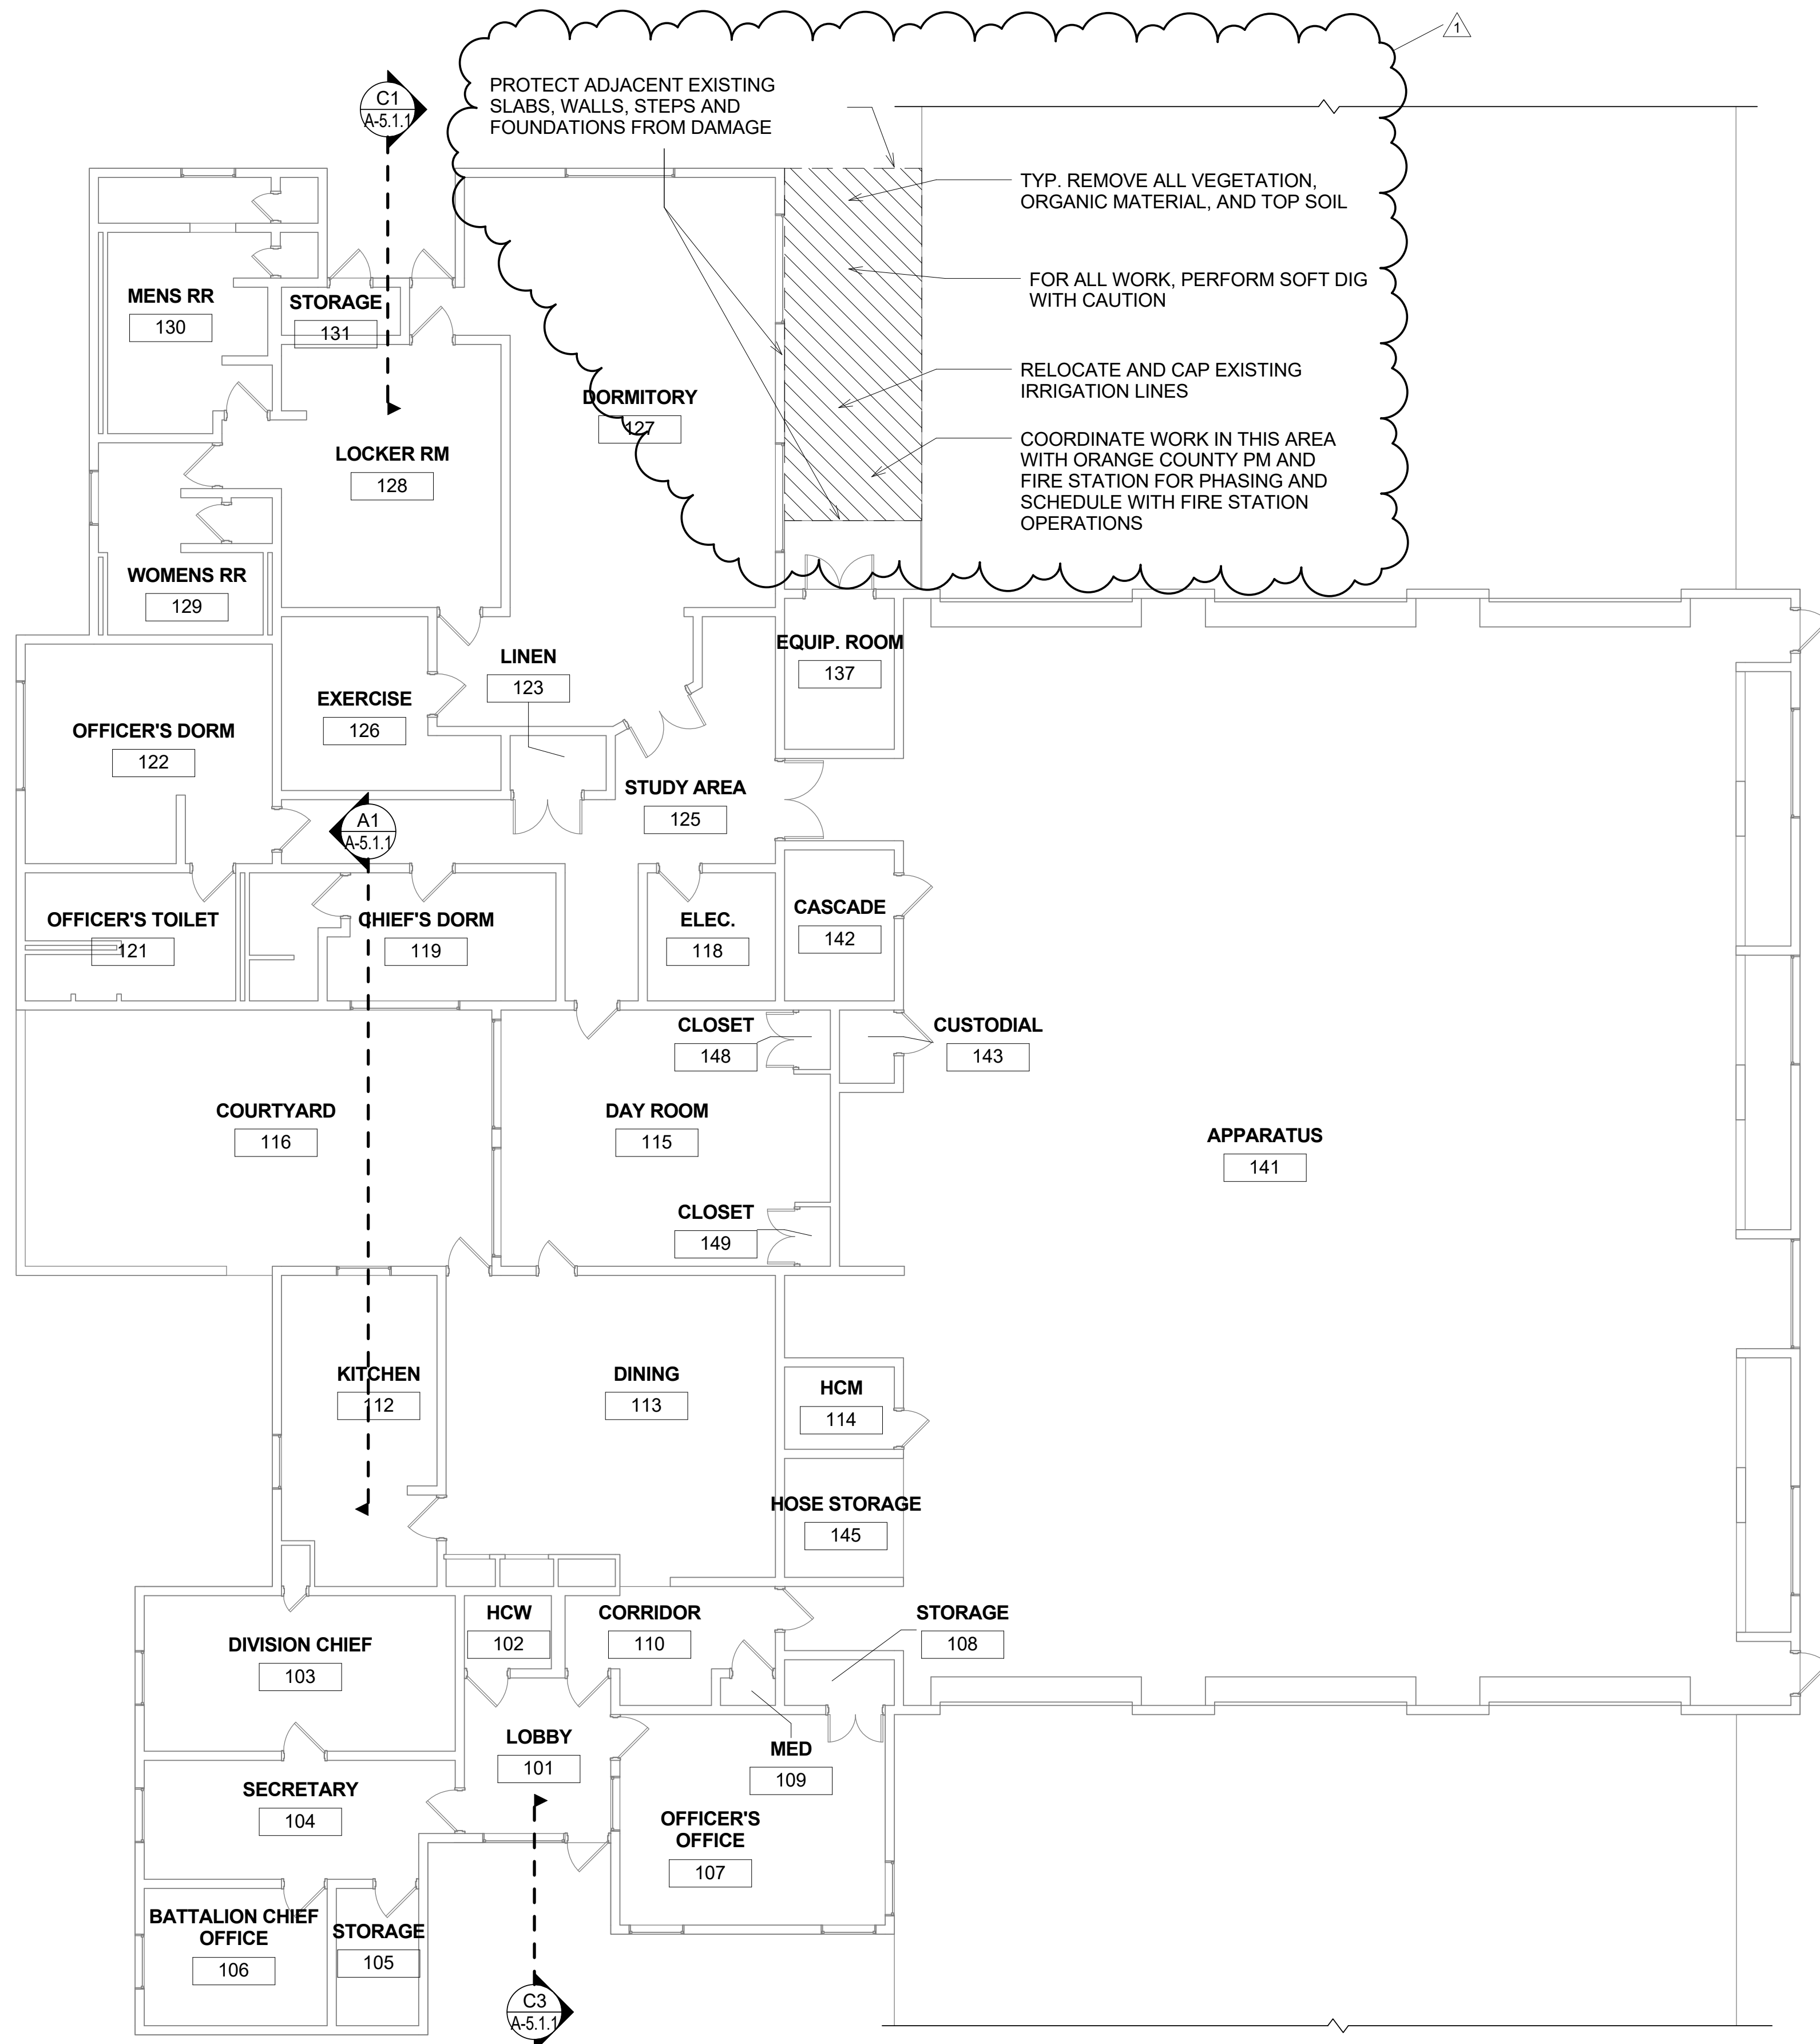

A1 LEVEL 1 FLOOR PLAN DEMO
1/8" = 1'-0"


SGM ENGINEERING, INC.
MEP CONSULTING ENGINEERS
 CA-0006208
 935 Lake Baldwin Lane
 Orlando, FL 32814
 Phone: 407-767-5188
 Fax: 407-767-5772
 www.sgmengineering.com
 Copyright © 2018 SGM Engineering, Inc.
 SGM Project Number 2018-233


MLM-MARTIN
ARCHITECTS, INC.
 668 N. Orlando Avenue 407.897.6764 ph
 Suite 107 407.894.1338 fax
 Maitland, FL 32751

Client Name:
ORANGE COUNTY
 FIRE STATION #30
 20 SOUTH HASTINGS ST.
 ORLANDO, FL 32835



Issue: PERMIT DOCUMENTS 02-07-19

NO.	DESCRIPTION	DATE
1	PRE-BID RFI	05/15/2019


Project Name:
ORANGE COUNTY
FIRE STATION #30
HVAC REPLACEMENT

Scale:	AS NOTED	Seal:
Design By:	MLM	
Drawn By:	ST	
Checked By:	MAM-AA	
Architect of Record:	MIGUEL LAZARO MARTIN	
License Number:	AR 8255	

Sheet Name:
DEMO FLOOR PLAN

Sheet Number:
AD-2.1.1

\\min-fs1\company\MLM-Projects\17651-4-P- Fire Station 30\0000 WORKING\17651-CENTRAL.rvt

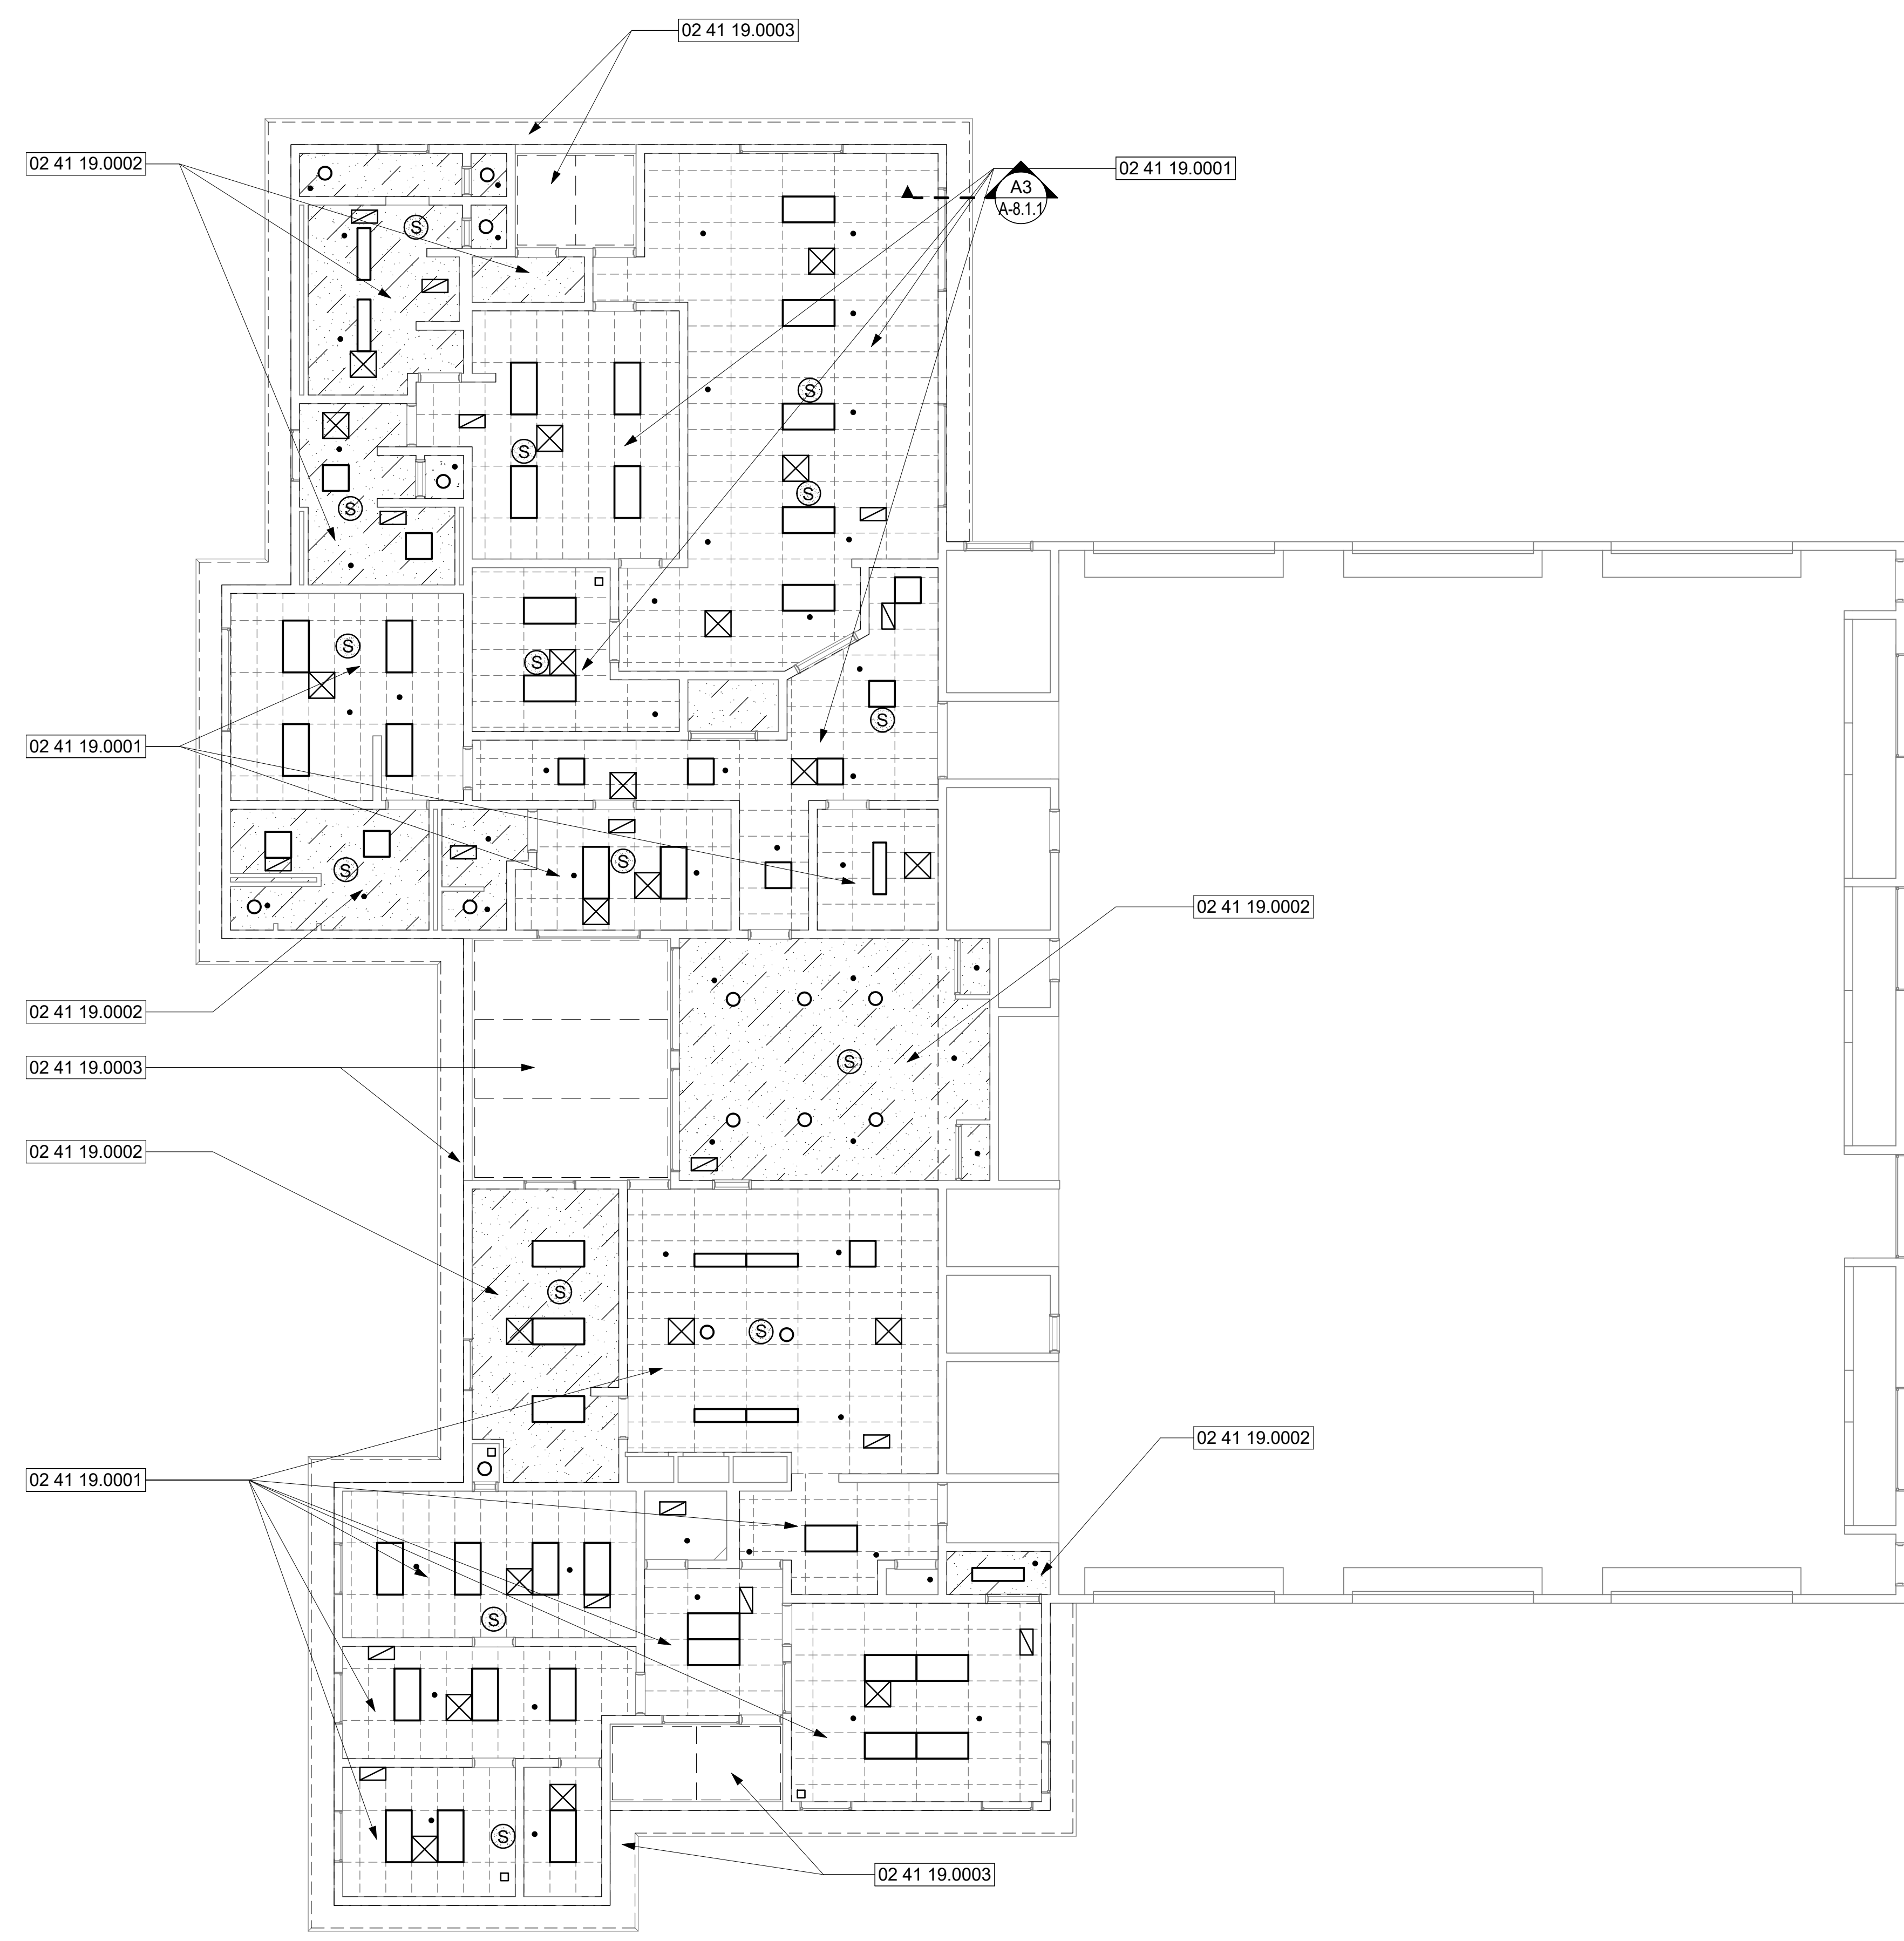

A1 REFLECTED CEILING PLAN
1/8" = 1'-0"

Keynote Legend	
Key Value	Keynote Text
02 41 19.0001	TYP. REMOVE EXISTING ACOUSTICAL CEILING TILE, GRID & WIRES COMPLETE.
02 41 19.0002	TYP. REMOVE EXISTING GYPSUM DRYWALL CEILING COMPLETE.
02 41 19.0003	TYP. REMOVE EXISTING ALUMINUM SOFFIT SYSTEM COMPLETE.


SGM ENGINEERING, INC.
 MEP CONSULTING ENGINEERS
 CA-0006208
 935 Lake Baldwin Lane
 Orlando, FL 32814
 Phone: 407-767-5188
 Fax: 407-767-5772
 www.sgmengineering.com
 Copyright © 2018 SGM Engineering, Inc.
 SGM Project Number 2018-233


MLM-MARTIN ARCHITECTS, INC.
 668 N. Orlando Avenue 407.897.6764 ph
 Suite 107 407.894.1338 fax
 Maitland, FL 32751

Client Name:
**ORANGE COUNTY
FIRE STATION #30
20 SOUTH HASTINGS ST.
ORLANDO, FL 32835**












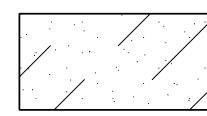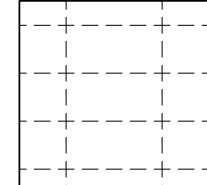

Issue: PERMIT DOCUMENTS 02-07-19

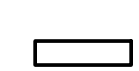NO.	DESCRIPTION	DATE

Project Name:
**ORANGE COUNTY
FIRE STATION #30
HVAC REPLACEMENT**


DEMO CEILING LEGEND

-  TYP. GYPSUM CEILING TO DEMO
-  TYP. 2X4 ACOUSTIC CEILING TILE TO DEMO
-  TYP. 2X4 LIGHTING REMOVE AND REINSTALL
-  TYP. 2X2 LIGHTING REMOVE AND REINSTALL
-  TYP. 1X4 LIGHTING REMOVE AND REINSTALL
-  TYP. CIRCULAR CEILING LIGHT REMOVE AND REINSTALL
-  HVAC SUPPLY GRILL REMOVE/SEE ME
-  HVAC RETURN REGISTER REMOVE/SEE ME
-  CEILING MOUNTED SPEAKER REMOVE AND REINSTALL
-  SMOKE DETECTOR REMOVE AND REINSTALL
-  TYP. SPRINKLER TO REMAIN

Scale:	AS NOTED	Seal:
Design By:	MLM	
Drawn By:	ST	
Checked By:	MAM-AA	
Architect of Record:	MIGUEL LAZARO MARTIN	
License Number:	AR 8255	

Sheet Name:
DEMO CEILING PLAN

Sheet Number:
AD-2.2.1

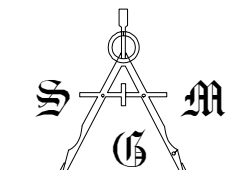

SGM ENGINEERING, INC.

MEP CONSULTING ENGINEERS
CA-0006208
935 Lake Baldwin Lane
Orlando, FL 32814
Phone: 407-767-5188
Fax: 407-767-5772
www.sgmengineering.com
Copyright © 2018 SGM Engineering, Inc.
SGM Project Number 2018-233



MLM-MARTIN ARCHITECTS, INC.

668 N. Orlando Avenue 407-897-6764 ph
Suite 107 407-894-1338 fax
Maitland, FL 32751

Client Name:

**ORANGE COUNTY
FIRE STATION #30**
20 SOUTH HASTINGS ST.
ORLANDO, FL 32835



Issue: PERMIT DOCUMENTS 02-07-19

NO.	DESCRIPTION	DATE

Project Name:

**ORANGE COUNTY
FIRE STATION #30
HVAC REPLACEMENT**

Scale:	AS NOTED	Seal:	
Design By:	MLM		
Drawn By:	ST		
Checked By:	MAM-AA		
Architect of Record:	MIGUEL LAZARO MARTIN		
License Number:	AR 8255		

Sheet Name:

DETAILS PENETRATION TYP.

Sheet Number:

A-1.1.2


GENERAL NOTES

- SPECIFIC FIRESTOPPING AND ASSEMBLY PER APPROVAL TEST OR ENGINEERING OPINION. REFER TO DIVISION 7 SECTION "FIRESTOPPING". SYSTEM NUMBERS THEREIN ARE FROM UL FOR CONVENIENCE ONLY AND ARE NOT INTENDED TO BE EXHAUSTIVE OR EXCLUSIVE.
- A COMBINATION OF MULTIPLE DETAILS MAY BE NECESSARY TO ADDRESS A SPECIFIC JOB CONDITION, SUCH AS MULTIPLE OR DIFFERING PENETRANTS THRU A SINGLE OPENING OR A HEAD-OF-WALL JOINT WITH A PENETRATION OF THE WALL OR HORIZONTAL ASSEMBLY.

U.L. PENETRATION ASSEMBLIES


FLOOR PENETRATIONS	
	CONCRETE W/ A MIN. THICKNESS LESS THAN OR EQUAL TO 5"
NO PENETRATION ITEMS	F-A-0005
METALLIC PIPE, CONDUIT, OR TUBING	F-A-1029
NON-METALLIC PIPE, CONDUIT, OR TUBING	F-A-2067
SLEEVED WIRING OR CABLES	C-AJ-3152
UNSLEEVED WIRING OR CABLES	F-A-3004
WALL PENETRATIONS	
	CONCRETE OR MASONRY W/ A MIN. THICKNESS LESS THAN OR EQUAL TO 8"
NO PENETRATION ITEMS	C-AJ-0087
METALLIC PIPE, CONDUIT, OR TUBING	C-AJ-1291
NON-METALLIC PIPE, CONDUIT, OR TUBING	C-AJ-2028
SLEEVED WIRING OR CABLES	C-AJ-3036
UNSLEEVED WIRING OR CABLES	W-J-3036
	FRAMED WALLS
NO PENETRATION ITEMS	W-L-0013
METALLIC PIPE, CONDUIT, OR TUBING	W-L-1290
NON-METALLIC PIPE, CONDUIT, OR TUBING	W-L-2335
SLEEVED WIRING OR CABLES	W-L-3112
UNSLEEVED WIRING OR CABLES	W-L-3079

CONTRACTOR RESPONSIBLE FOR CONFIRMATION OF ASSEMBLY APPLICABILITY OF CONDITIONS ENCOUNTERED

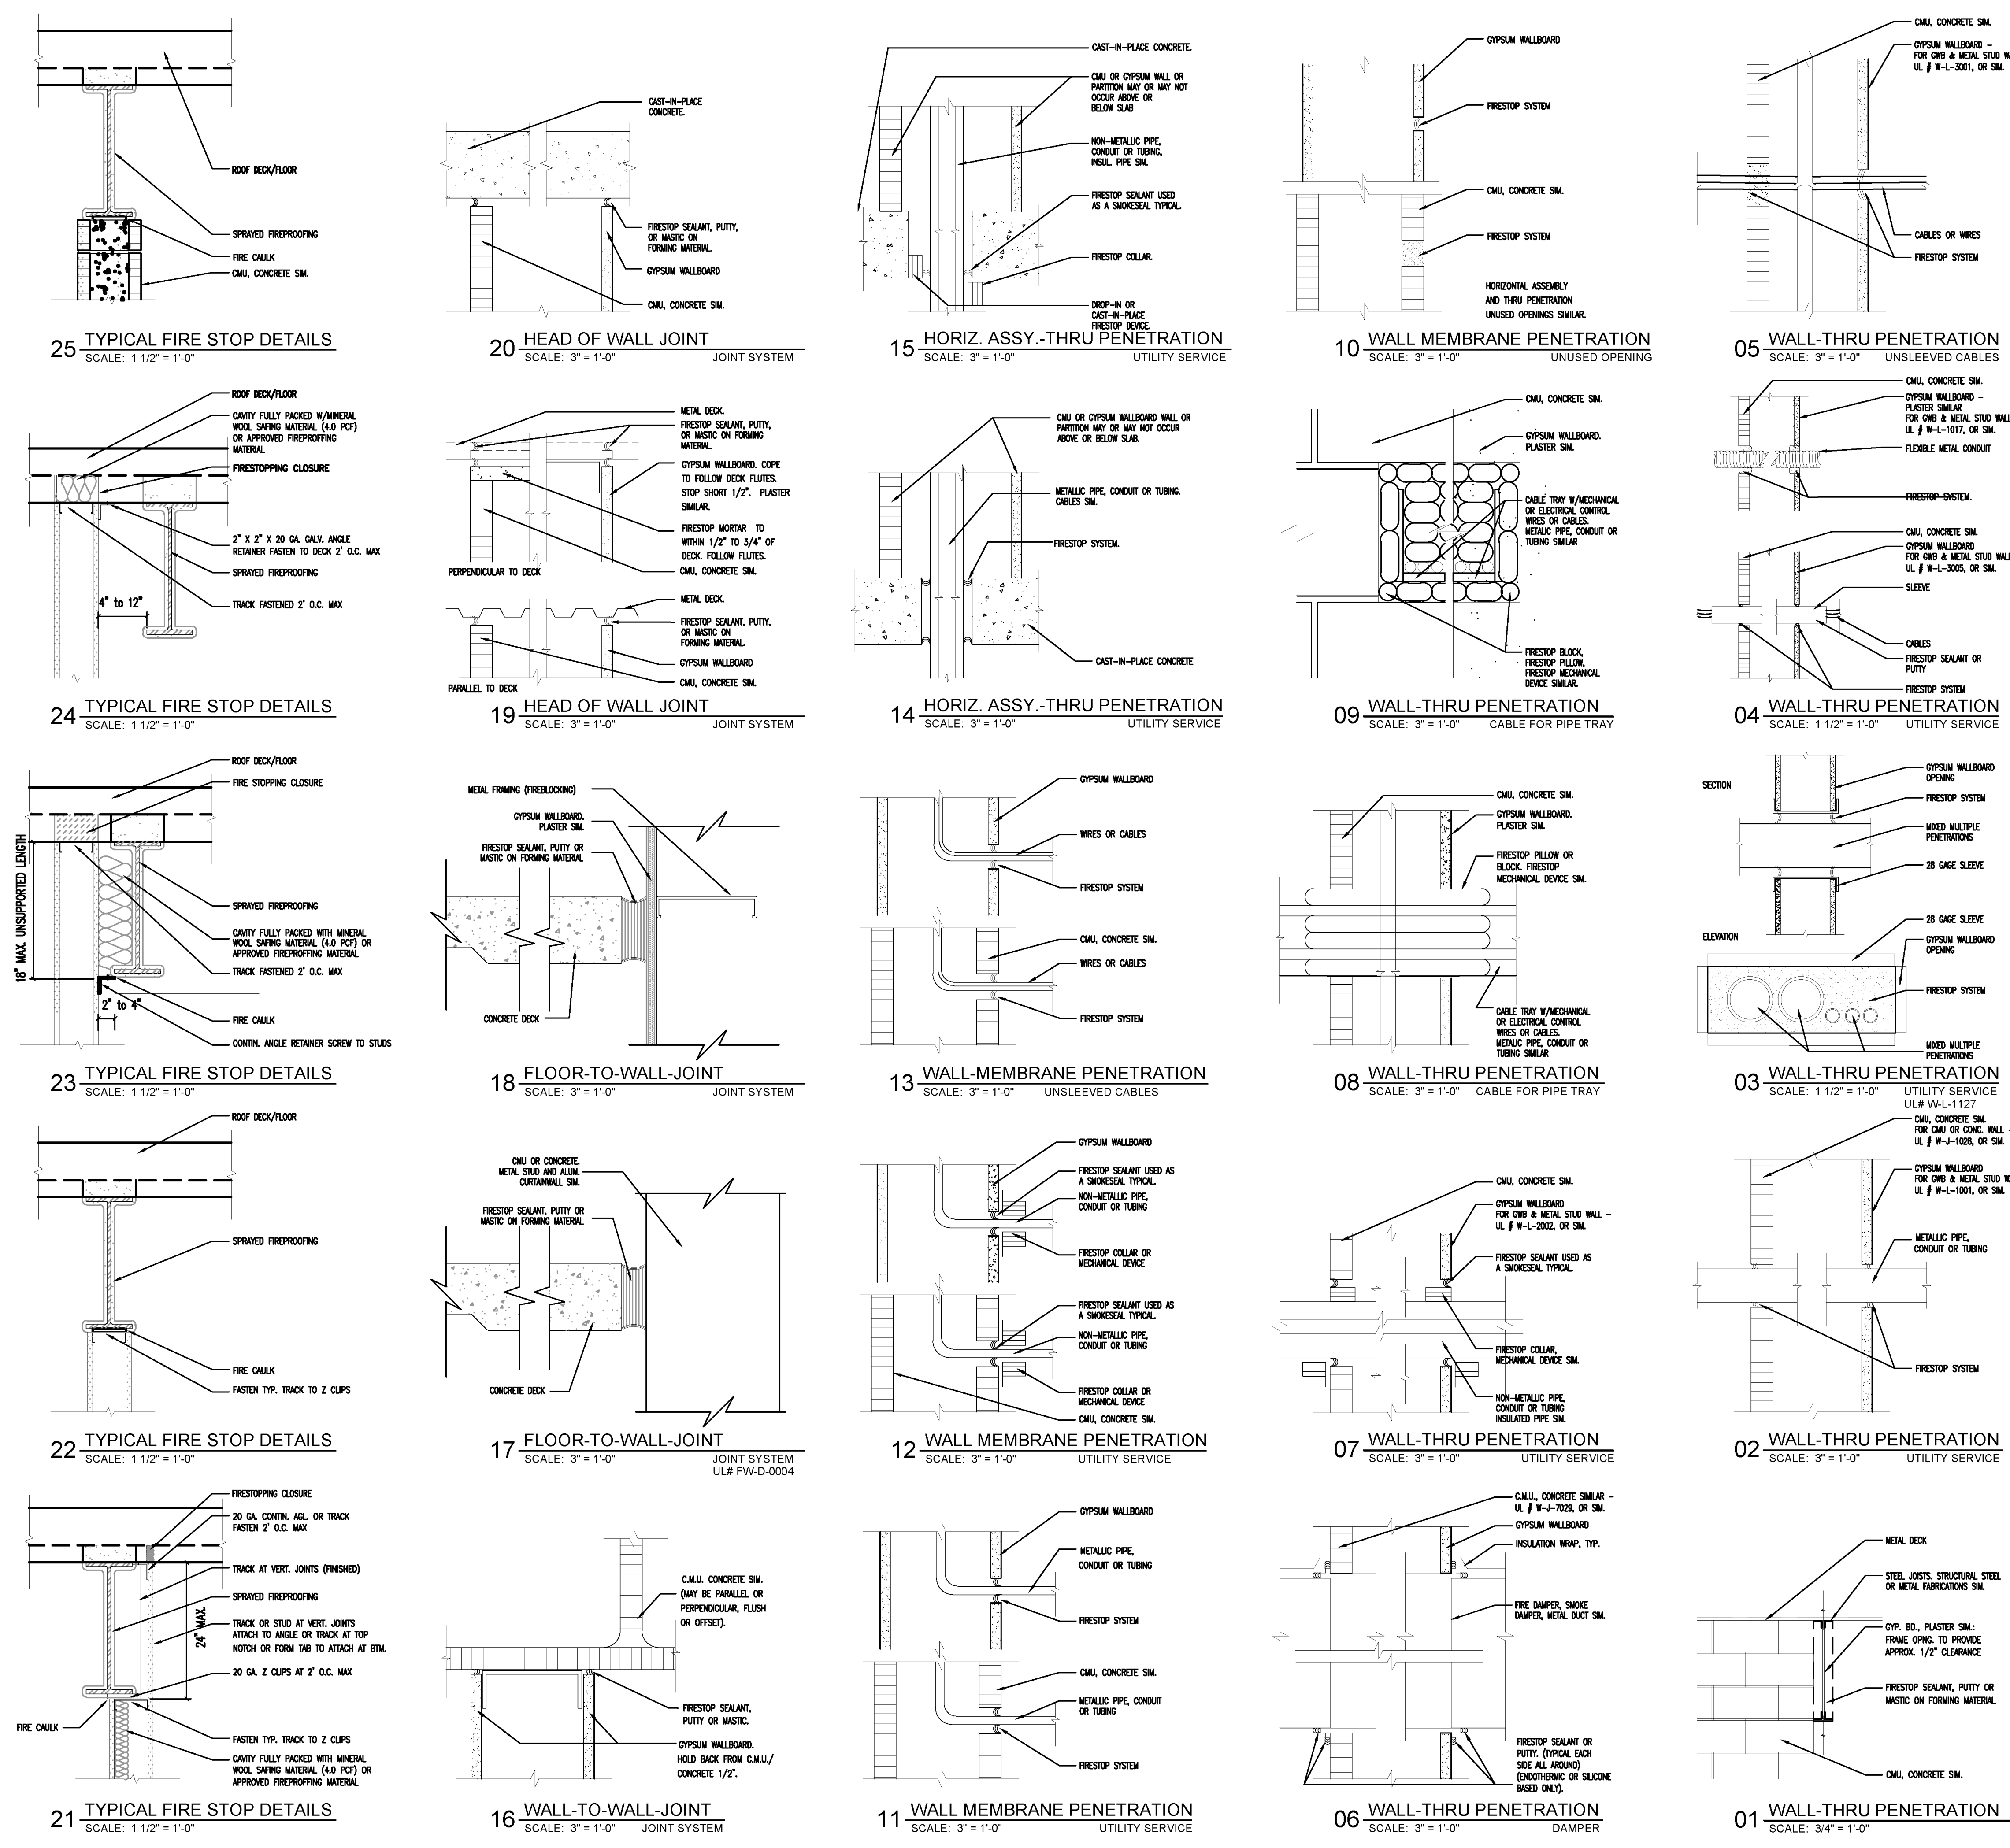






\\mlm-fs1\company\MLM-Projects\17651-4-P-Fire Station 30\0000 WORKING\17651-CENTRAL.rvt

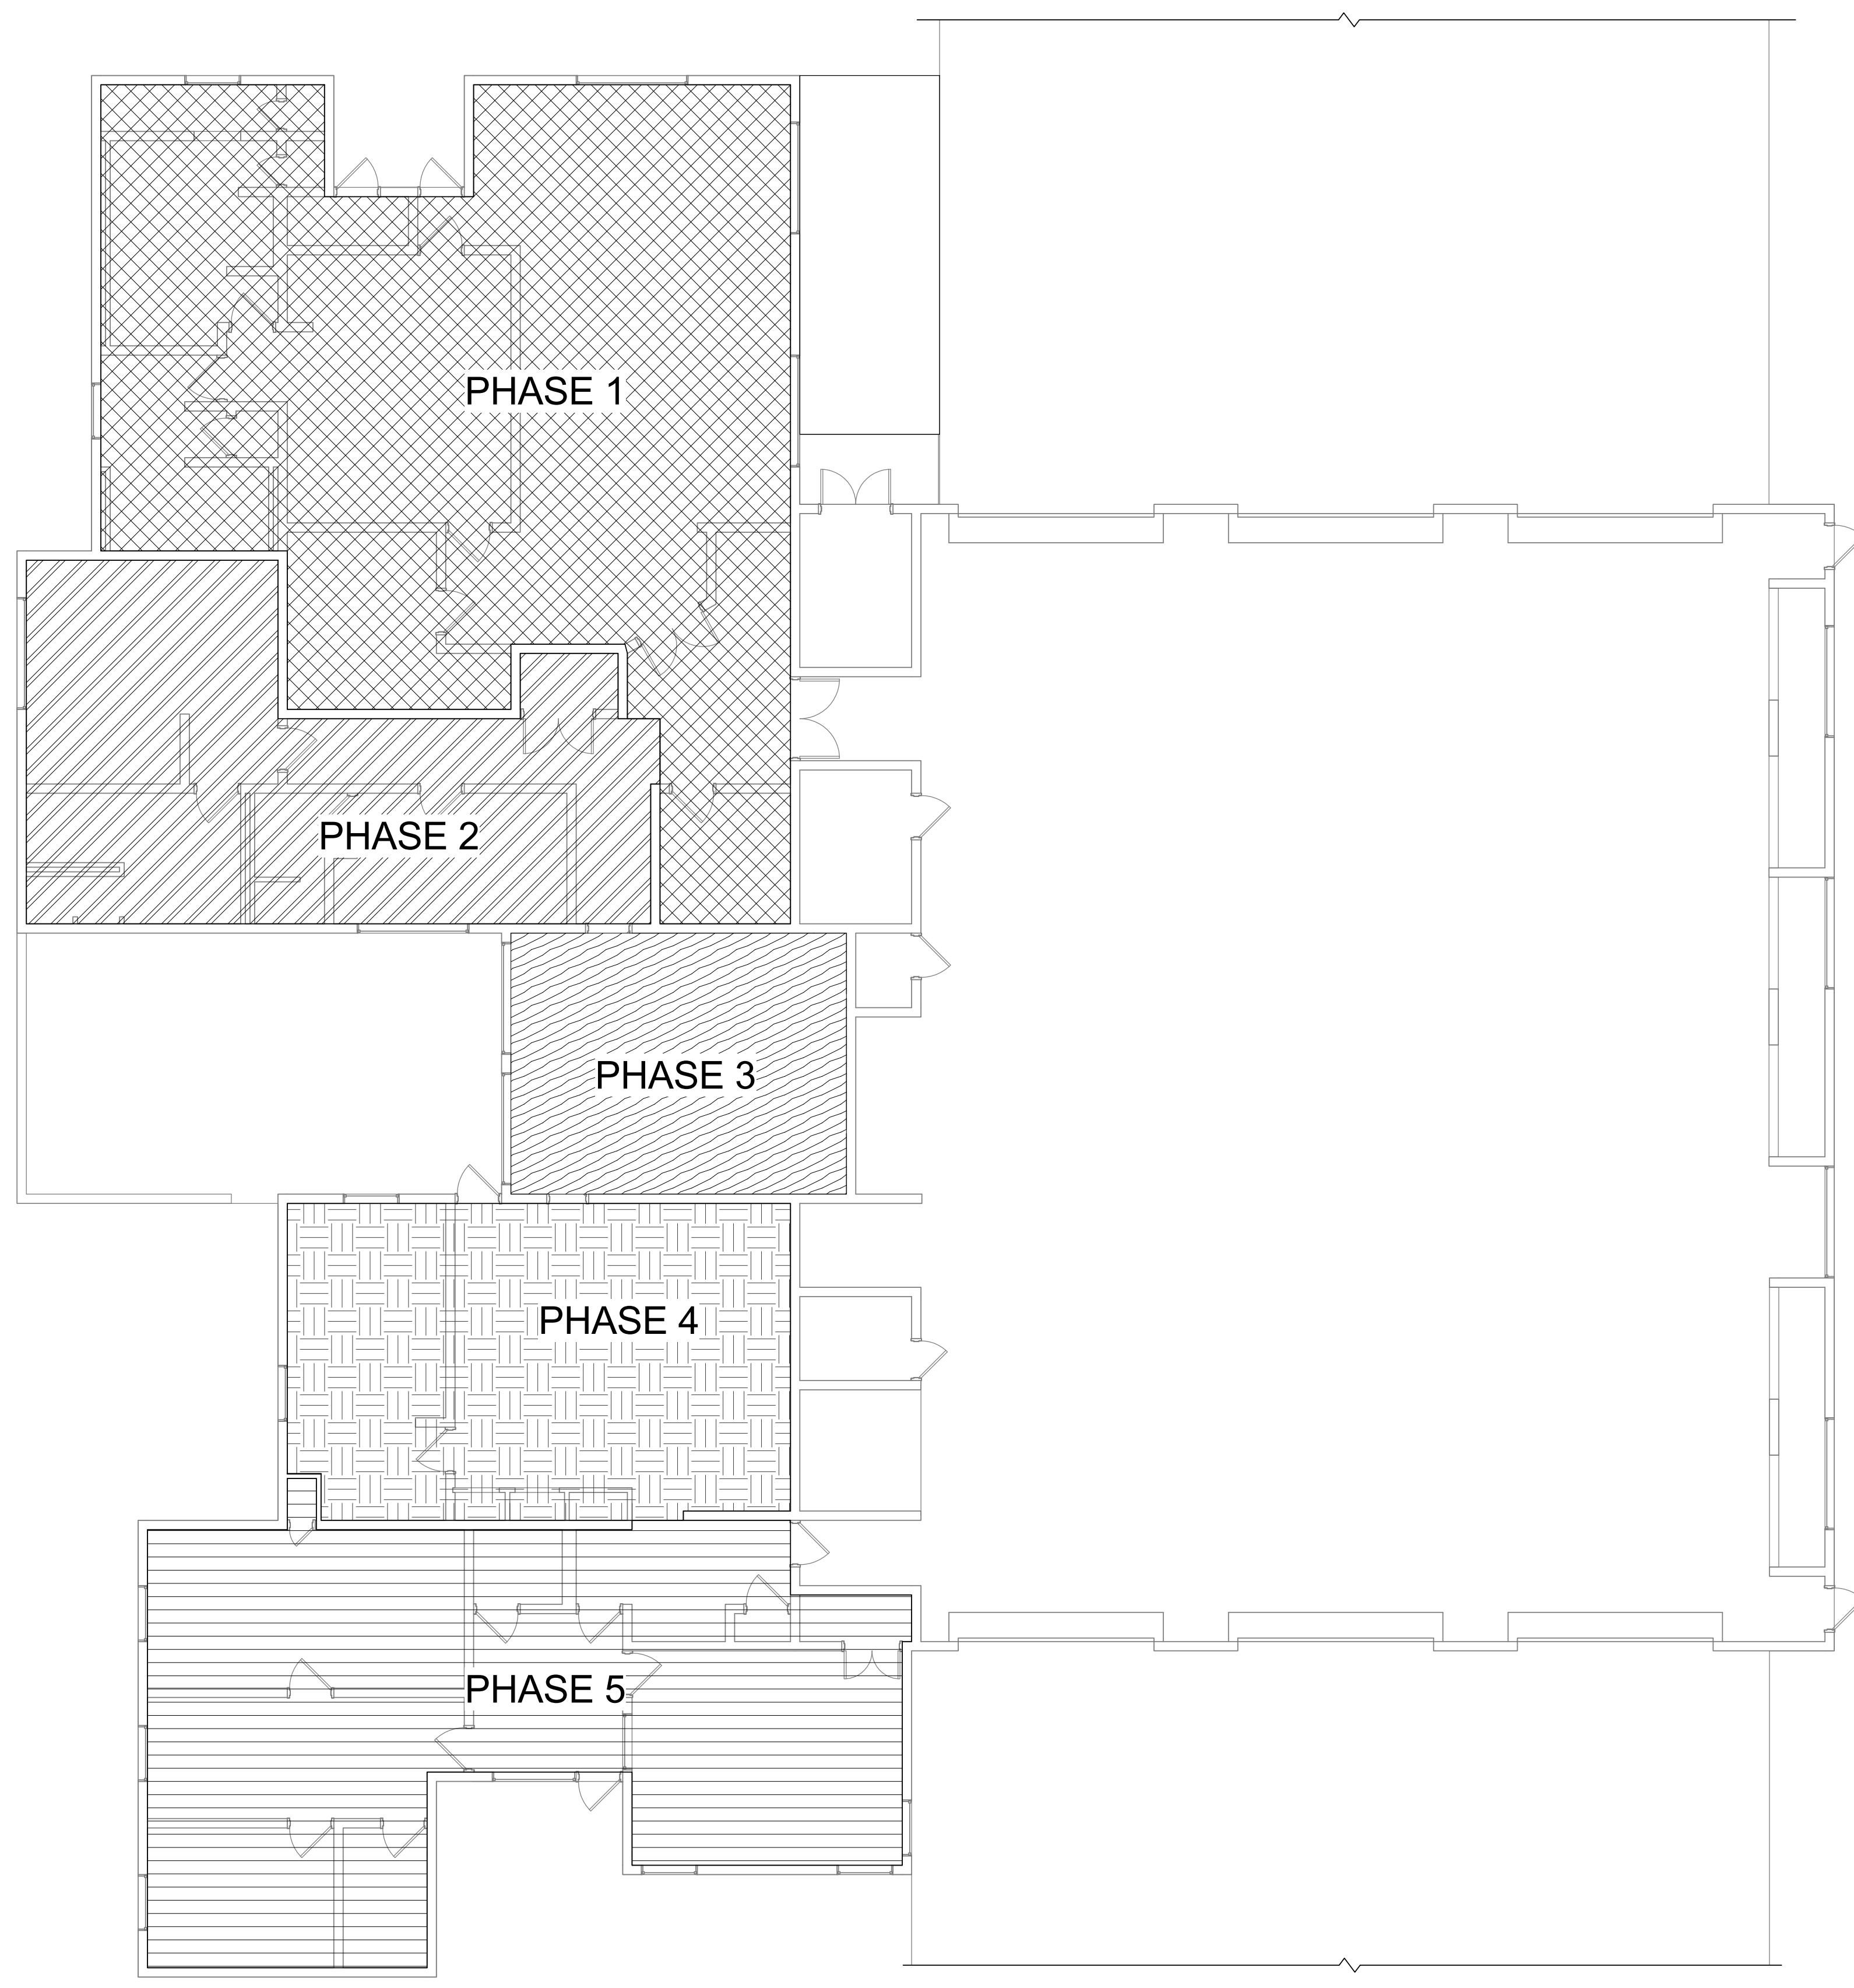\\mlm-fs1\company\MLM-Projects\17651-4-P- Fire Station 30\0000 WORKING\17651-CENTRAL.rvt



A1 PHASING FLOOR PLAN
 1/8" = 1'-0"

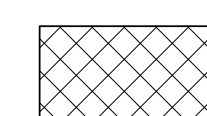PHASING LEGEND

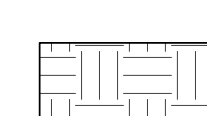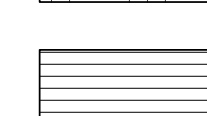-  PHASE 1
-  PHASE 2
-  PHASE 3
-  PHASE 4
-  PHASE 5

SEE MECHANICAL FOR DISCRPTION OF PHASING



SGM ENGINEERING, INC.
 MEP CONSULTING ENGINEERS
 CA-0006208
 935 Lake Baldwin Lane
 Orlando, FL 32814
 Phone: 407-767-5188
 Fax: 407-767-5772
 www.sgmengineering.com
 Copyright © 2018 SGM Engineering, Inc.
 SGM Project Number 2018-233



MLM-MARTIN ARCHITECTS, INC.
 668 N. Orlando Avenue
 Suite 107
 Macland, FL 32751
 407.897.6764 ph
 407.894.1338 fax

Client Name:
ORANGE COUNTY
 FIRE STATION #30
 20 SOUTH HASTINGS ST.
 ORLANDO, FL 32835



Issue: PERMIT DOCUMENTS 02-07-19


NO.	DESCRIPTION	DATE

Project Name:
ORANGE COUNTY
FIRE STATION #30
HVAC REPLACEMENT

Scale: AS NOTED	Seal:
Design By: MLM	
Drawn By: ST	
Checked By: MAM-AA	
Architect of Record: MIGUEL LAZARO MARTIN	
License Number: AR 8255	

Sheet Name:
PHASING PLAN

Sheet Number:
A-1.1.4

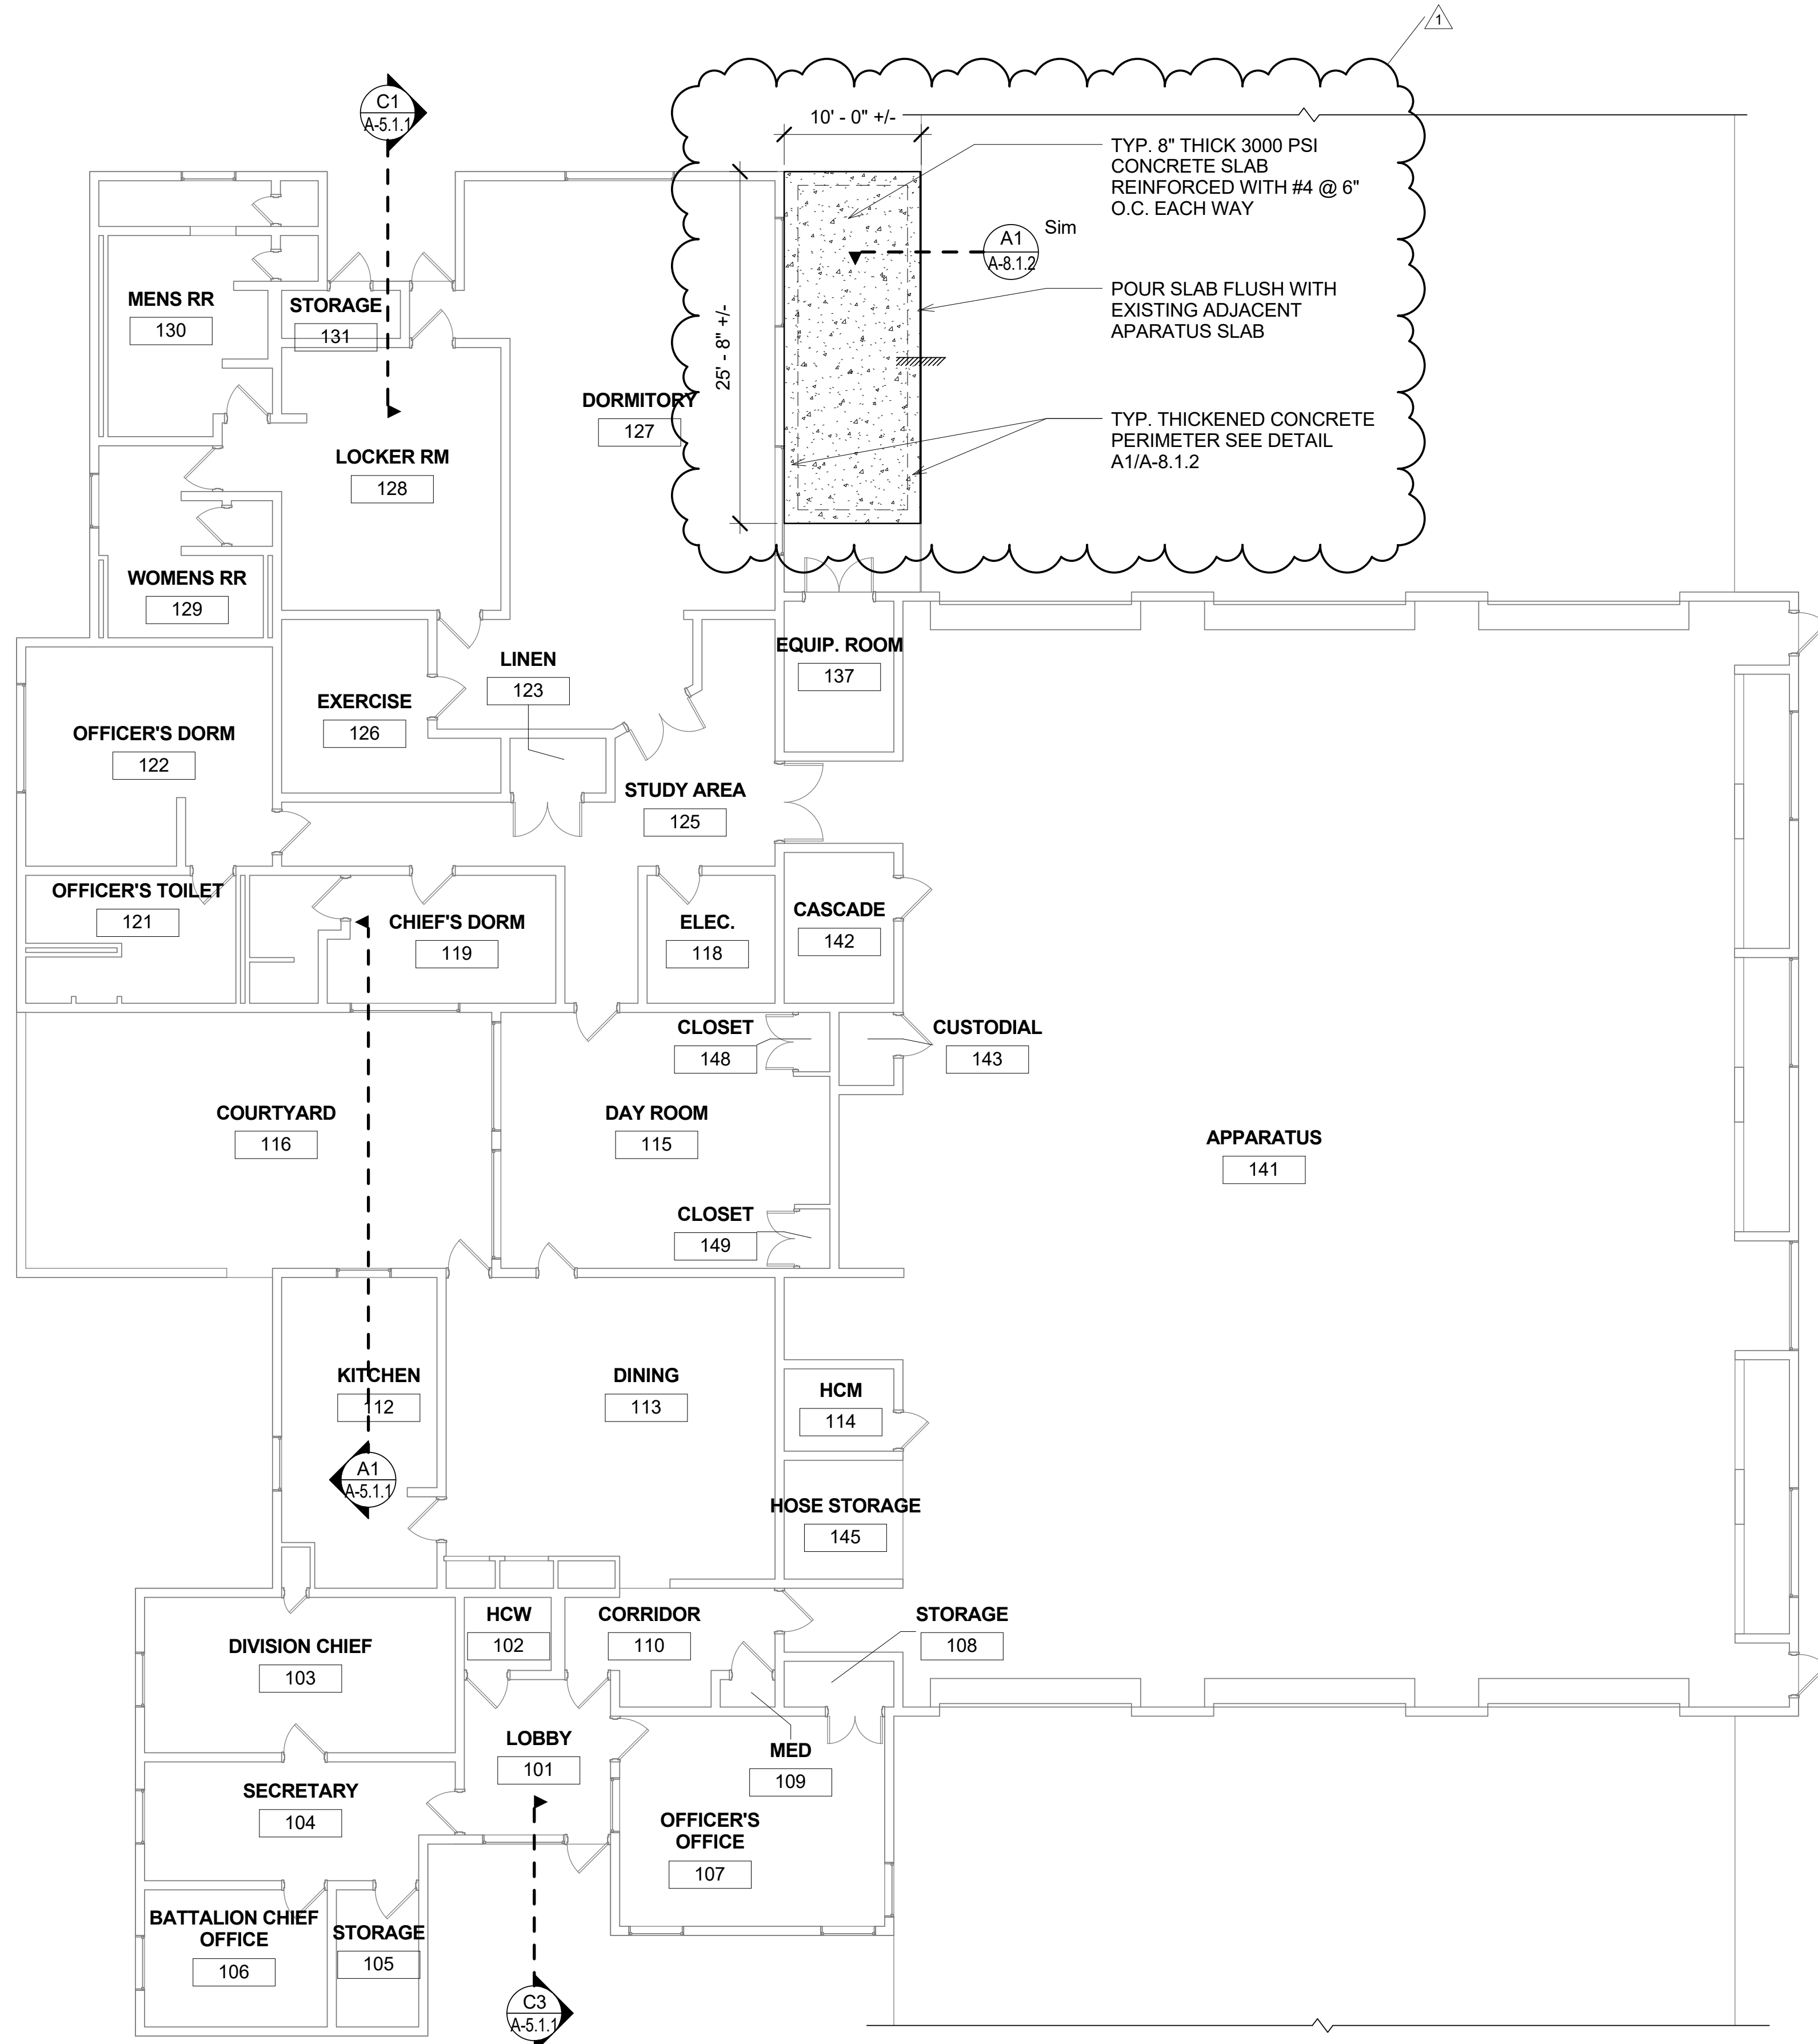

A1 **LEVEL 1 FLOOR PLAN**
1/8" = 1'-0"

Keynote Legend	
Key Value	Keynote Text


SGM ENGINEERING, INC.
MEP CONSULTING ENGINEERS
 CA-0006208
 935 Lake Baldwin Lane
 Orlando, FL 32814
 Phone: 407-767-5188
 Fax: 407-767-5772
 www.sgmengineering.com
 Copyright © 2018 SGM Engineering, Inc.
 SGM Project Number 2018-233


MLM-MARTIN
ARCHITECTS, INC.
 668 N. Orlando Avenue 407.897.6764 ph
 Suite 107 407.894.1338 fax
 Maitland, FL 32751

Client Name:

ORANGE COUNTY
 FIRE STATION #30
 20 SOUTH HASTINGS ST.
 ORLANDO, FL 32835



Issue: PERMIT DOCUMENTS 02-07-19

NO.	DESCRIPTION	DATE
1	PRE-BID RFI	05/15/2019

Project Name:

ORANGE COUNTY
 FIRE STATION #30
 HVAC REPLACEMENT

Scale:	AS NOTED	Seal:
Design By:	MLM	
Drawn By:	ST	
Checked By:	MAM-AA	
Architect of Record:	MIGUEL LAZARO MARTIN	
License Number:	AR 8255	


Sheet Name:

FLOOR PLAN

Sheet Number:

A-2.1.1

\\mlm-fs1\company\MLM-Projects\17651-4-P- Fire Station 30\0000 WORKING\17651-CENTRAL.rvt

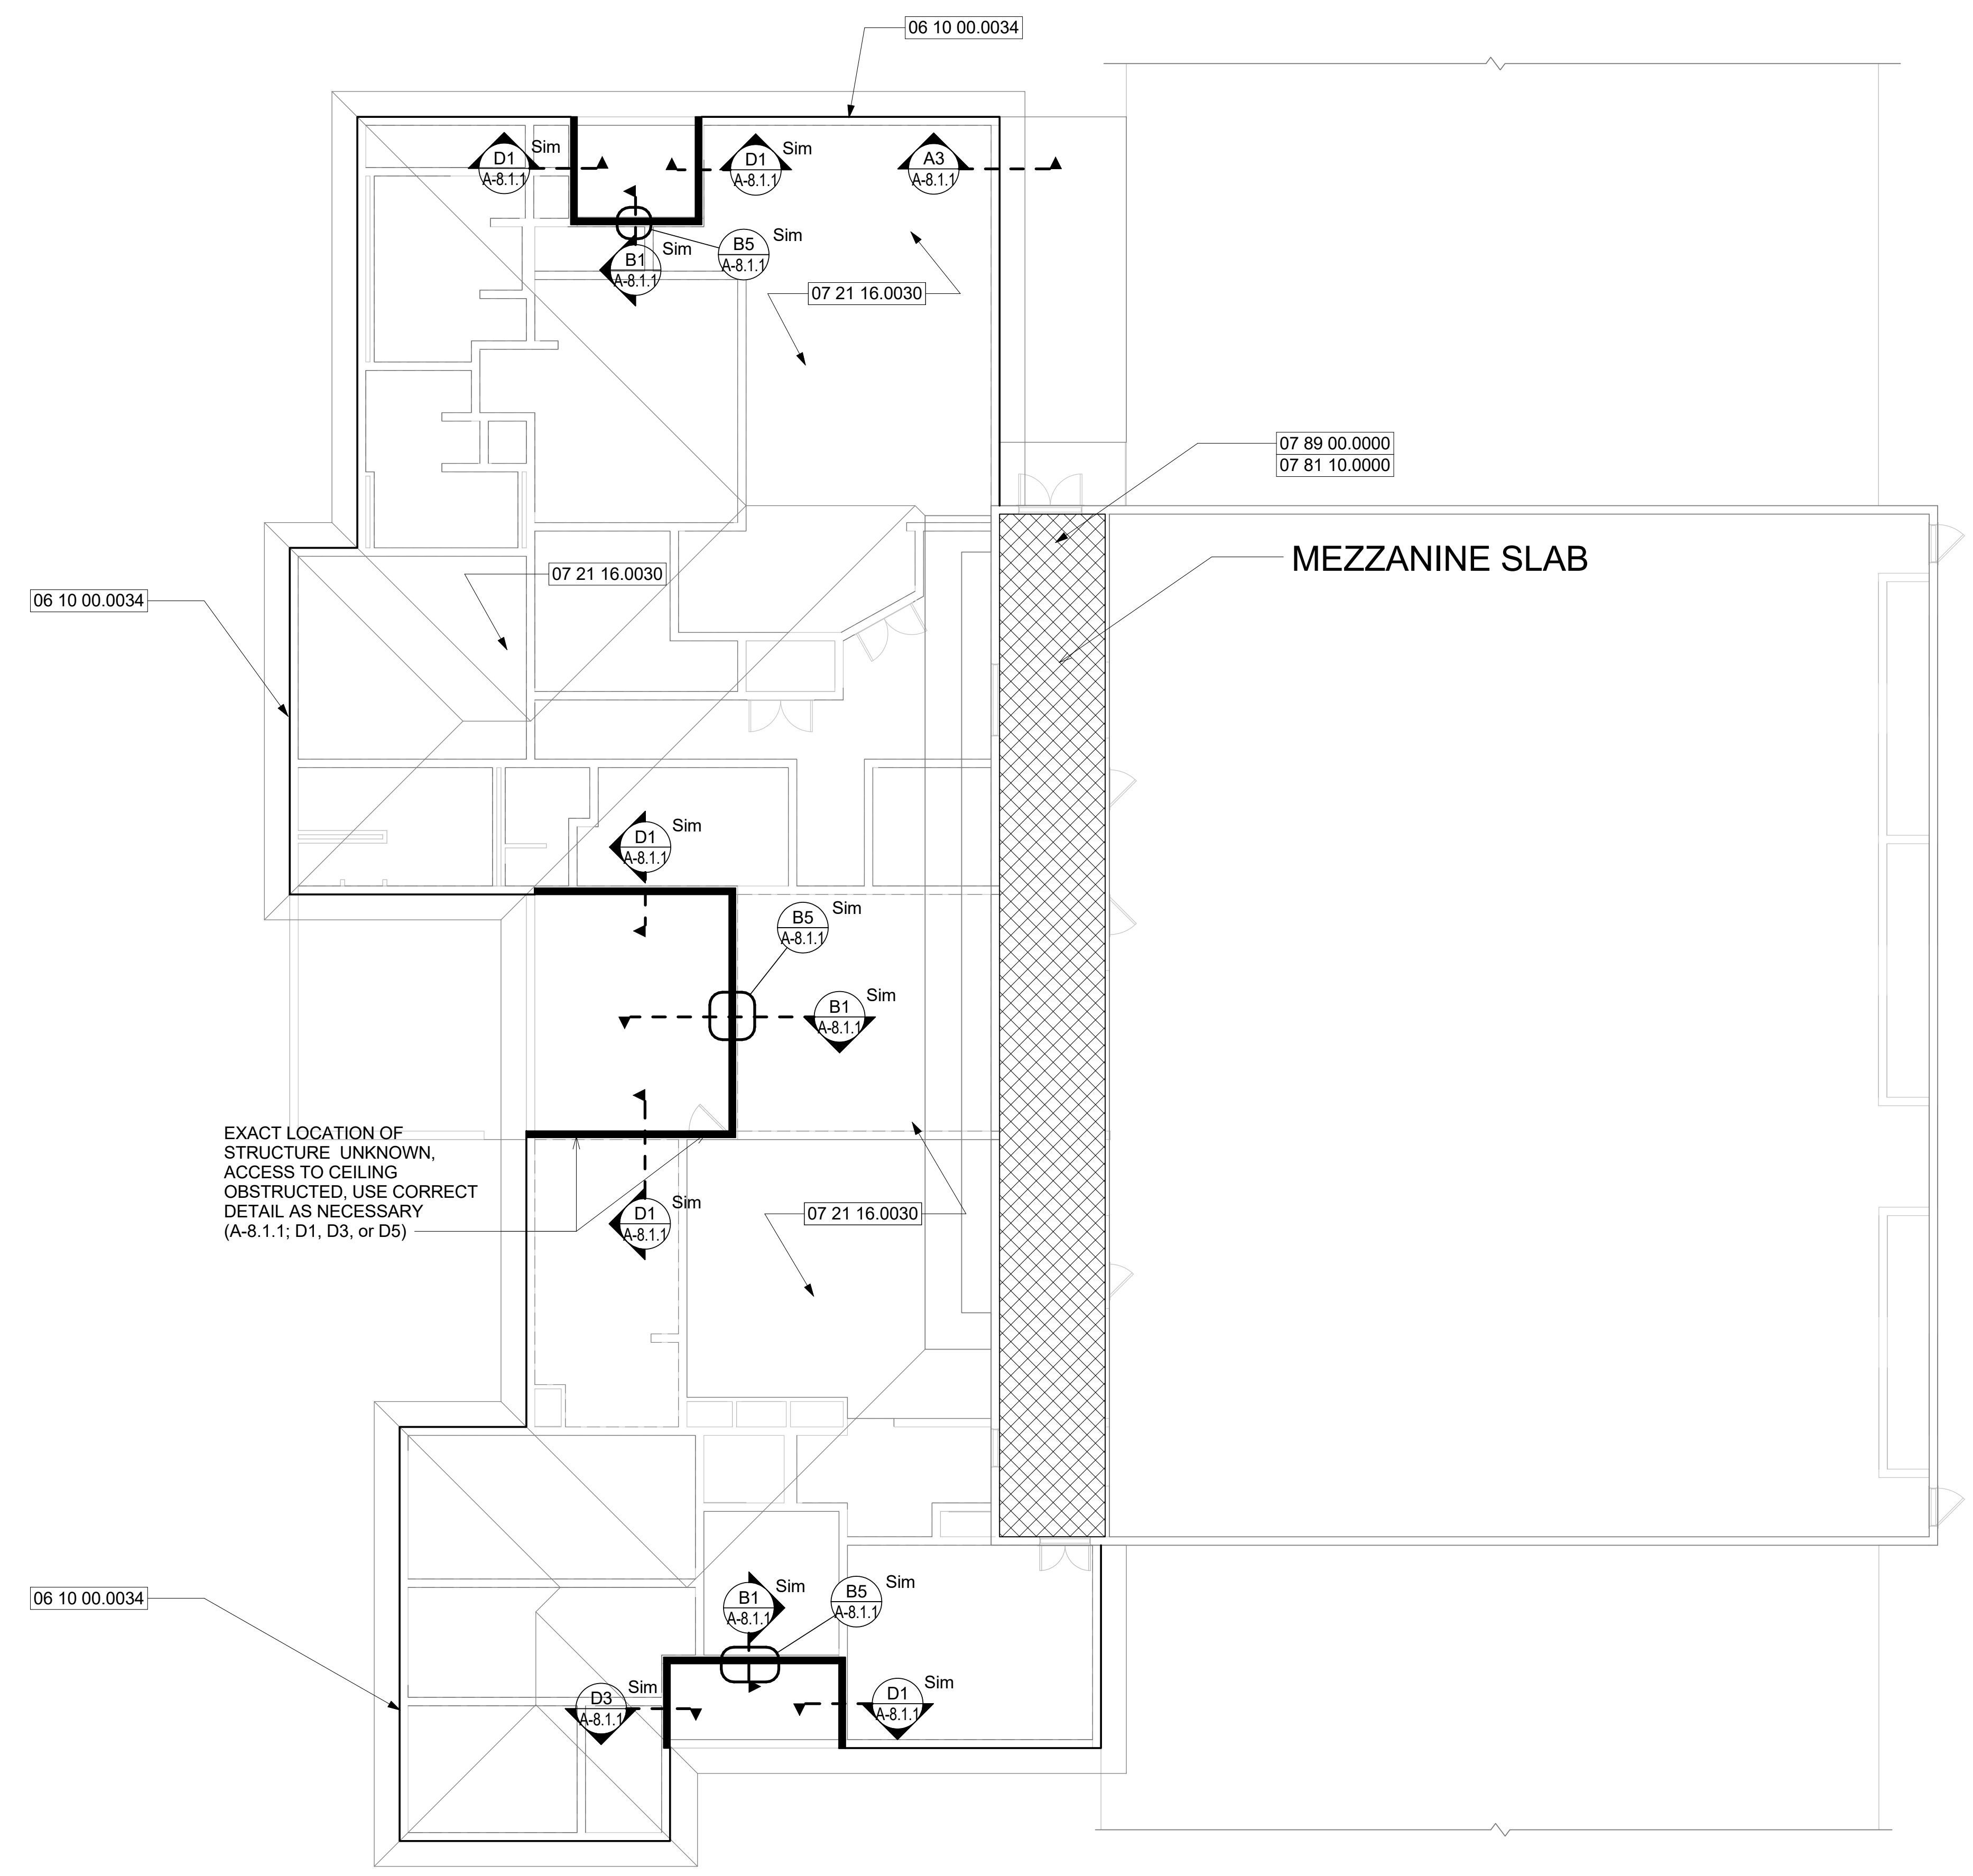

A1 **MEZZANINE**
1/8" = 1'-0"

Keynote Legend	
Key Value	Keynote Text
06 10 00.0034	TYP. 3/4" C.D.X. PLYWOOD ALONG OUTSIDE EDGE OF EXTERIOR WALLS.
07 21 16.0030	TYP. BLANKET INSULATION, R-30 SECURED WITH GALVANIZED STEEL MESH OVER ALL AREAS IN SCOPE, EXCLUDING MEZZANINE.
07 81 10.0000	TYP. FIRE STOPPING MATERIAL.
07 89 00.0000	TYP. DRAFTSTOPPING MATERIAL AT PENETRATIONS, VERTICAL OR HORIZONTAL AT WALLS.

SGM ENGINEERING, INC.
MEP CONSULTING ENGINEERS
CA-0006208
935 Lake Baldwin Lane
Orlando, FL 32814
Phone: 407-767-5188
Fax: 407-767-5772
www.sgmengineering.com
Copyright © 2018 SGM Engineering, Inc.
SGM Project Number 2018-233

MLM-MARTIN ARCHITECTS, INC.
668 N. Orlando Avenue
Suite 107
Maitland, FL 32751
407.897.6764 ph
407.894.1338 fax

Client Name:
**ORANGE COUNTY
FIRE STATION #30
20 SOUTH HASTINGS ST.
ORLANDO, FL 32835**



Issue: PERMIT DOCUMENTS 02-07-19

NO.	DESCRIPTION	DATE

Project Name:
**ORANGE COUNTY
FIRE STATION #30
HVAC REPLACEMENT**

Scale:	AS NOTED	Seal:	
Design By:	MLM		
Drawn By:	ST		
Checked By:	MAM-AA		
Architect of Record:	MIGUEL LAZARO MARTIN		
License Number:	AR 8255		

Sheet Name:
MEZZANINE PLAN

Sheet Number:
A-2.1.2

\\mlm-fs1\company\MLM-Projects\17651-4-P - Fire Station 30\0000 WORKING\17651-CENTRAL.rvt



A1 REFLECTED CEILING PLAN
1/8" = 1'-0"

Keynote Legend	
Key Value	Keynote Text
07 42 93.0000	TYP. ALUM SYSTEM SOFFIT & CEILING.
09 51 23.0000	TYP. ACCOUSTIC LAY IN PANELS AND GRID SYSTEM.
09 51 23.0001	TYP. VINYL FACED GYPSUM: 24" X 24" X 5/8" CLASS A, MOLD AND MILDEW RESISTANT, HUMIGUARD WITH 15/16" PRELUDE LAY IN CEILING PANELS . ARMSTRONG KITCHEN ZONE #673 OR APPROVED EQUAL.

CEILING LEGEND

- TYP. 2X2 ACCOUSTIC CEILING TILE
- TYP. 2X2 KITCHEN ACCOUSTIC CEILING TILE
- TYP. GYPSUM CEILING - 1
- TYP. GYPSUM CEILING - 2
- NON-PERFORATED ALUMINIM SOFFIT
- 2X4 MOUNTED CEILING LIGHT
- 2X2 MOUNTED CEILING LIGHT
- 1X4 MOUNTED CEILING LIGHT
- CIRCULAR RECESSED CEILING LIGHT
- HVAC SUPPLY
- HVAC RETURN
- CEILING MOUNTED SPEAKER
- EXISTING SPRINKLER TO REMAIN
- EXIT LAMPS

SGM ENGINEERING, INC.
MEP CONSULTING ENGINEERS
CA-0006208
935 Lake Baldwin Lane
Orlando, FL 32814
Phone: 407-767-5188
Fax: 407-767-5772
www.sgmengineering.com
Copyright © 2018 SGM Engineering, Inc.
SGM Project Number 2018-233

MLM-MARTIN ARCHITECTS, INC.
668 N. Orlando Avenue 407 897 6764 ph
Suite 107 407 894 1338 fax
Maitland, FL 32751

Client Name:
ORANGE COUNTY FIRE STATION #30
20 SOUTH HASTINGS ST.
ORLANDO, FL 32835



Issue: PERMIT DOCUMENTS 02-07-19

NO.	DESCRIPTION	DATE


Project Name:
ORANGE COUNTY FIRE STATION #30 HVAC REPLACEMENT

Scale: AS NOTED	Seal:
Design By: MLM	
Drawn By: ST	
Checked By: MAM-AA	
Architect of Record: MIGUEL LAZARO MARTIN	
License Number: AR 8255	

Sheet Name:
CEILING PLAN


Sheet Number:
A-2.2.1

\\mim-fs1\company\MLM-Projects\17651-4-P- Fire Station 30\0000 WORKING\17651-CENTRAL.rvt

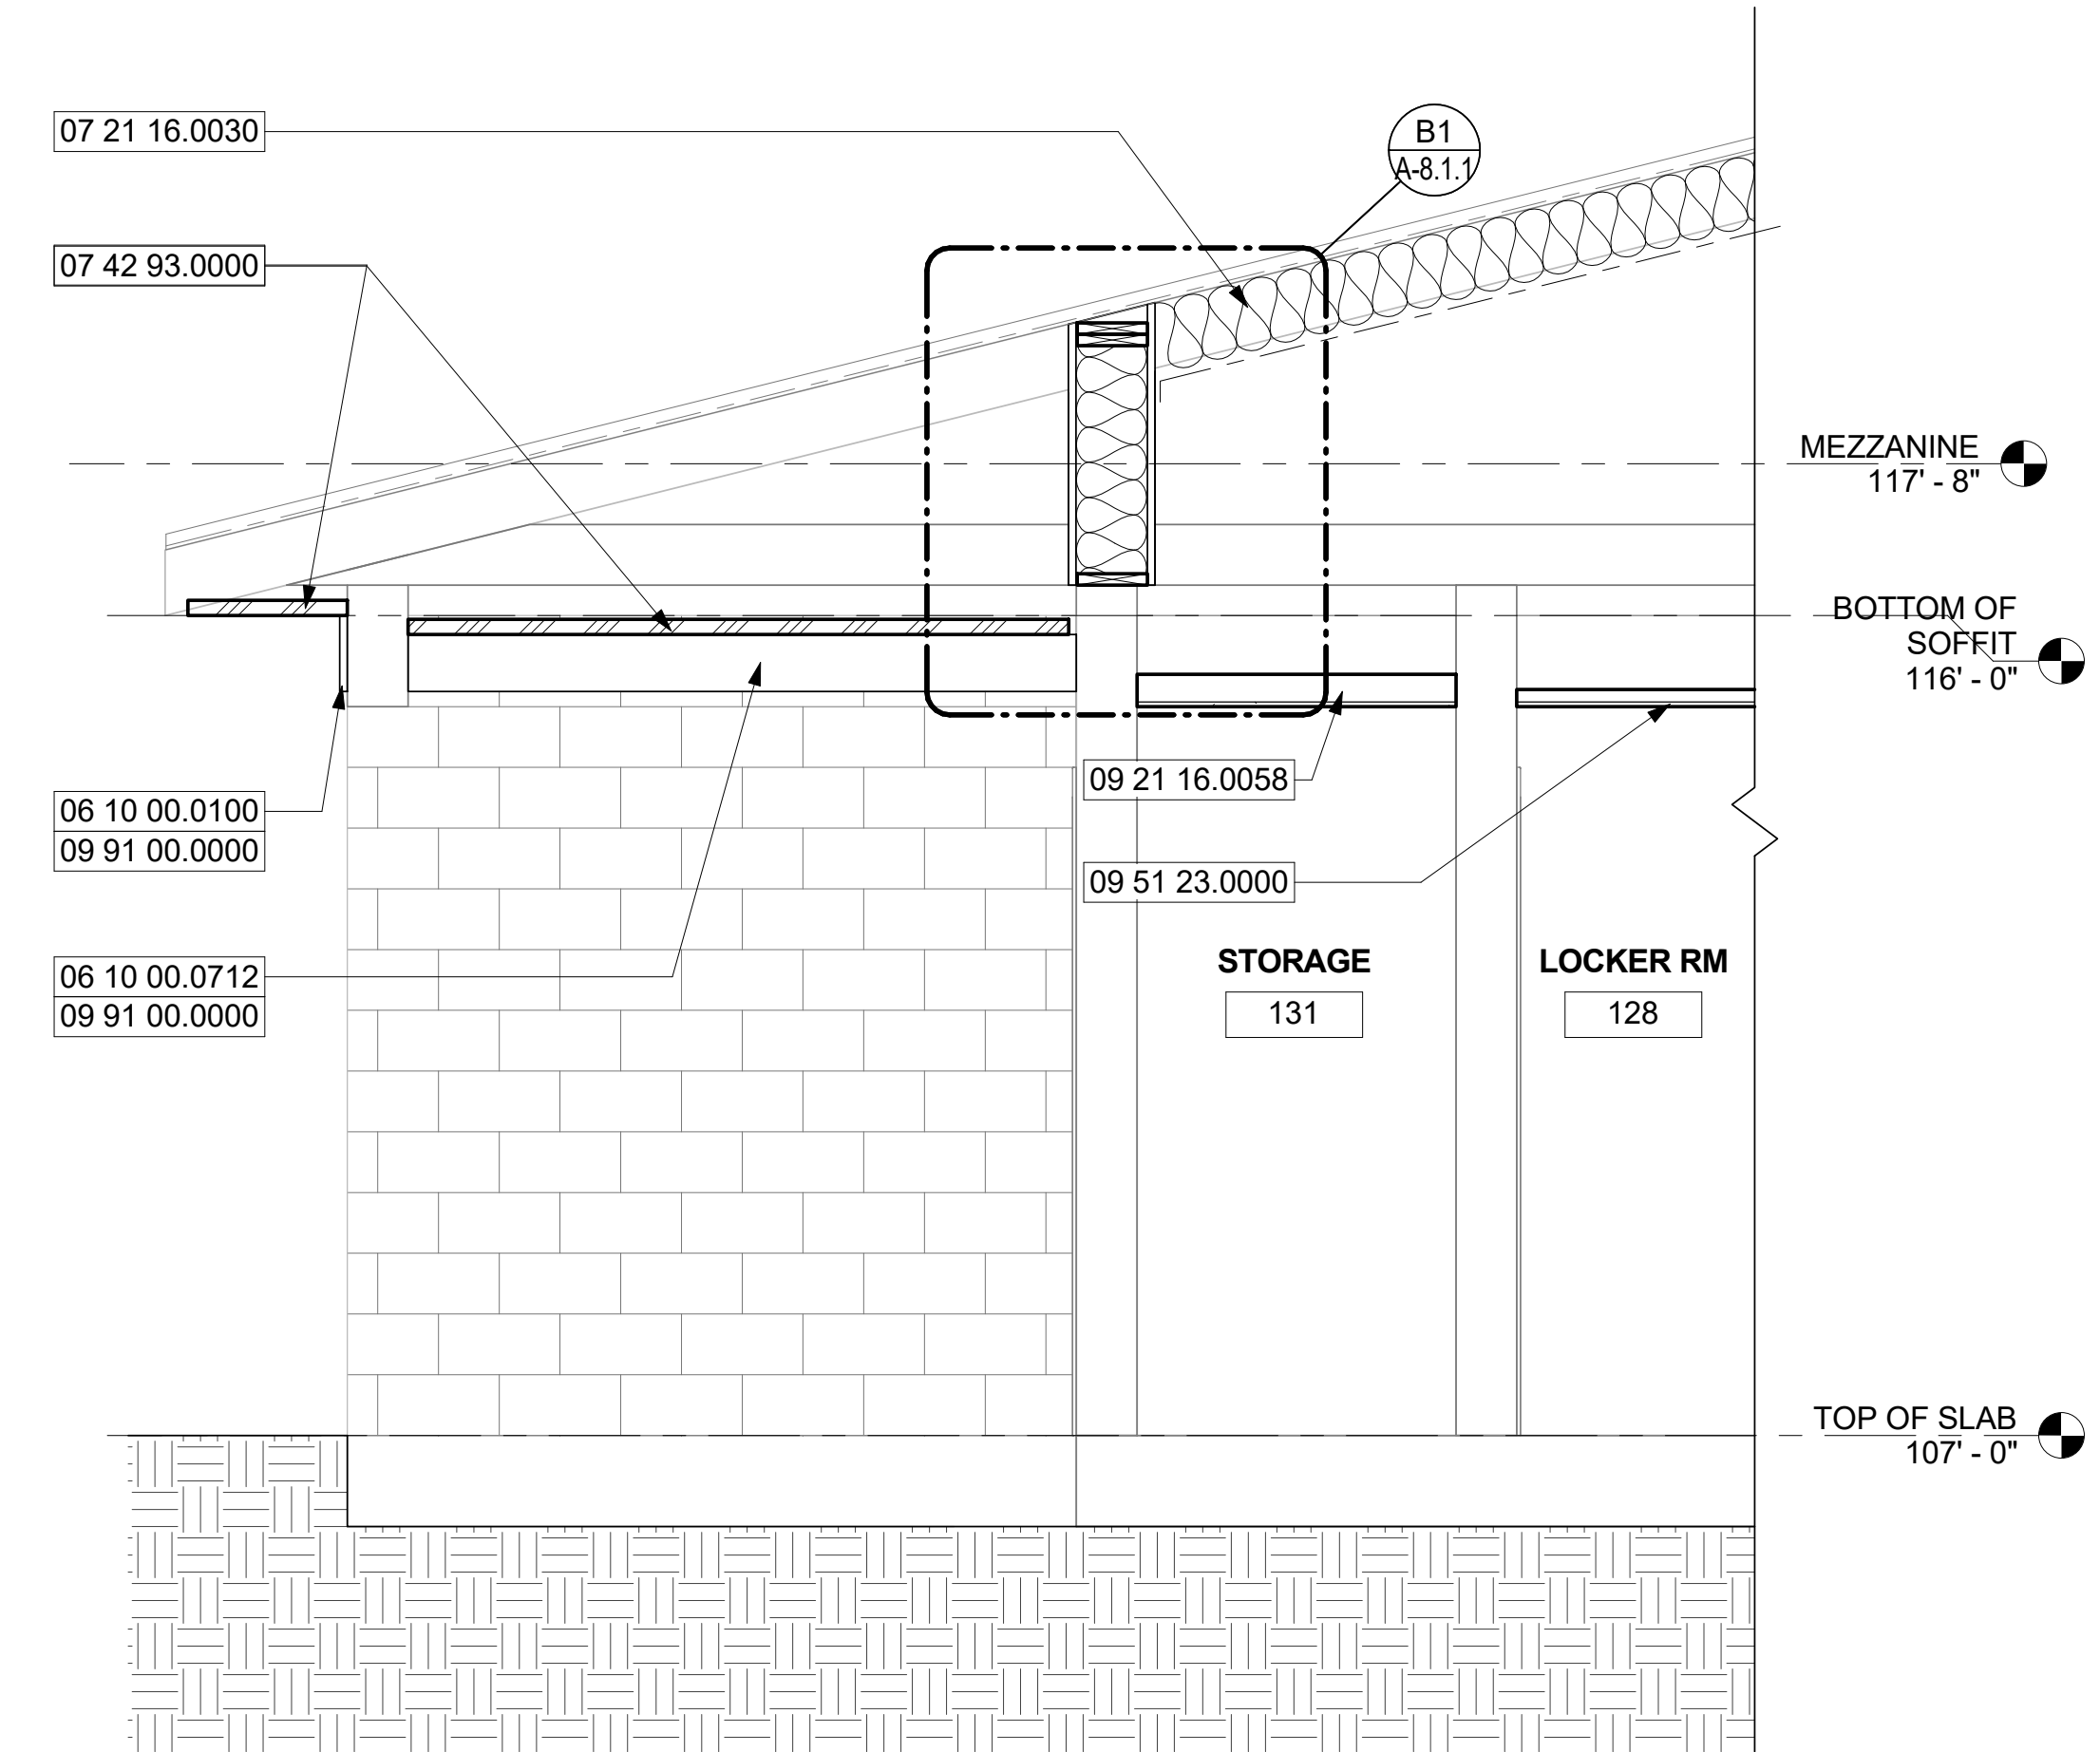


NEW SOFFIT ENCLOSURE DETAIL

C1
1
1/2" = 1'-0"

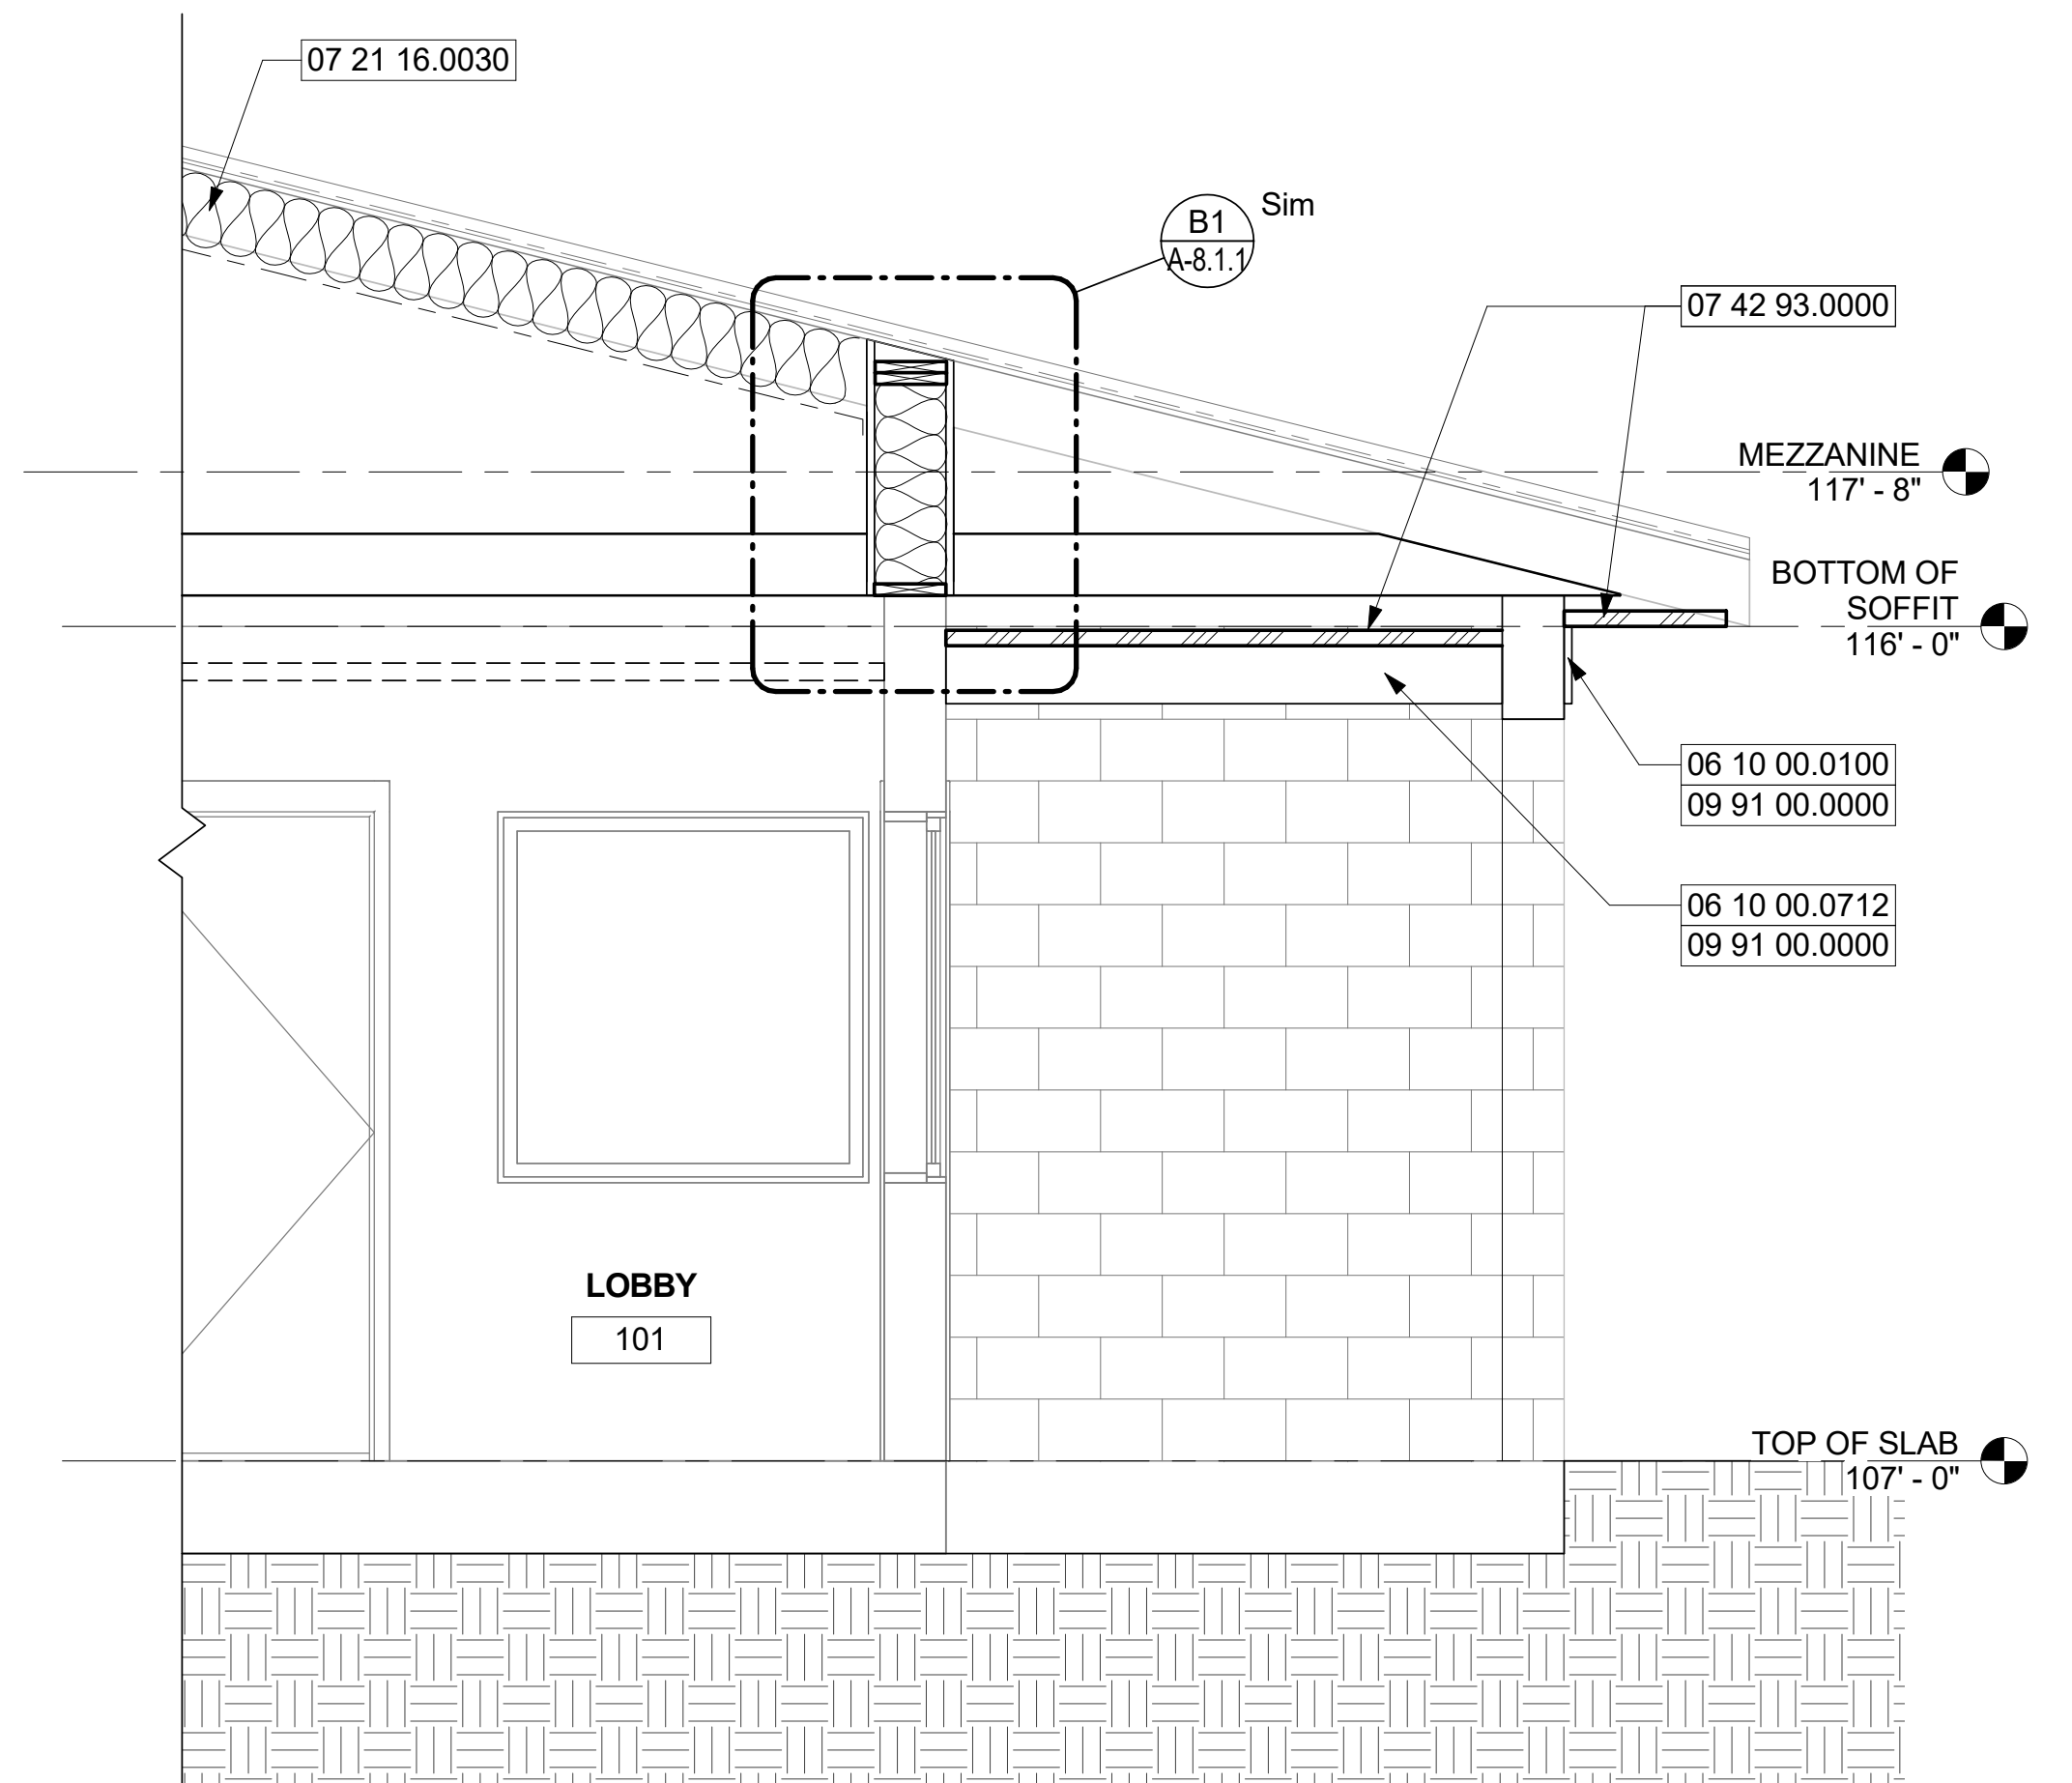

NEW SOFFIT ENCLOSURE DETAIL

C3
3
1/2" = 1'-0"

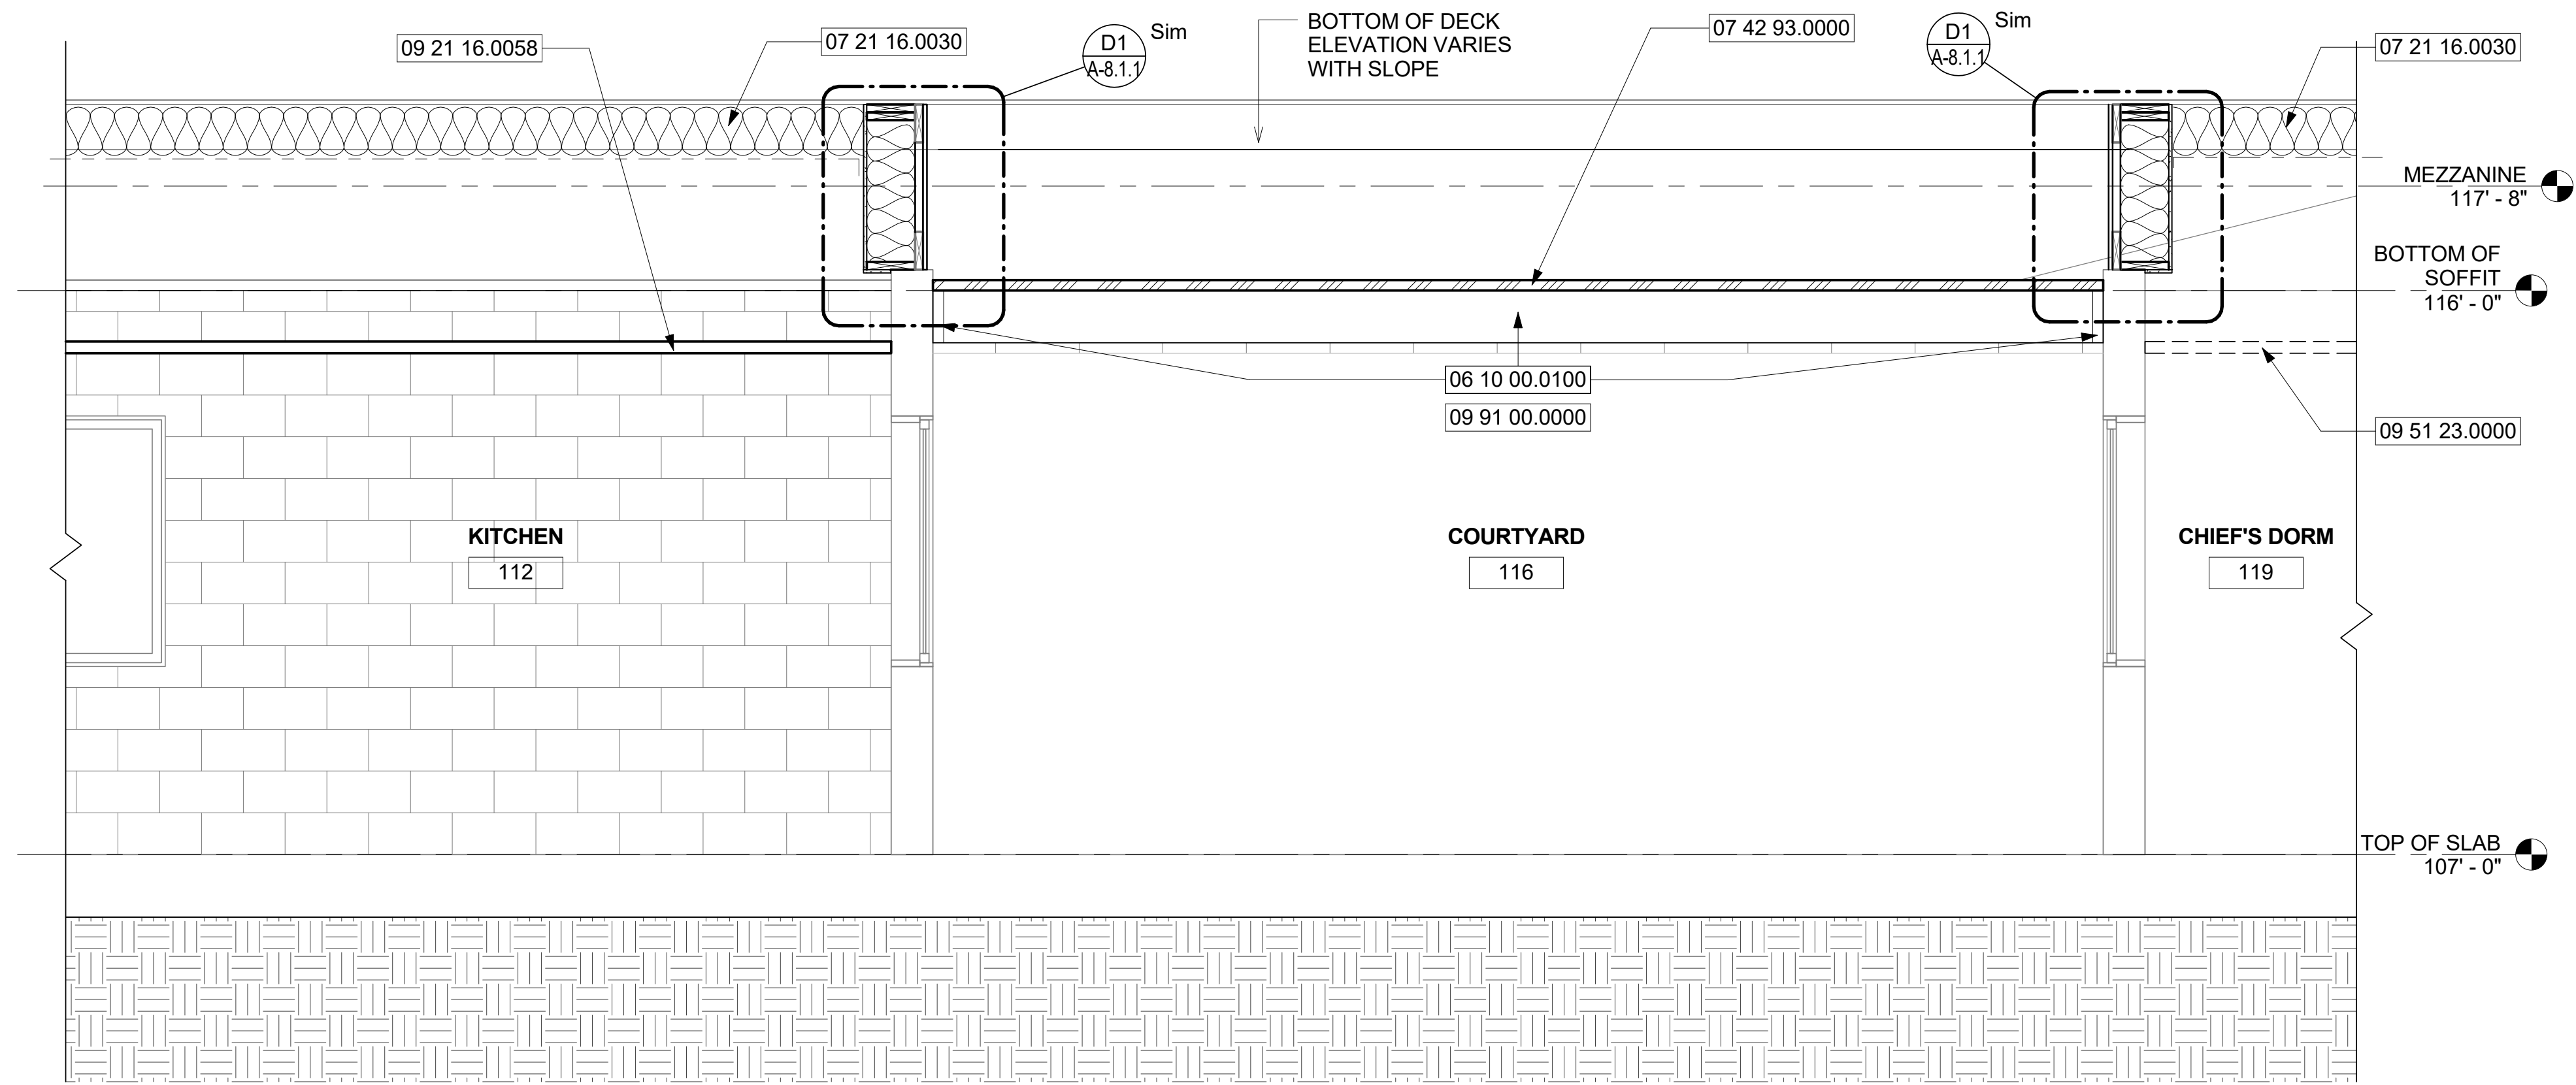

NEW SOFFIT ENCLOSURE DETAIL

A1
2
1/2" = 1'-0"

Keynote Legend	
Key Value	Keynote Text
06 10 00.0100	TYP. WHITE, RUSTIC STYLE HARDIE BOARD. PAINTED. 3/4" X 10"
06 10 00.0712	TYP. WHITE, RUSTIC STYLE HARDIE BOARD. PAINTED. 3/4" X 7 1/2"
07 21 16.0030	TYP. BLANKET INSULATION, R-30 SECURED WITH GALVANIZED STEEL MESH OVER ALL AREAS IN SCOPE, EXCLUDING MEZZANINE.
07 42 93.0000	TYP. ALUM SYSTEM SOFFIT & CEILING.
09 21 16.0058	TYP. 5/8" GWB"
09 51 23.0000	TYP. ACCOUSTIC LAY IN PANELS AND GRID SYSTEM.
09 91 00.0000	TYP. PAINT


SGM ENGINEERING, INC.
MEP CONSULTING ENGINEERS
 CA-0006208
 935 Lake Baldwin Lane
 Orlando, FL 32814
 Phone: 407-767-5188
 Fax: 407-767-5772
 www.sgmengineering.com
 Copyright © 2018 SGM Engineering, Inc.
 SGM Project Number 2018-233


MLM-MARTIN ARCHITECTS, INC.
668 N. Orlando Avenue
 Suite 107
 Maitland, FL 32751
 407.897.6764 ph
 407.894.1338 fax

Client Name:
ORANGE COUNTY FIRE STATION #30
20 SOUTH HASTINGS ST.
ORLANDO, FL 32835



Issue: PERMIT DOCUMENTS 02-07-19

NO.	DESCRIPTION	DATE

Project Name:
ORANGE COUNTY FIRE STATION #30 HVAC REPLACEMENT

Scale:	AS NOTED	Seal:
Design By:	MLM	
Drawn By:	ST	
Checked By:	MAM-AA	
Architect of Record:	MIGUEL LAZARO MARTIN	
License Number:	AR 8255	

Sheet Name:
BUILDING SECTIONS

Sheet Number:
A-5.1.1

\\mim-fs1\company\MLM-Projects\17651-4-P- Fire Station 30\0000 WORKING\17651-CENTRAL.rvt

ROOM FINISH SCHEDULE					
NUMBER	NAME	CEILING			REMARKS
		FINISH	CODE	HEIGHT	
101	LOBBY	ACT	FF	8' - 5"	
102	HCV	GWB-1	P1	8' - 0"	
103	DIVISION CHIEF	ACT	FF	8' - 0"	
104	SECRETARY	ACT	FF	8' - 0"	
105	STORAGE	ACT	FF	8' - 0"	
106	BATTALION CHIEF OFFICE	ACT	FF	8' - 0"	
107	OFFICER'S OFFICE	ACT	FF	8' - 0"	
108	STORAGE	ACT	FF	8' - 0"	
109	MED	GWB-1	P1	8' - 0"	
110	CORRIDOR	ACT	FF	8' - 0"	
112	KITCHEN	ACT-2	FF	8' - 0"	
113	DINING	ACT	FF	8' - 8"	
114	HCM	GWB-1	P1	8' - 0"	
115	DAY ROOM	GWB-1	P1		
116	COURTYARD	OPEN	-		
118	ELEC.	ACT	FF	8' - 0"	
119	CHIEF'S DORM	ACT	FF	8' - 0"	
120	CHIEF'S RR	GWB-2	P1	8' - 0"	
121	OFFICER'S TOILET	GWB-2	P1	8' - 0"	
122	OFFICER'S DORM	ACT	FF	8' - 0"	
123	LINEN	GWB-1	P1	8' - 0"	
125	STUDY AREA	ACT	FF	8' - 0"	
126	EXERCISE	ACT	FF	8' - 0"	
127	DORMITORY	ACT	FF	9' - 0"	
128	LOCKER RM	ACT	FF	8' - 0"	
129	WOMENS RR	GWB-2	P1	8' - 0"	
130	MENS RR	GWB-2	P1	8' - 0"	
131	STORAGE	GWB-1	P1	8' - 0"	
137	EQUIP. ROOM	GWB-1	P1	8' - 0"	
141	APPARATUS	OPEN	-	18' - 8"	
142	CASCADE	OPEN	-	8' - 0"	
143	CUSTODIAL	OPEN	-	8' - 0"	
145	HOSE STORAGE	OPEN	-	8' - 0"	
148	CLOSET	GWB-1	P1	8' - 0"	
149	CLOSET	GWB-1	P1	8' - 0"	

CONTRACTOR TO VERIFY AND MATCH EXISTING CEILING HEIGHTS

FINISH KEY	
REMARK	
ACT	TYP. 24" X 24" X 5/8" ACCOUSTIC LAY IN PANELS AND GRID SYSTEM
ACT-2	TYP. VINYL FACED GYPSUM; 24" X 24" X 5/8" CLASS A, MOLD AND MILDEW RESISTANT, HUMIGUARD WITH 15/16" PRELUDE LAY IN CEILING PANELS. ARMSTRONG KITCHEN ZONE #673 OR APPROVED EQUAL
GWB-1	TYP. GYPSUM CEILING
GWB-2	TYP. WATER-RESISTANT GYPSUM CEILING

FINISH CODES	
CODE	
FF	FACTORY FINISH: AS SUPPLIED
P1	PAINT, COLOR TO MATCH EXISTING CEILINGS



SGM ENGINEERING, INC.
 MEP CONSULTING ENGINEERS
 CA-0006208
 935 Lake Baldwin Lane
 Orlando, FL 32814
 Phone: 407-767-5188
 Fax: 407-767-5772
 www.sgmengineering.com
 Copyright © 2018 SGM Engineering, Inc.
 SGM Project Number 2018-233



MLM-MARTIN ARCHITECTS, INC.
 668 N. Orlando Avenue
 Suite 107
 Maitland, FL 32751
 407.897.6764 ph
 407.894.1338 fax

Client Name:
ORANGE COUNTY
 FIRE STATION #30
 20 SOUTH HASTINGS ST.
 ORLANDO, FL 32835



Issue: PERMIT DOCUMENTS 02-07-19


NO.	DESCRIPTION	DATE

Project Name:
ORANGE COUNTY
FIRE STATION #30
HVAC REPLACEMENT


Scale:	AS NOTED	Seal:
Design By:	MLM	
Drawn By:	ST	
Checked By:	MAM-AA	
Architect of Record:	MIGUEL LAZARO MARTIN	
License Number:	AR 8255	

Sheet Name:
ROOM FINISH SCHEDULE


Sheet Number:
A-7.1.1

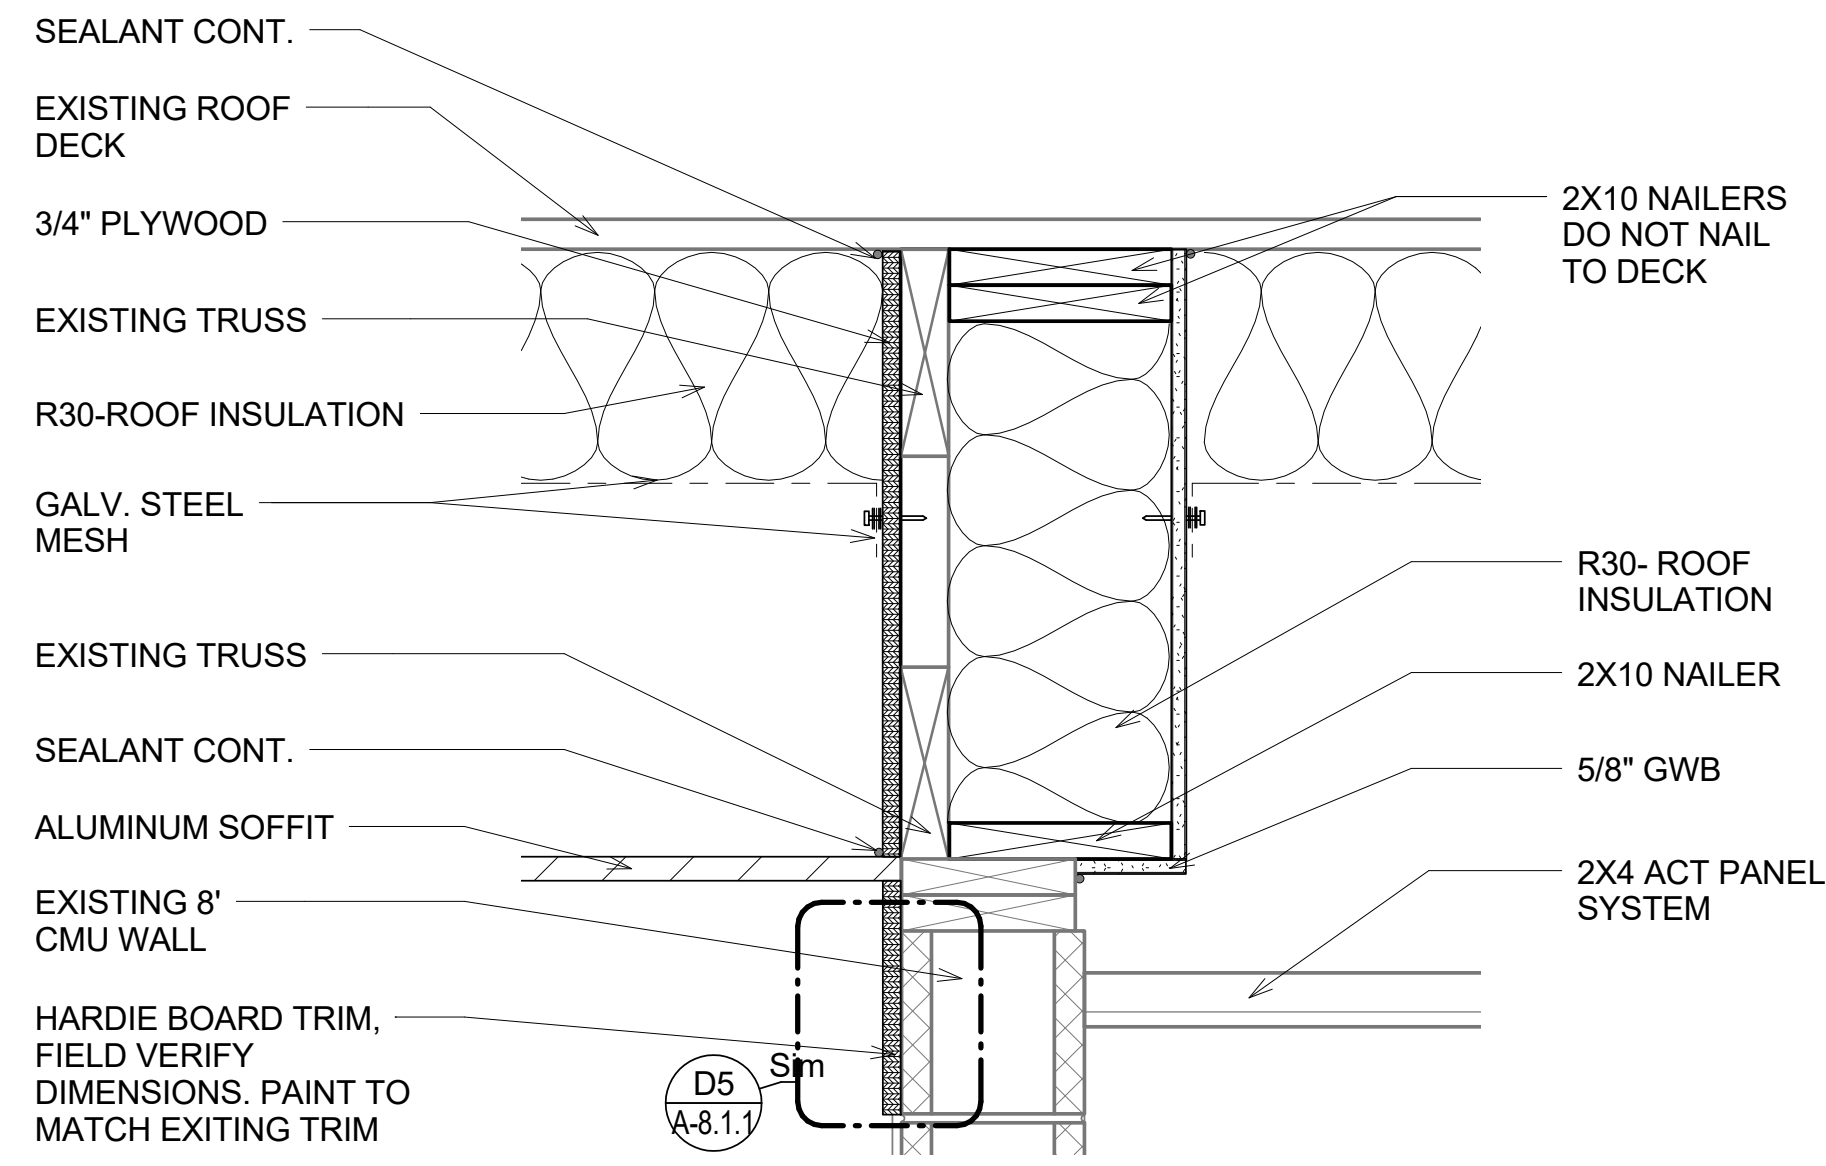


D1
TYP. INSULATION AT DETAIL
PARALLEL TO TRUSS A
1 1/2" = 1'-0"

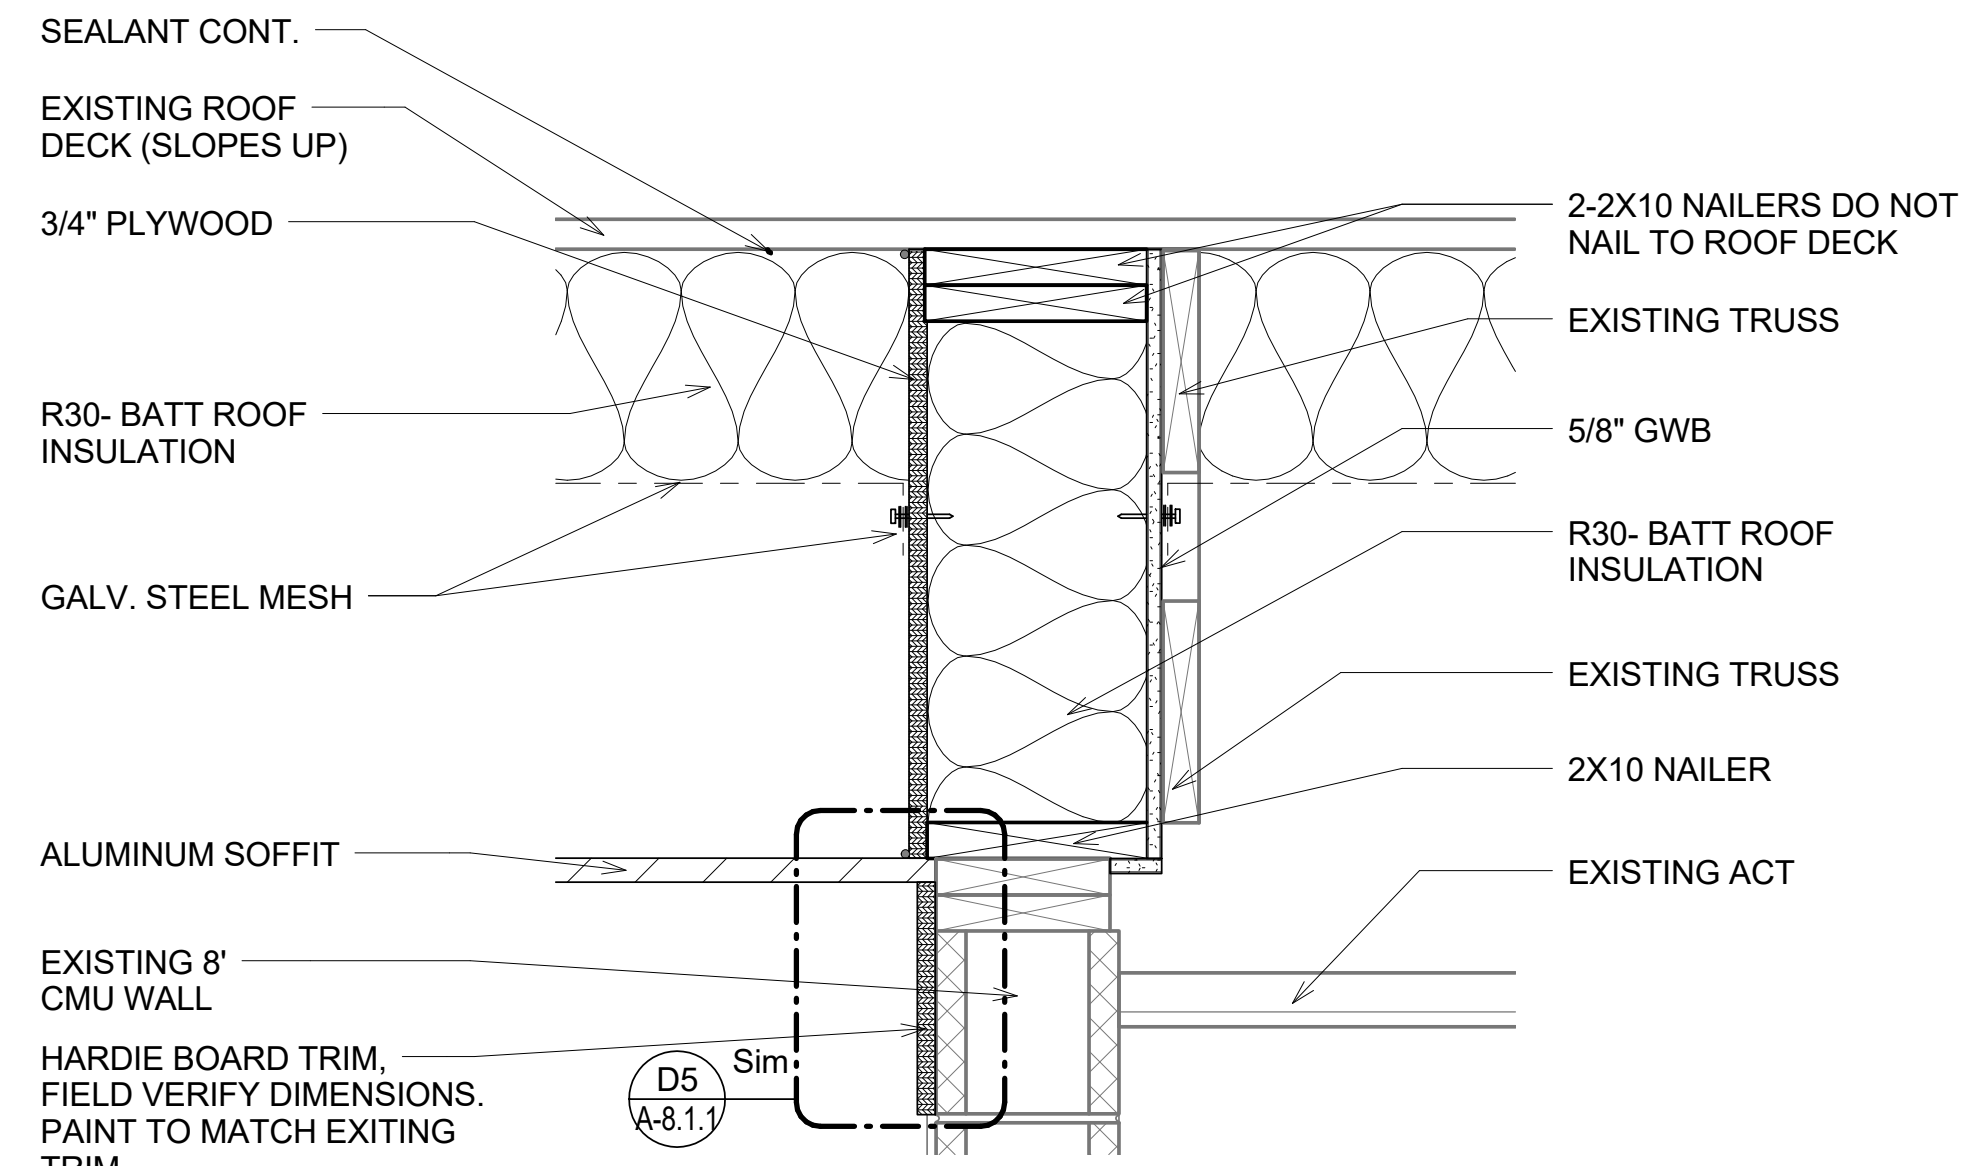


D3
TYP. INSULATION AT DETAIL
PARALLEL TO TRUSS B
1 1/2" = 1'-0"

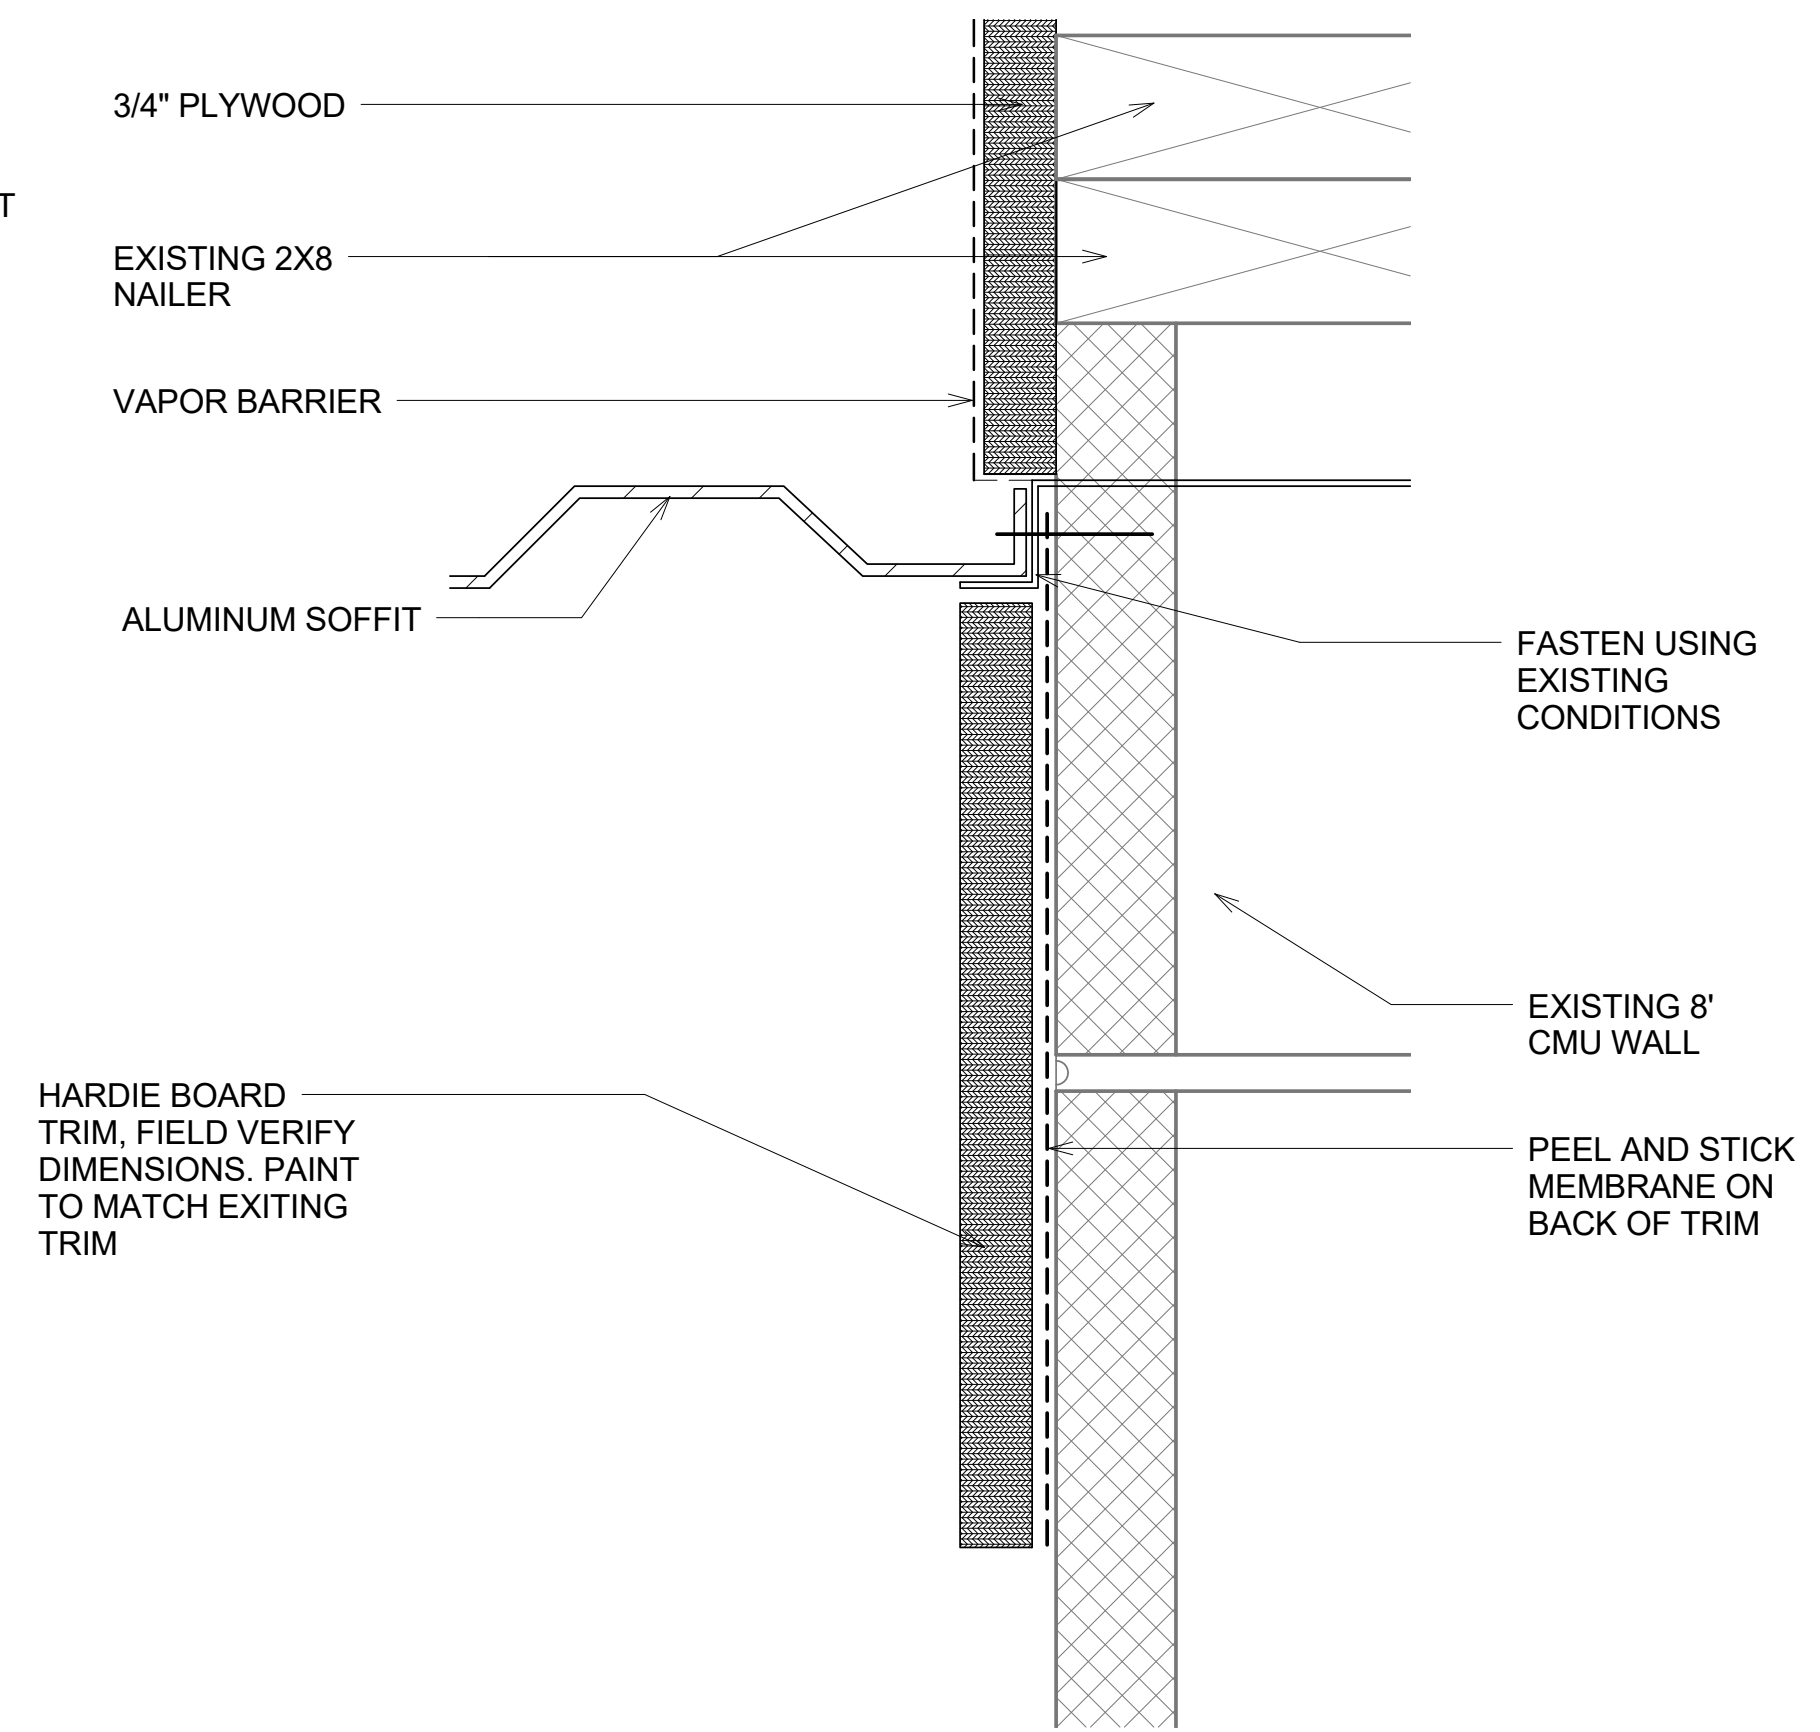


D5
TYP. SOFFIT AND TRIM
CONNECTION DETAIL
6" = 1'-0"

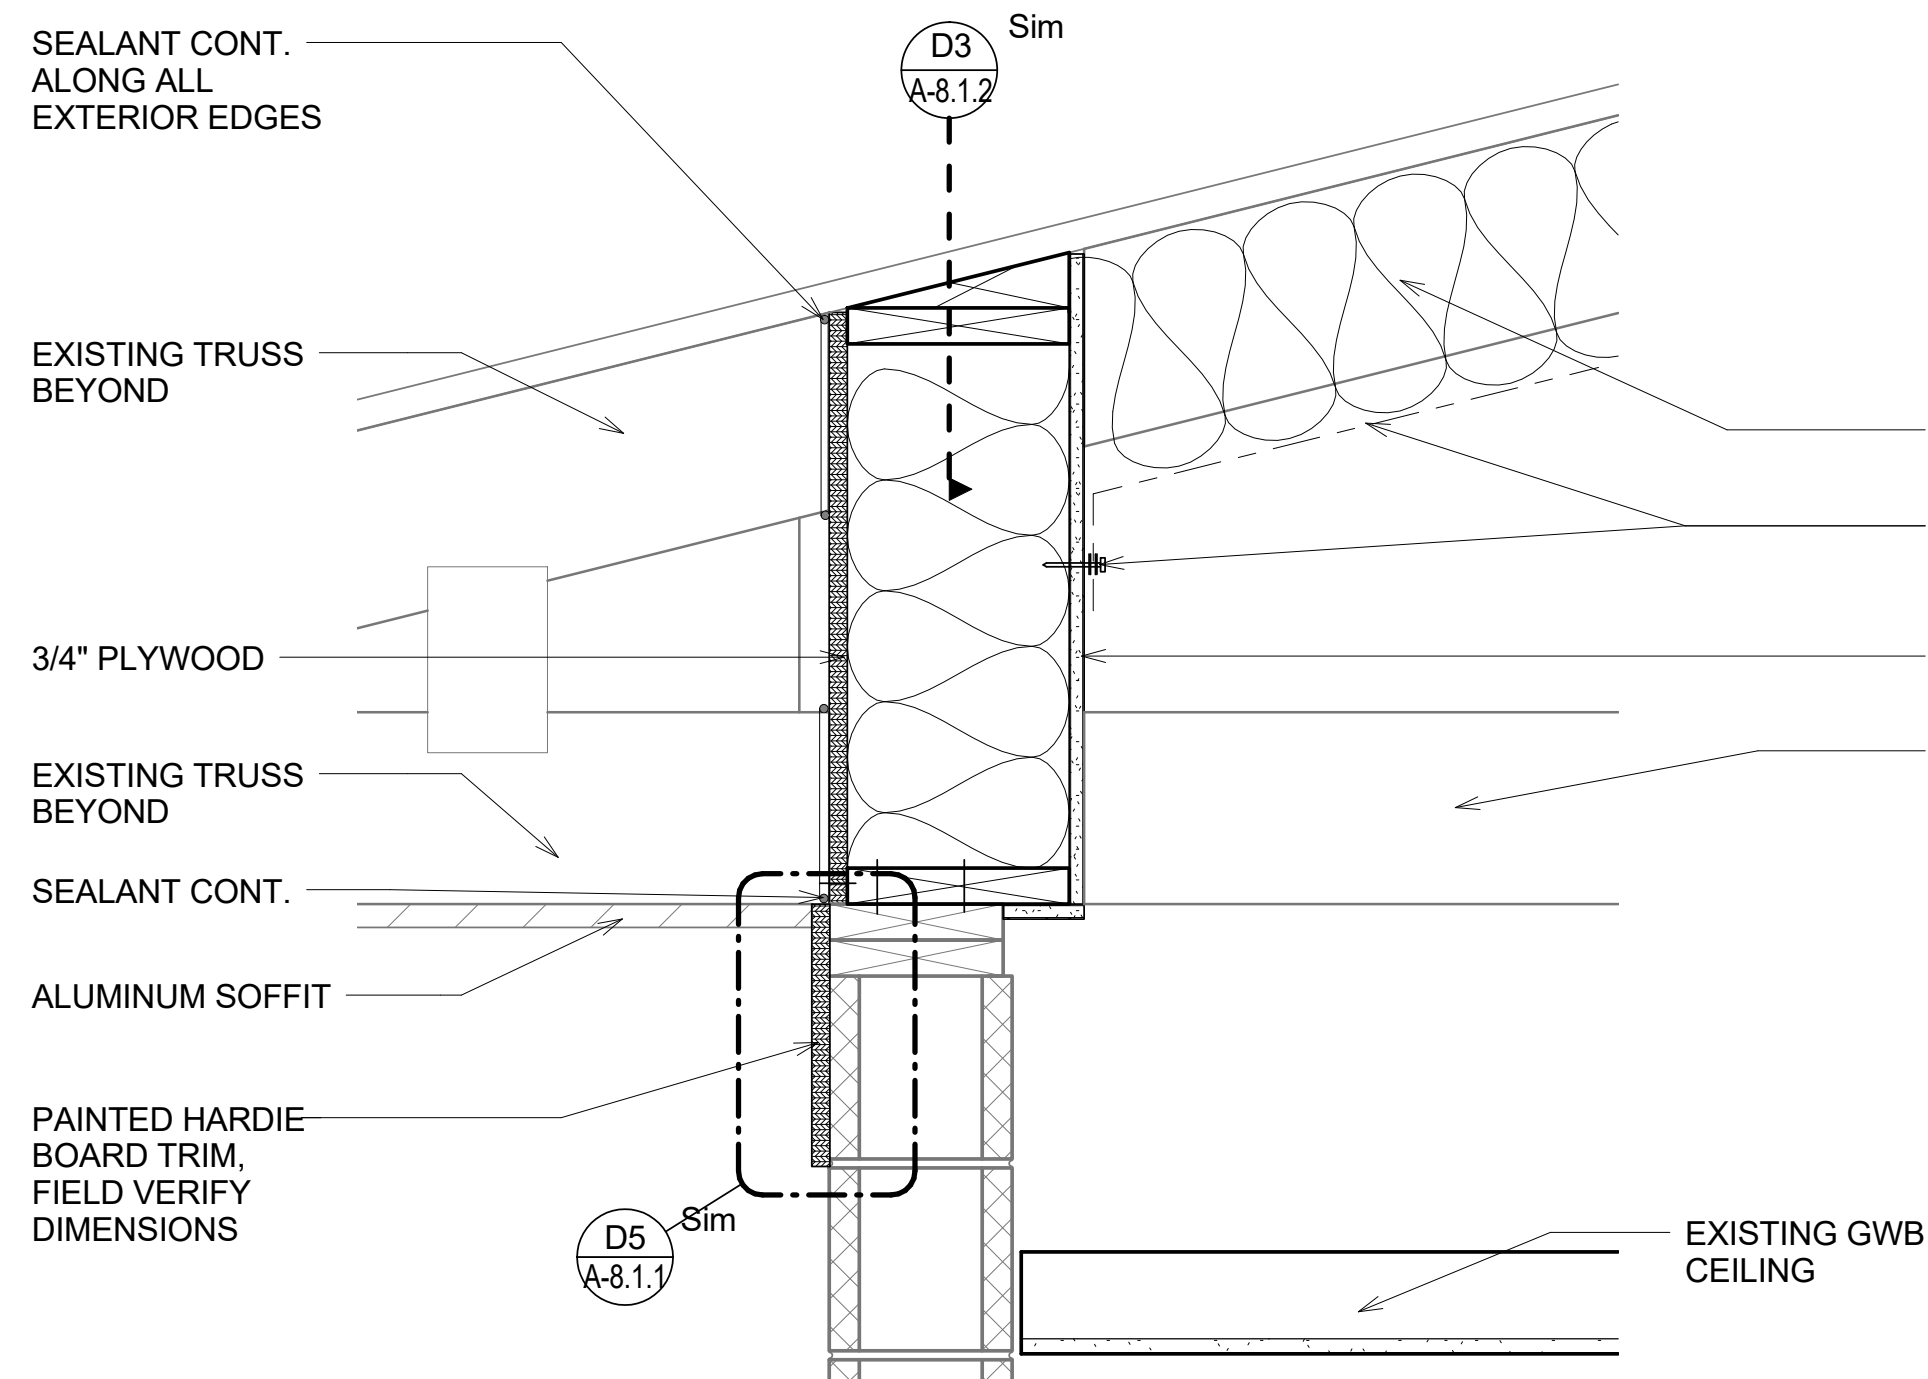


B1
TYP. INSULATION DETAIL
PERPENDICULAR TO TRUSS
1 1/2" = 1'-0"

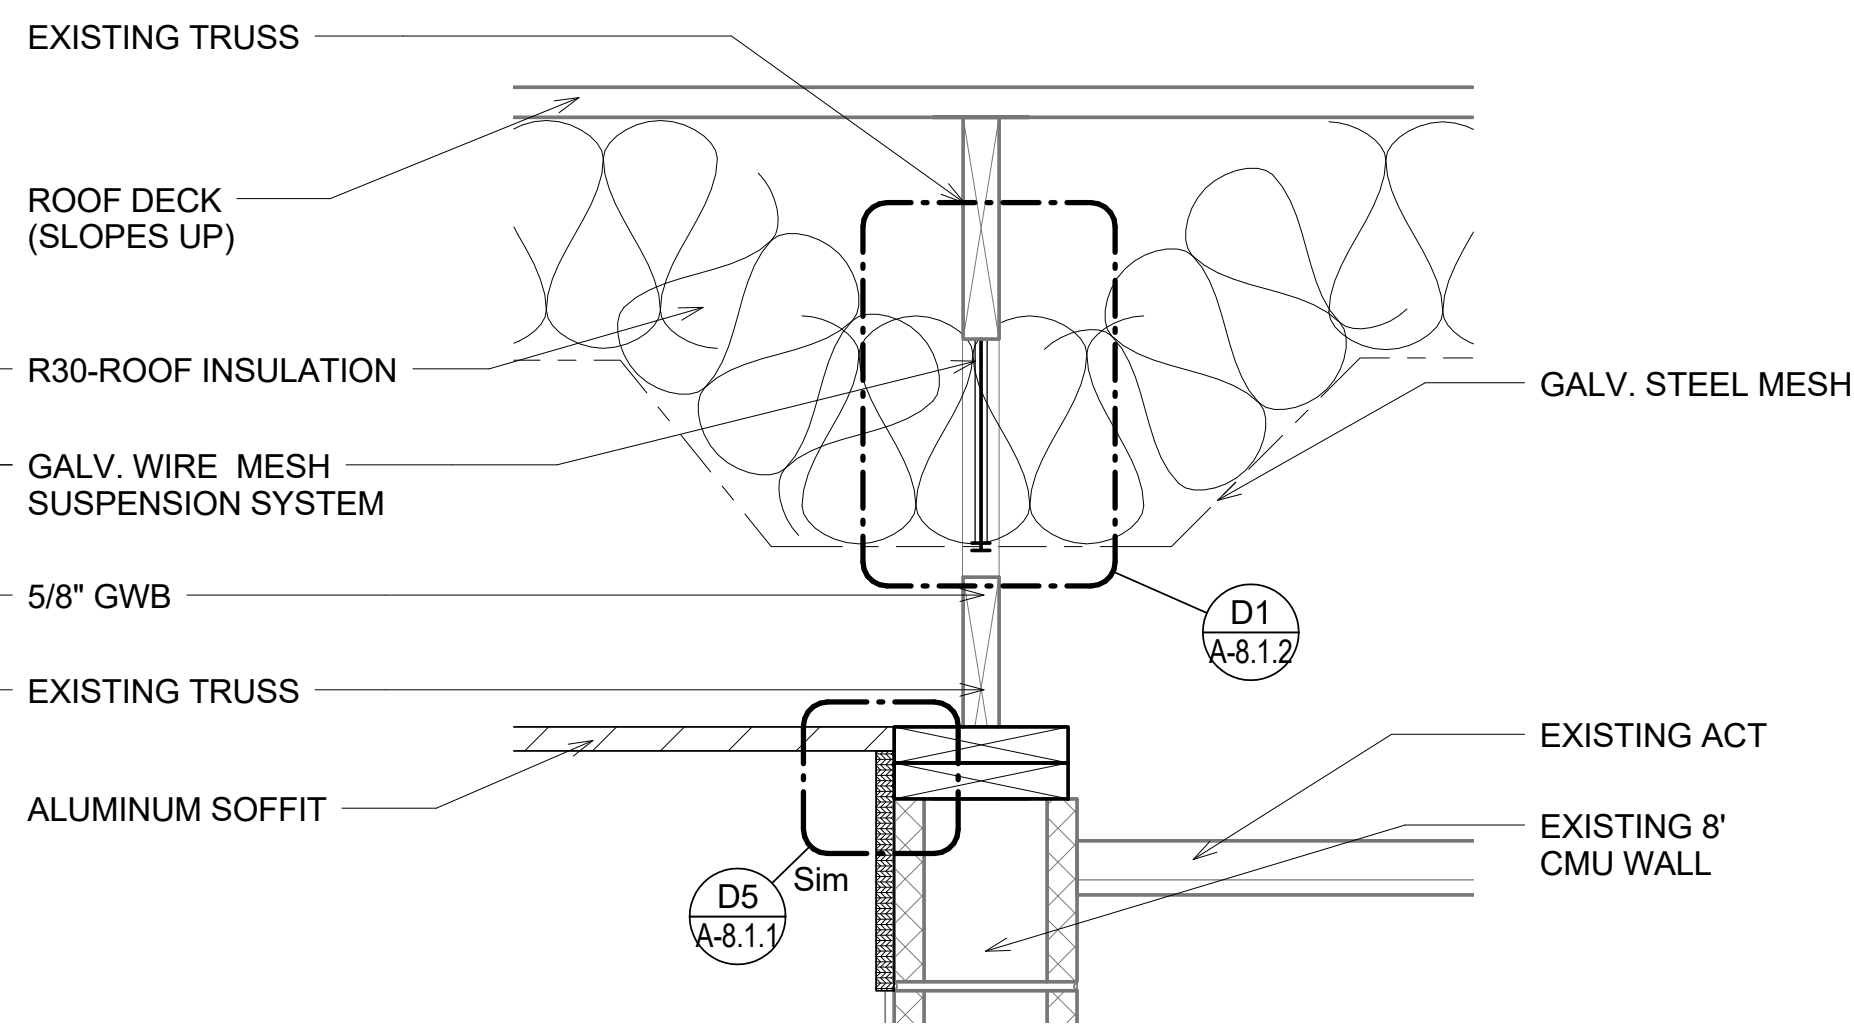


B3
TYP. GALV. WIRE MESH
SUSPENSION
1 1/2" = 1'-0"

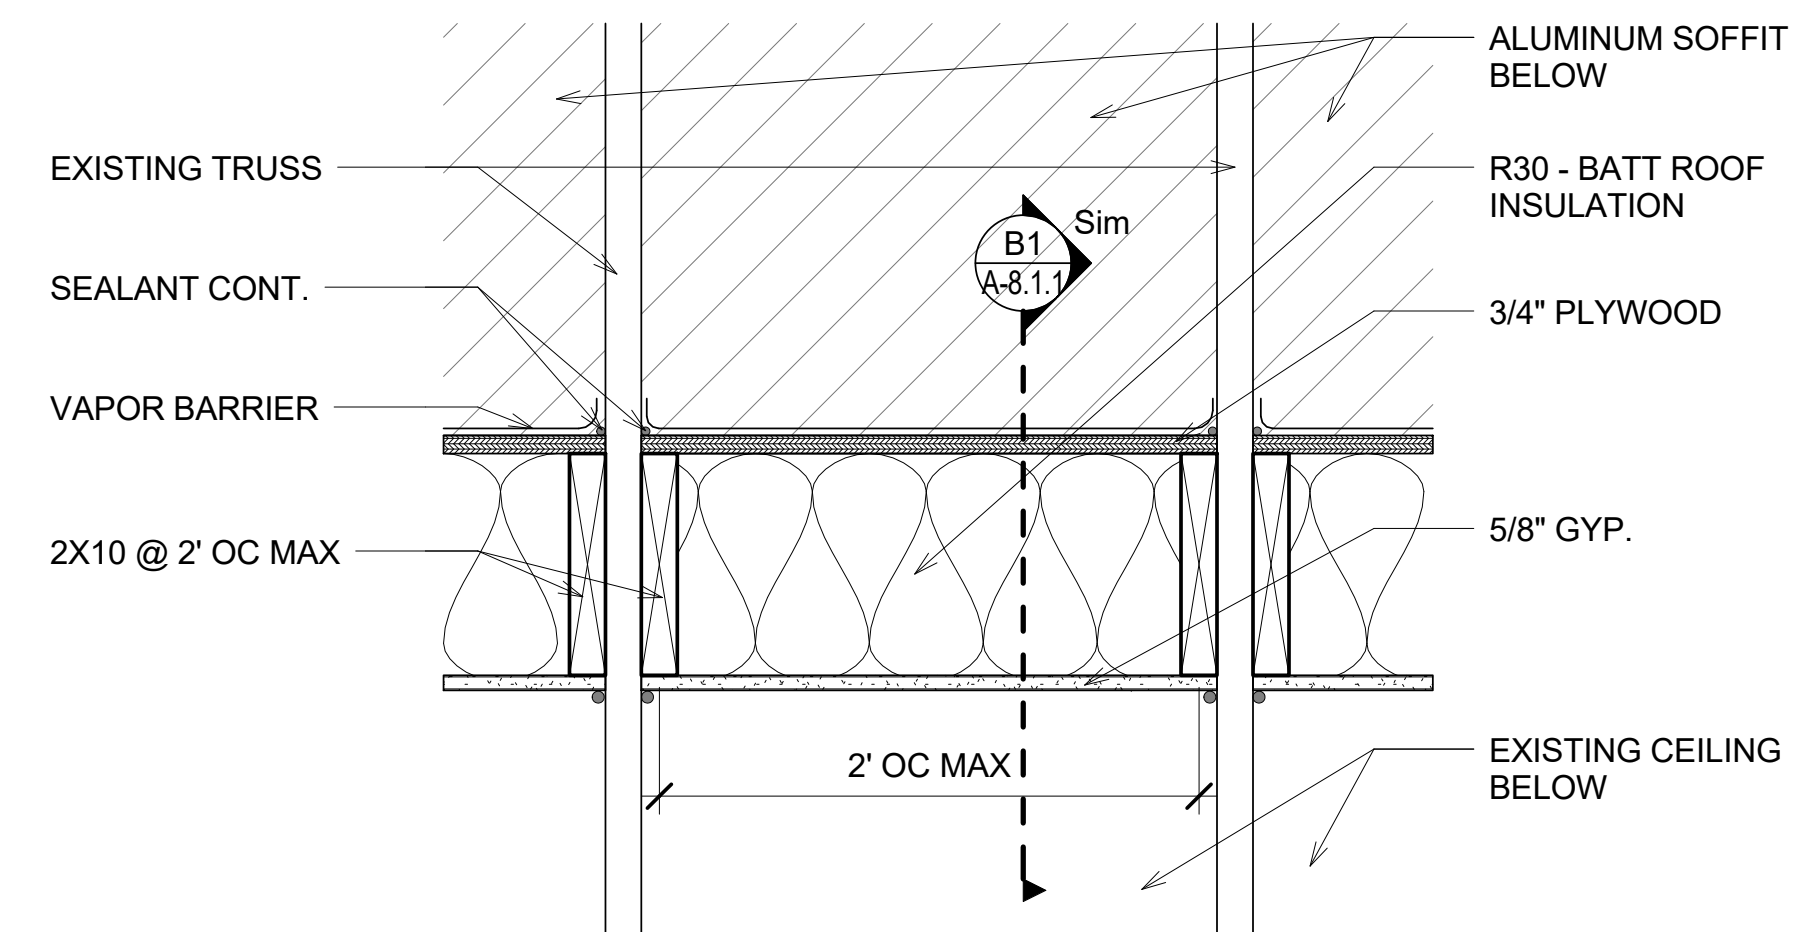

B5
TYP. PERPENDICULAR TRUSS
INTERSECTION PLAN
1 1/2" = 1'-0"

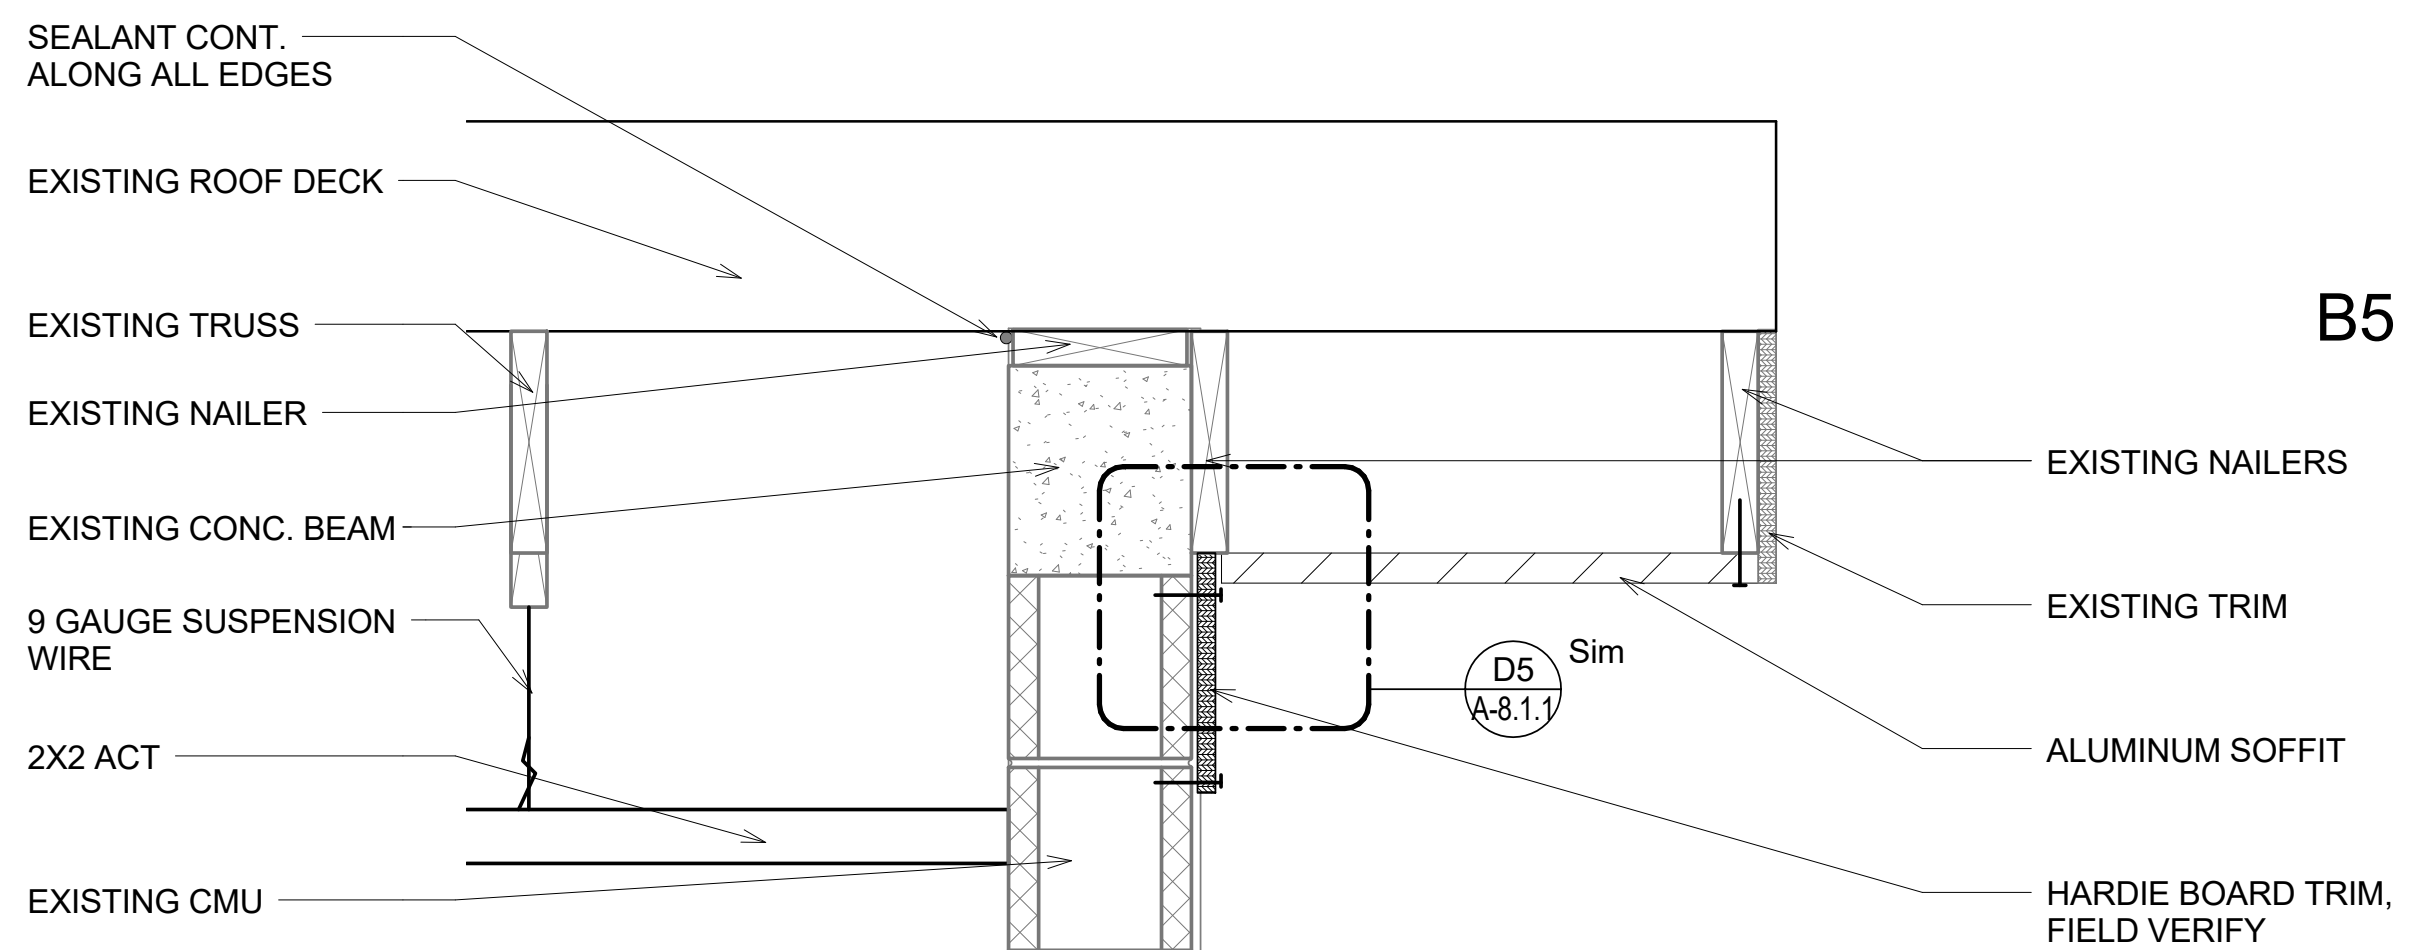

A3
SOFFIT DETAIL CMU WALL
1 1/2" = 1'-0"

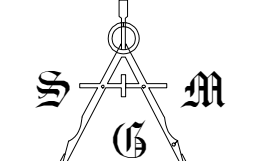
SGM ENGINEERING, INC.
 MEP CONSULTING ENGINEERS
 CA-0006208
 935 Lake Baldwin Lane
 Orlando, FL 32814
 Phone: 407-767-5188
 Fax: 407-767-5772
 www.sgmengineering.com
 Copyright © 2018 SGM Engineering, Inc.
 SGM Project Number 2018-233


MLM-MARTIN
 ARCHITECTS, INC.
 668 N. Orlando Avenue
 Suite 107
 Macland, FL 32751
 407.897.6764 ph
 407.894.1338 fax

Client Name:
ORANGE COUNTY
 FIRE STATION #30
 20 SOUTH HASTINGS ST.
 ORLANDO, FL 32835



Issue: PERMIT DOCUMENTS 02-07-19


NO.	DESCRIPTION	DATE

Project Name:
ORANGE COUNTY
 FIRE STATION #30
 HVAC REPLACEMENT


Scale:	AS NOTED	Seal:	
Design By:	MLM		
Drawn By:	ST		
Checked By:	MAM-AA		
Architect of Record:	MIGUEL LAZARO MARTIN		
License Number:	AR 8255		

Sheet Name:
DETAILS


Sheet Number:
A-8.1.1

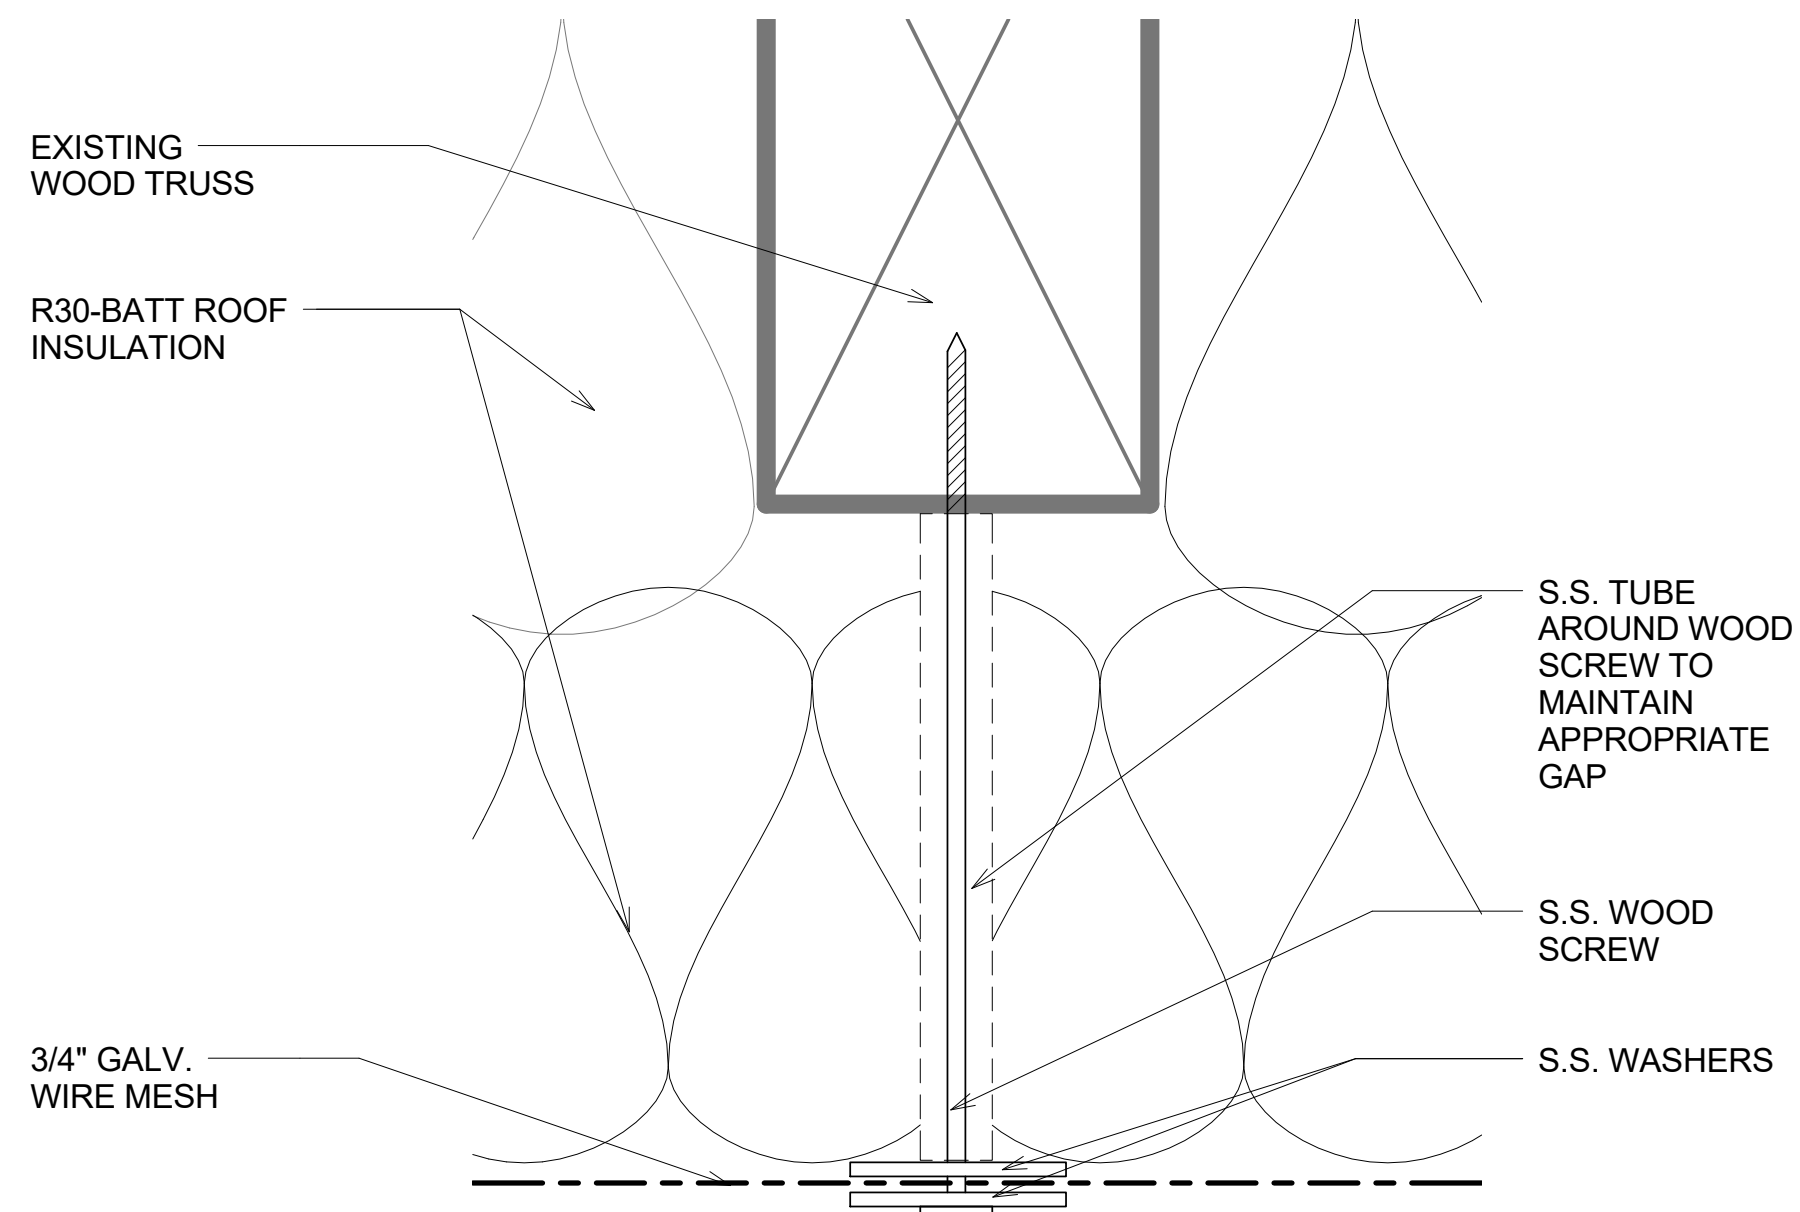

D1
TYP. GALV. WIRE MESH
SUSPENSION DETAIL
6" = 1'-0"

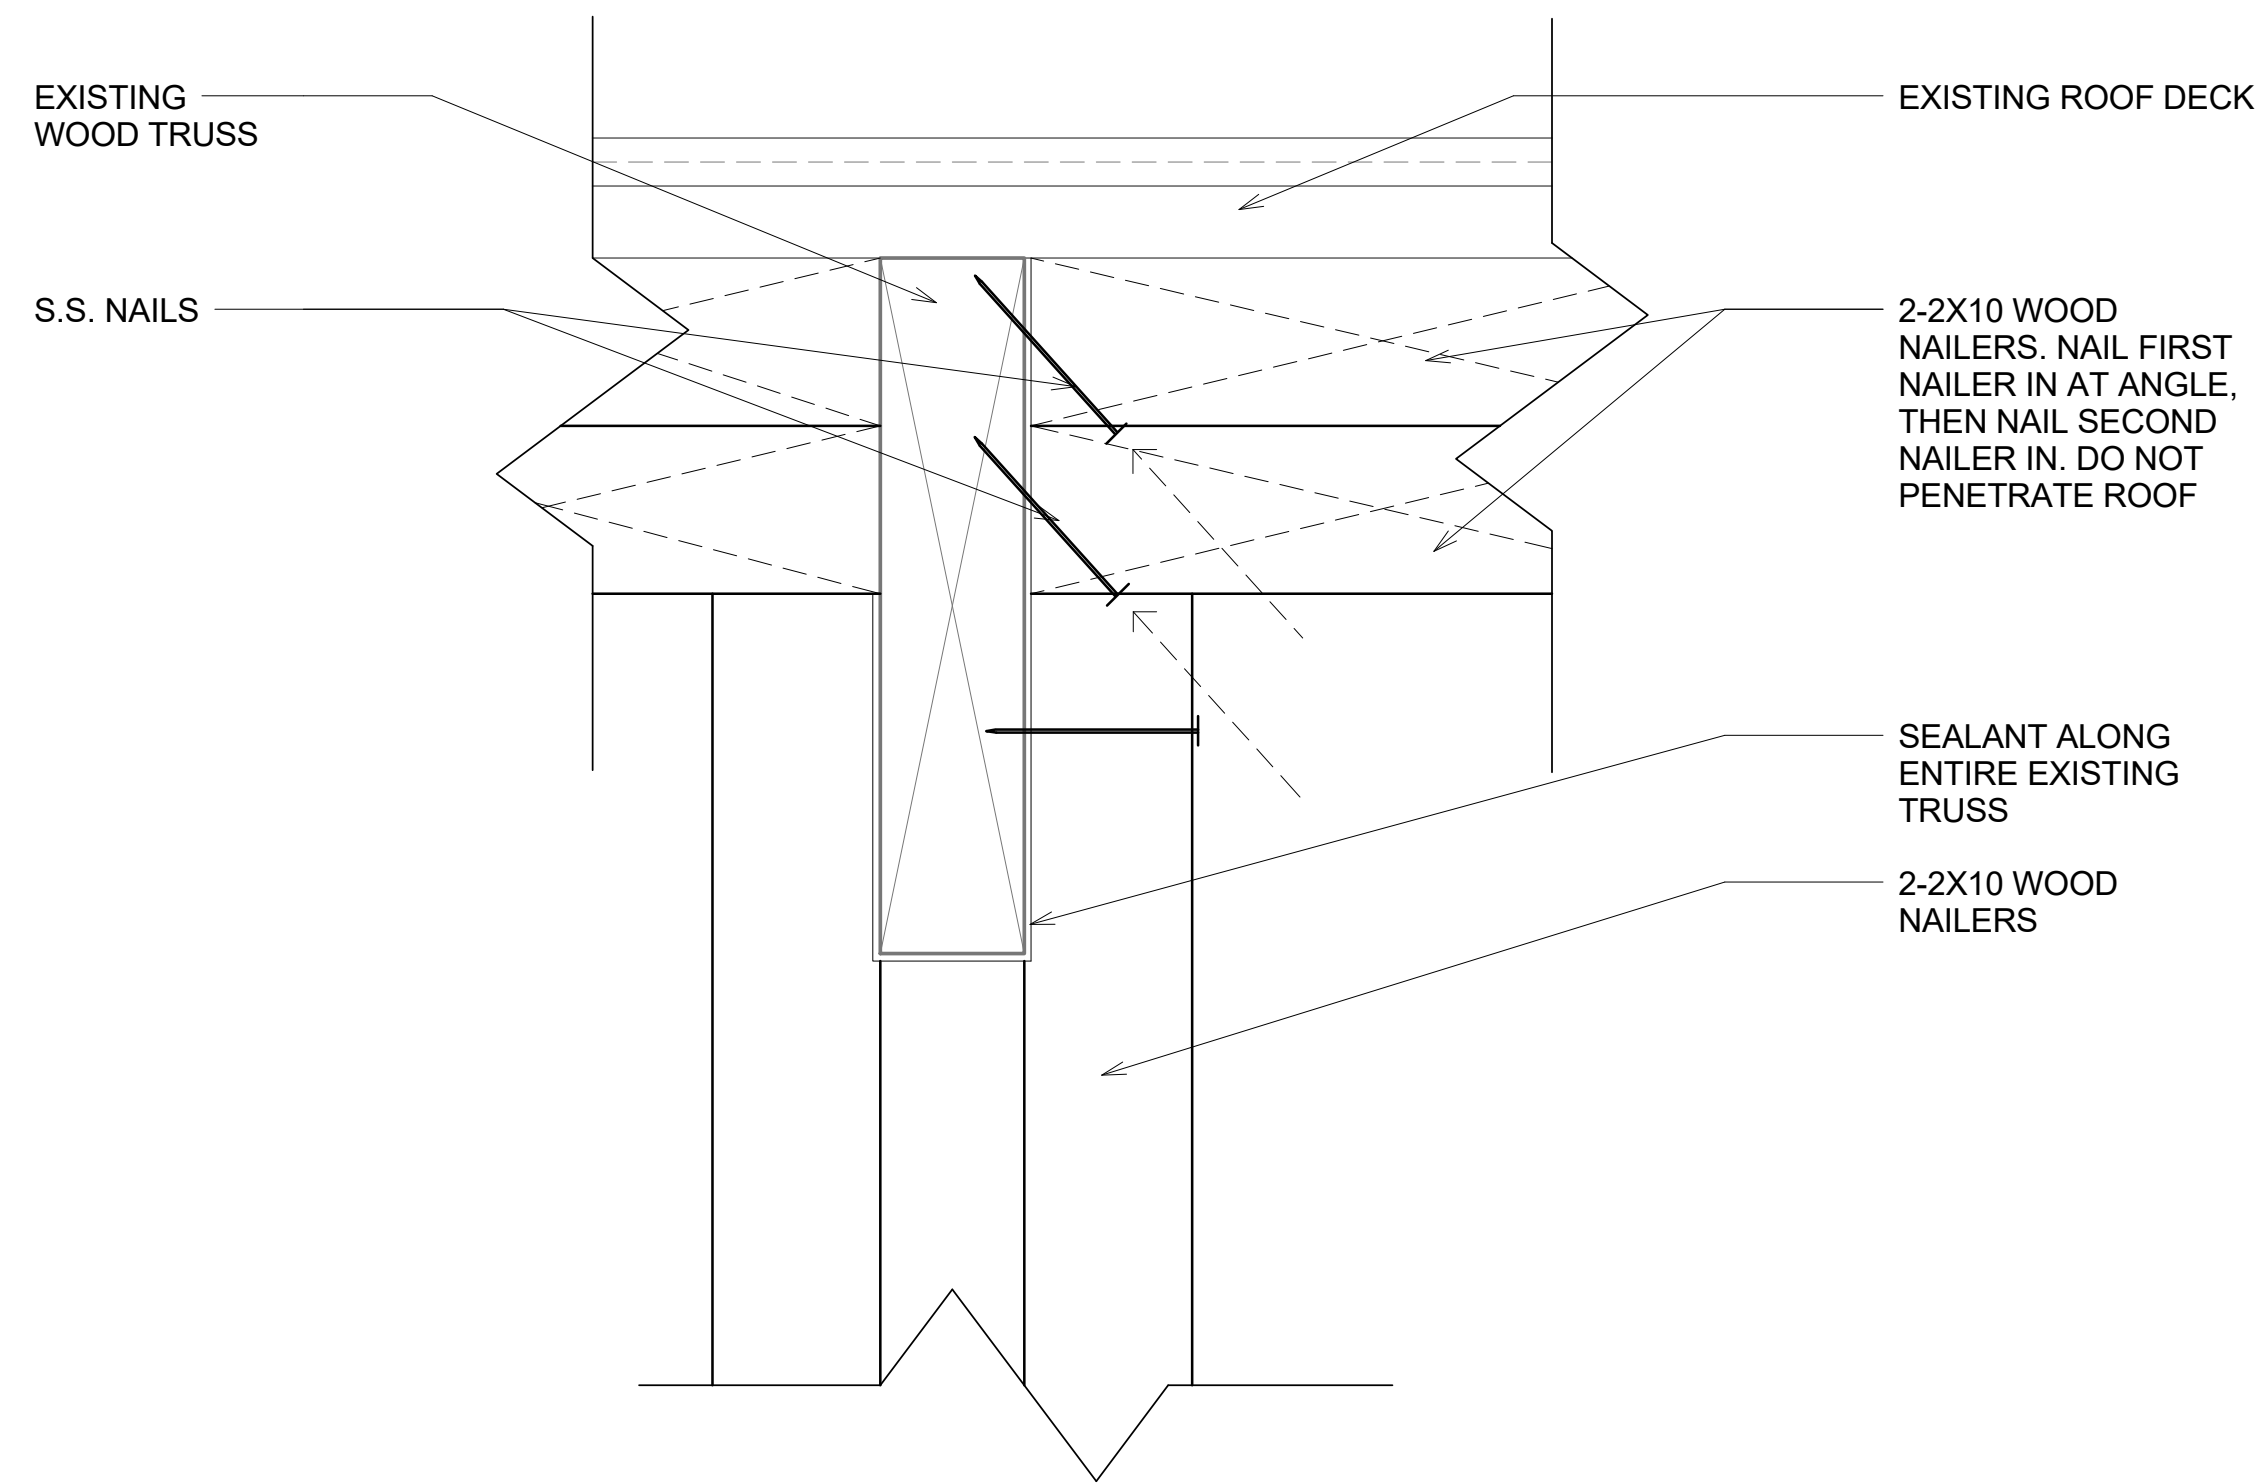

D3
NAILING DETAIL AT ROOF NAILERS
PERPENDICULAR TO TRUSS
6" = 1'-0"

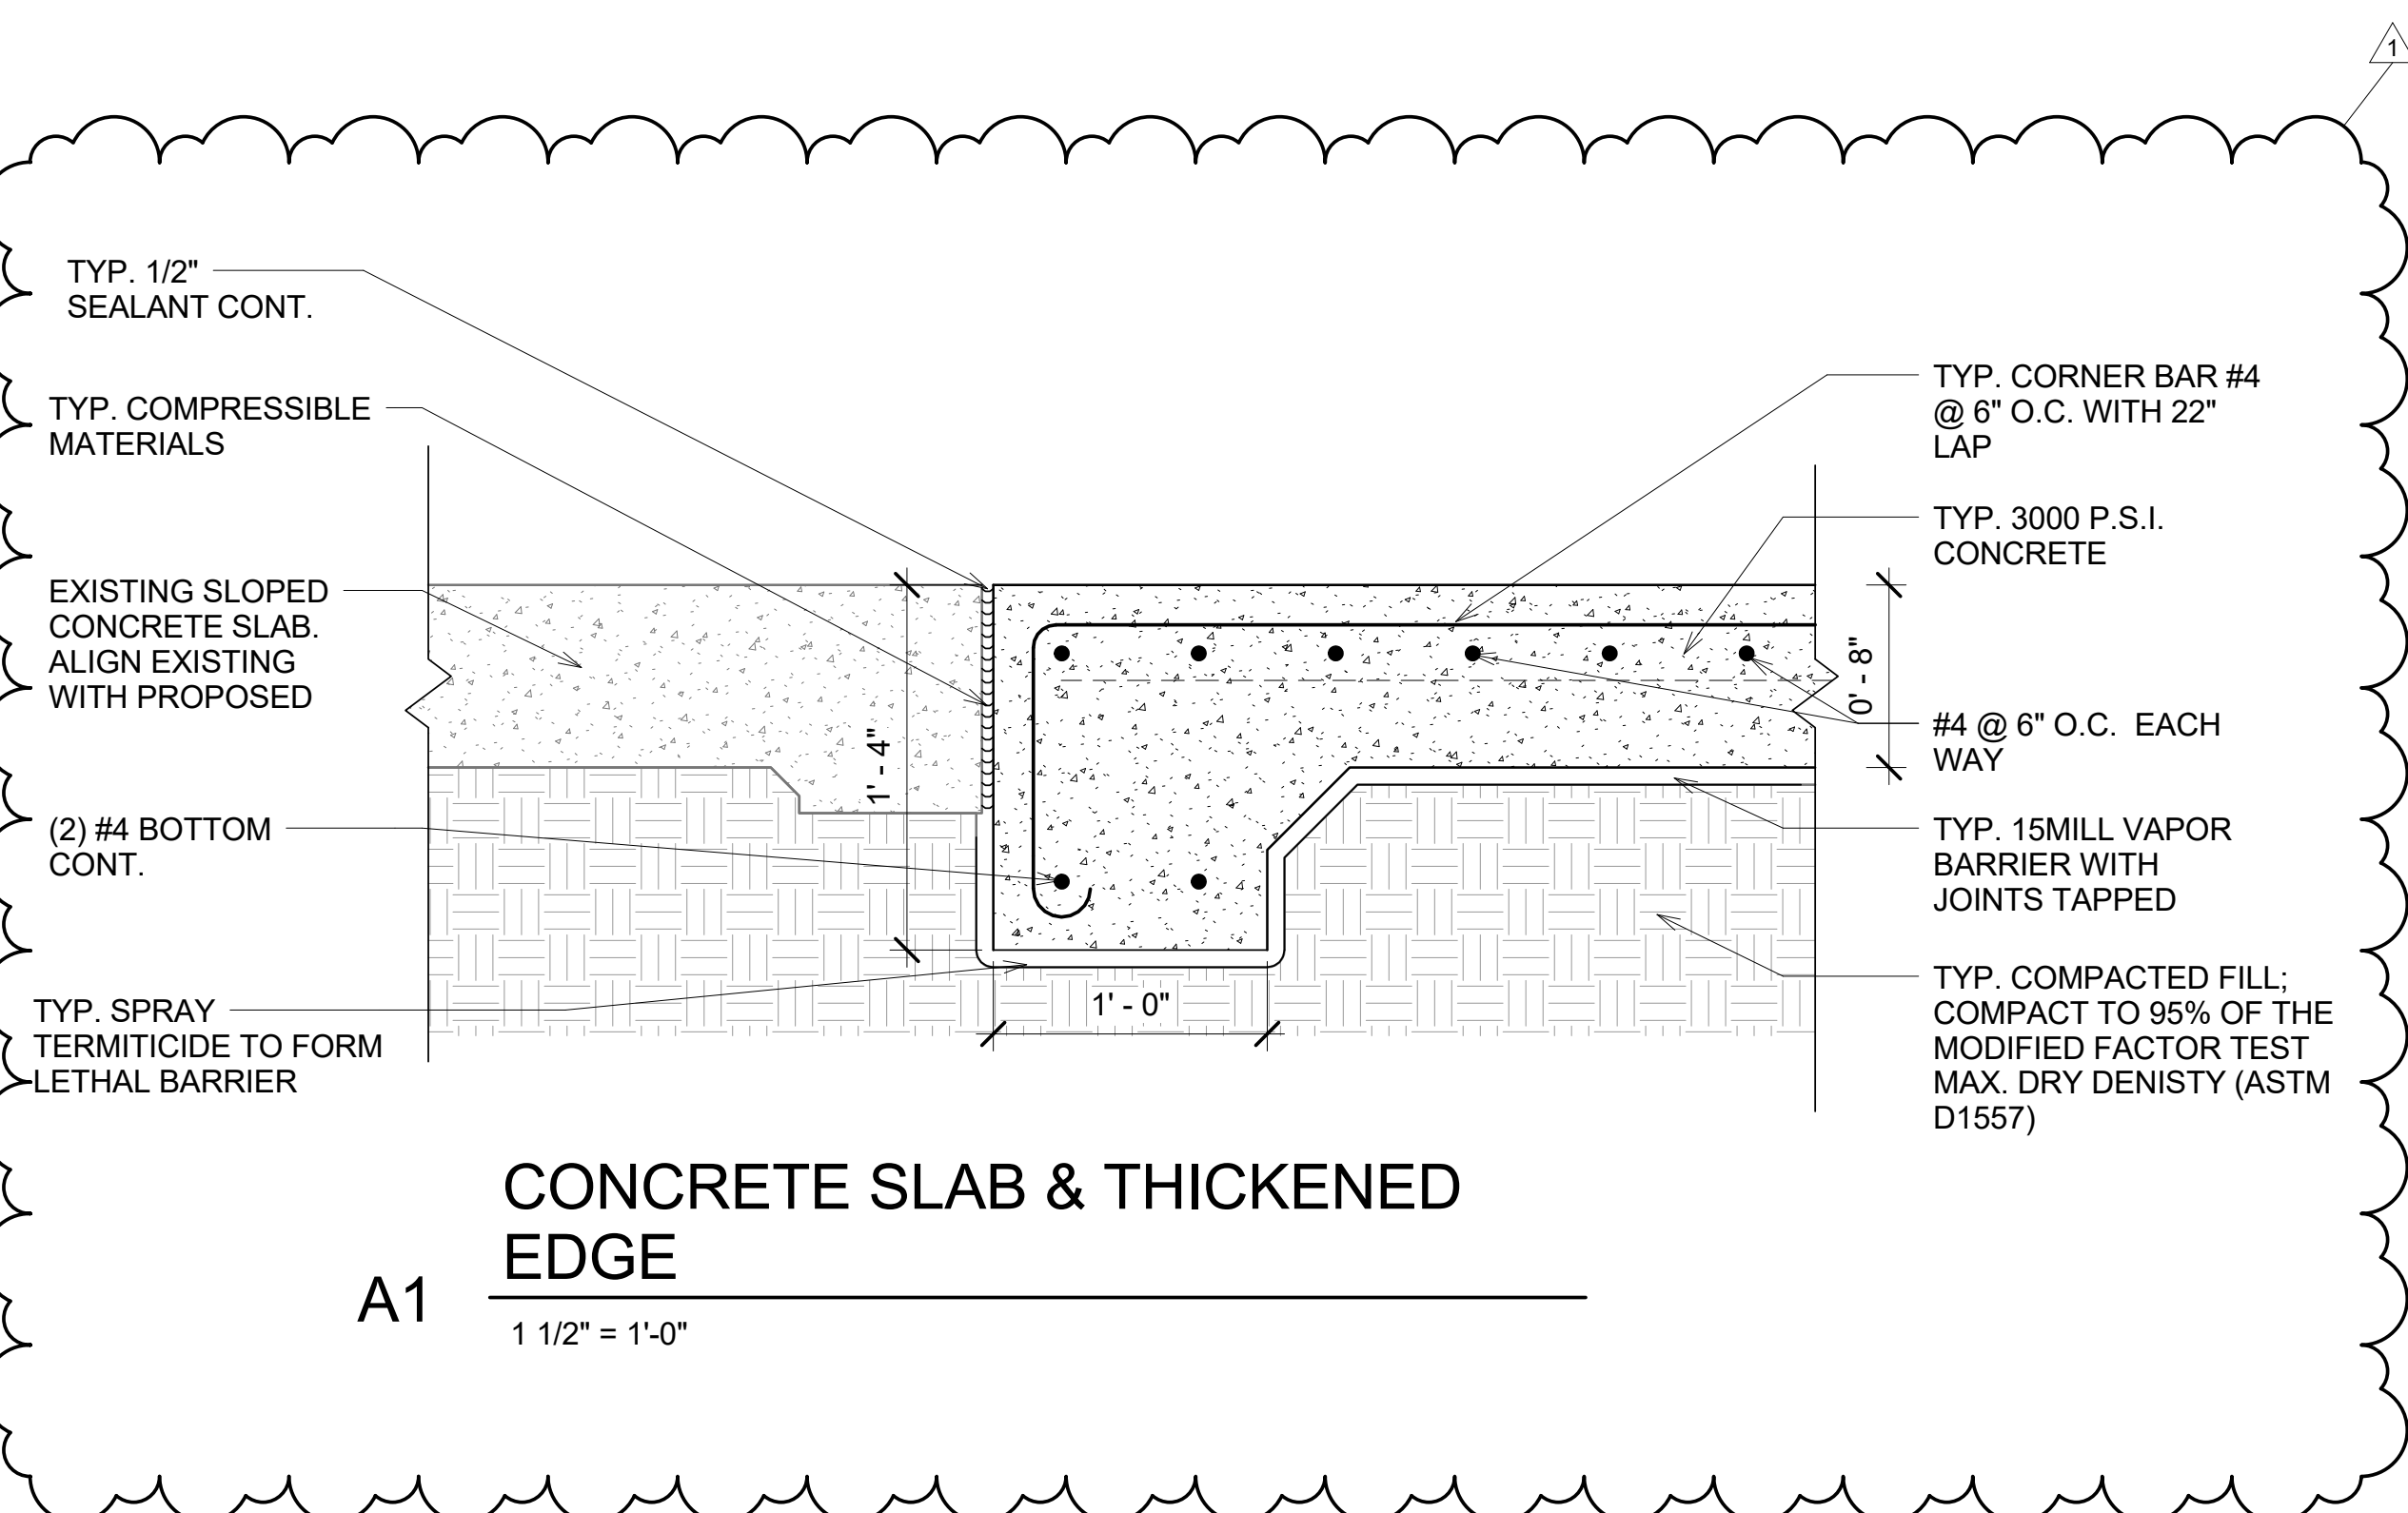

A1
CONCRETE SLAB & THICKENED
EDGE
1 1/2" = 1'-0"

SGM ENGINEERING, INC.
MEP CONSULTING ENGINEERS
CA-0006208
935 Lake Baldwin Lane
Orlando, FL 32814
Phone: 407-767-5188
Fax: 407-767-5772
www.sgmengineering.com
Copyright © 2018 SGM Engineering, Inc.
SGM Project Number 2018-233

MLM-MARTIN ARCHITECTS, INC.
668 N. Orlando Avenue
Suite 107
Maitland, FL 32751
407.897.6764 ph.
407.894.1338 fax

Client Name:
ORANGE COUNTY
FIRE STATION #30
20 SOUTH HASTINGS ST.
ORLANDO, FL 32835



Issue: PERMIT DOCUMENTS 02-07-19


NO.	DESCRIPTION	DATE
1	PRE-BID RFI	05/15/2019

Project Name:
**ORANGE COUNTY
FIRE STATION #30
HVAC REPLACEMENT**

Scale:	AS NOTED	Seal:	
Design By:	MLM		
Drawn By:	ST		
Checked By:	MAM-AA		
Architect of Record:	MIGUEL LAZARO MARTIN		
License Number:	AR 8255		

Sheet Name:
DETAILS

Sheet Number:
A-8.1.2

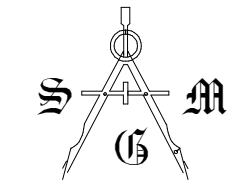


SGM ENGINEERING, INC.

MEP CONSULTING ENGINEERS
CA-0006208
935 Lake Baldwin Lane
Orlando, FL 32814
Phone: 407-767-5188
Fax: 407-767-5772
www.sgmengineering.com
Copyright © 2018 SGM Engineering, Inc.
SGM Project Number 2018-233

GENERAL NOTES:

- a. REFER TO SYMBOL LEGEND ON SHEET E.001.
- b. REFER TO BOOK SPECIFICATIONS.
- c. REFER TO ARCHITECTURAL INTERIOR ELEVATIONS TO COORDINATE EXACT PLACEMENT OF ALL DEVICES, EQUIPMENT, FIXTURES, SWITCHES AND OUTLETS.
- d. REFER TO EQUIPMENT FEEDER SCHEDULES FOR DISCONNECT, CONDUIT AND WIRE SIZES.
- e. ALL FEEDERS ARE TO HAVE LESS THAN 2% TOTAL VOLTAGE DROP AND ALL BRANCH CIRCUITS SHALL HAVE LESS THAN 3% VOLTAGE DROP.
- f. IF CIRCUITS ARE COMBINED AND RUN AS MULTI-WIRE BRANCH CIRCUITS SHARING A COMMON NEUTRAL, THEN EACH UNGROUNDED CONDUCTOR MUST BE DISCONNECTED SIMULTANEOUSLY BY A COMMON TRIP CIRCUIT BREAKER. CONTRACTOR MAY, AT THEIR OPTION, PROVIDE EITHER COMMON TRIP MULTI-POLE CIRCUIT BREAKERS OR UTILIZE MANUFACTURERS LISTED HANDLE TIES IN ORDER TO PROVIDE THE SIMULTANEOUS TRIP. THESE DEVICES ARE NOT SHOWN IN THE PANEL SCHEDULES AND MUST BE PROVIDED BY THIS SCOPE OF WORK. NO MORE THAN 3 CURRENT CARRYING CONDUCTORS MAY BE COMBINED IN A SINGLE RACEWAY WITHOUT PRIOR APPROVAL BY THE ENGINEER OF RECORD (EOR).
- g. IF CIRCUITS ARE COMBINED AND RUN AS MULTI-WIRE BRANCH CIRCUITS SHARING A COMMON NEUTRAL, THEN EACH UNGROUNDED CONDUCTOR MUST BE DISCONNECTED SIMULTANEOUSLY BY A COMMON TRIP CIRCUIT BREAKER. CONTRACTOR MAY, AT THEIR OPTION, PROVIDE EITHER COMMON TRIP MULTI-POLE CIRCUIT BREAKERS OR UTILIZE MANUFACTURERS LISTED HANDLE TIES IN ORDER TO PROVIDE THE SIMULTANEOUS TRIP. THESE DEVICES ARE NOT SHOWN IN THE PANEL SCHEDULES AND MUST BE PROVIDED BY THIS SCOPE OF WORK. NO MORE THAN 3 CURRENT CARRYING CONDUCTORS MAY BE COMBINED IN A SINGLE RACEWAY WITHOUT PRIOR APPROVAL BY THE ENGINEER OF RECORD (EOR).

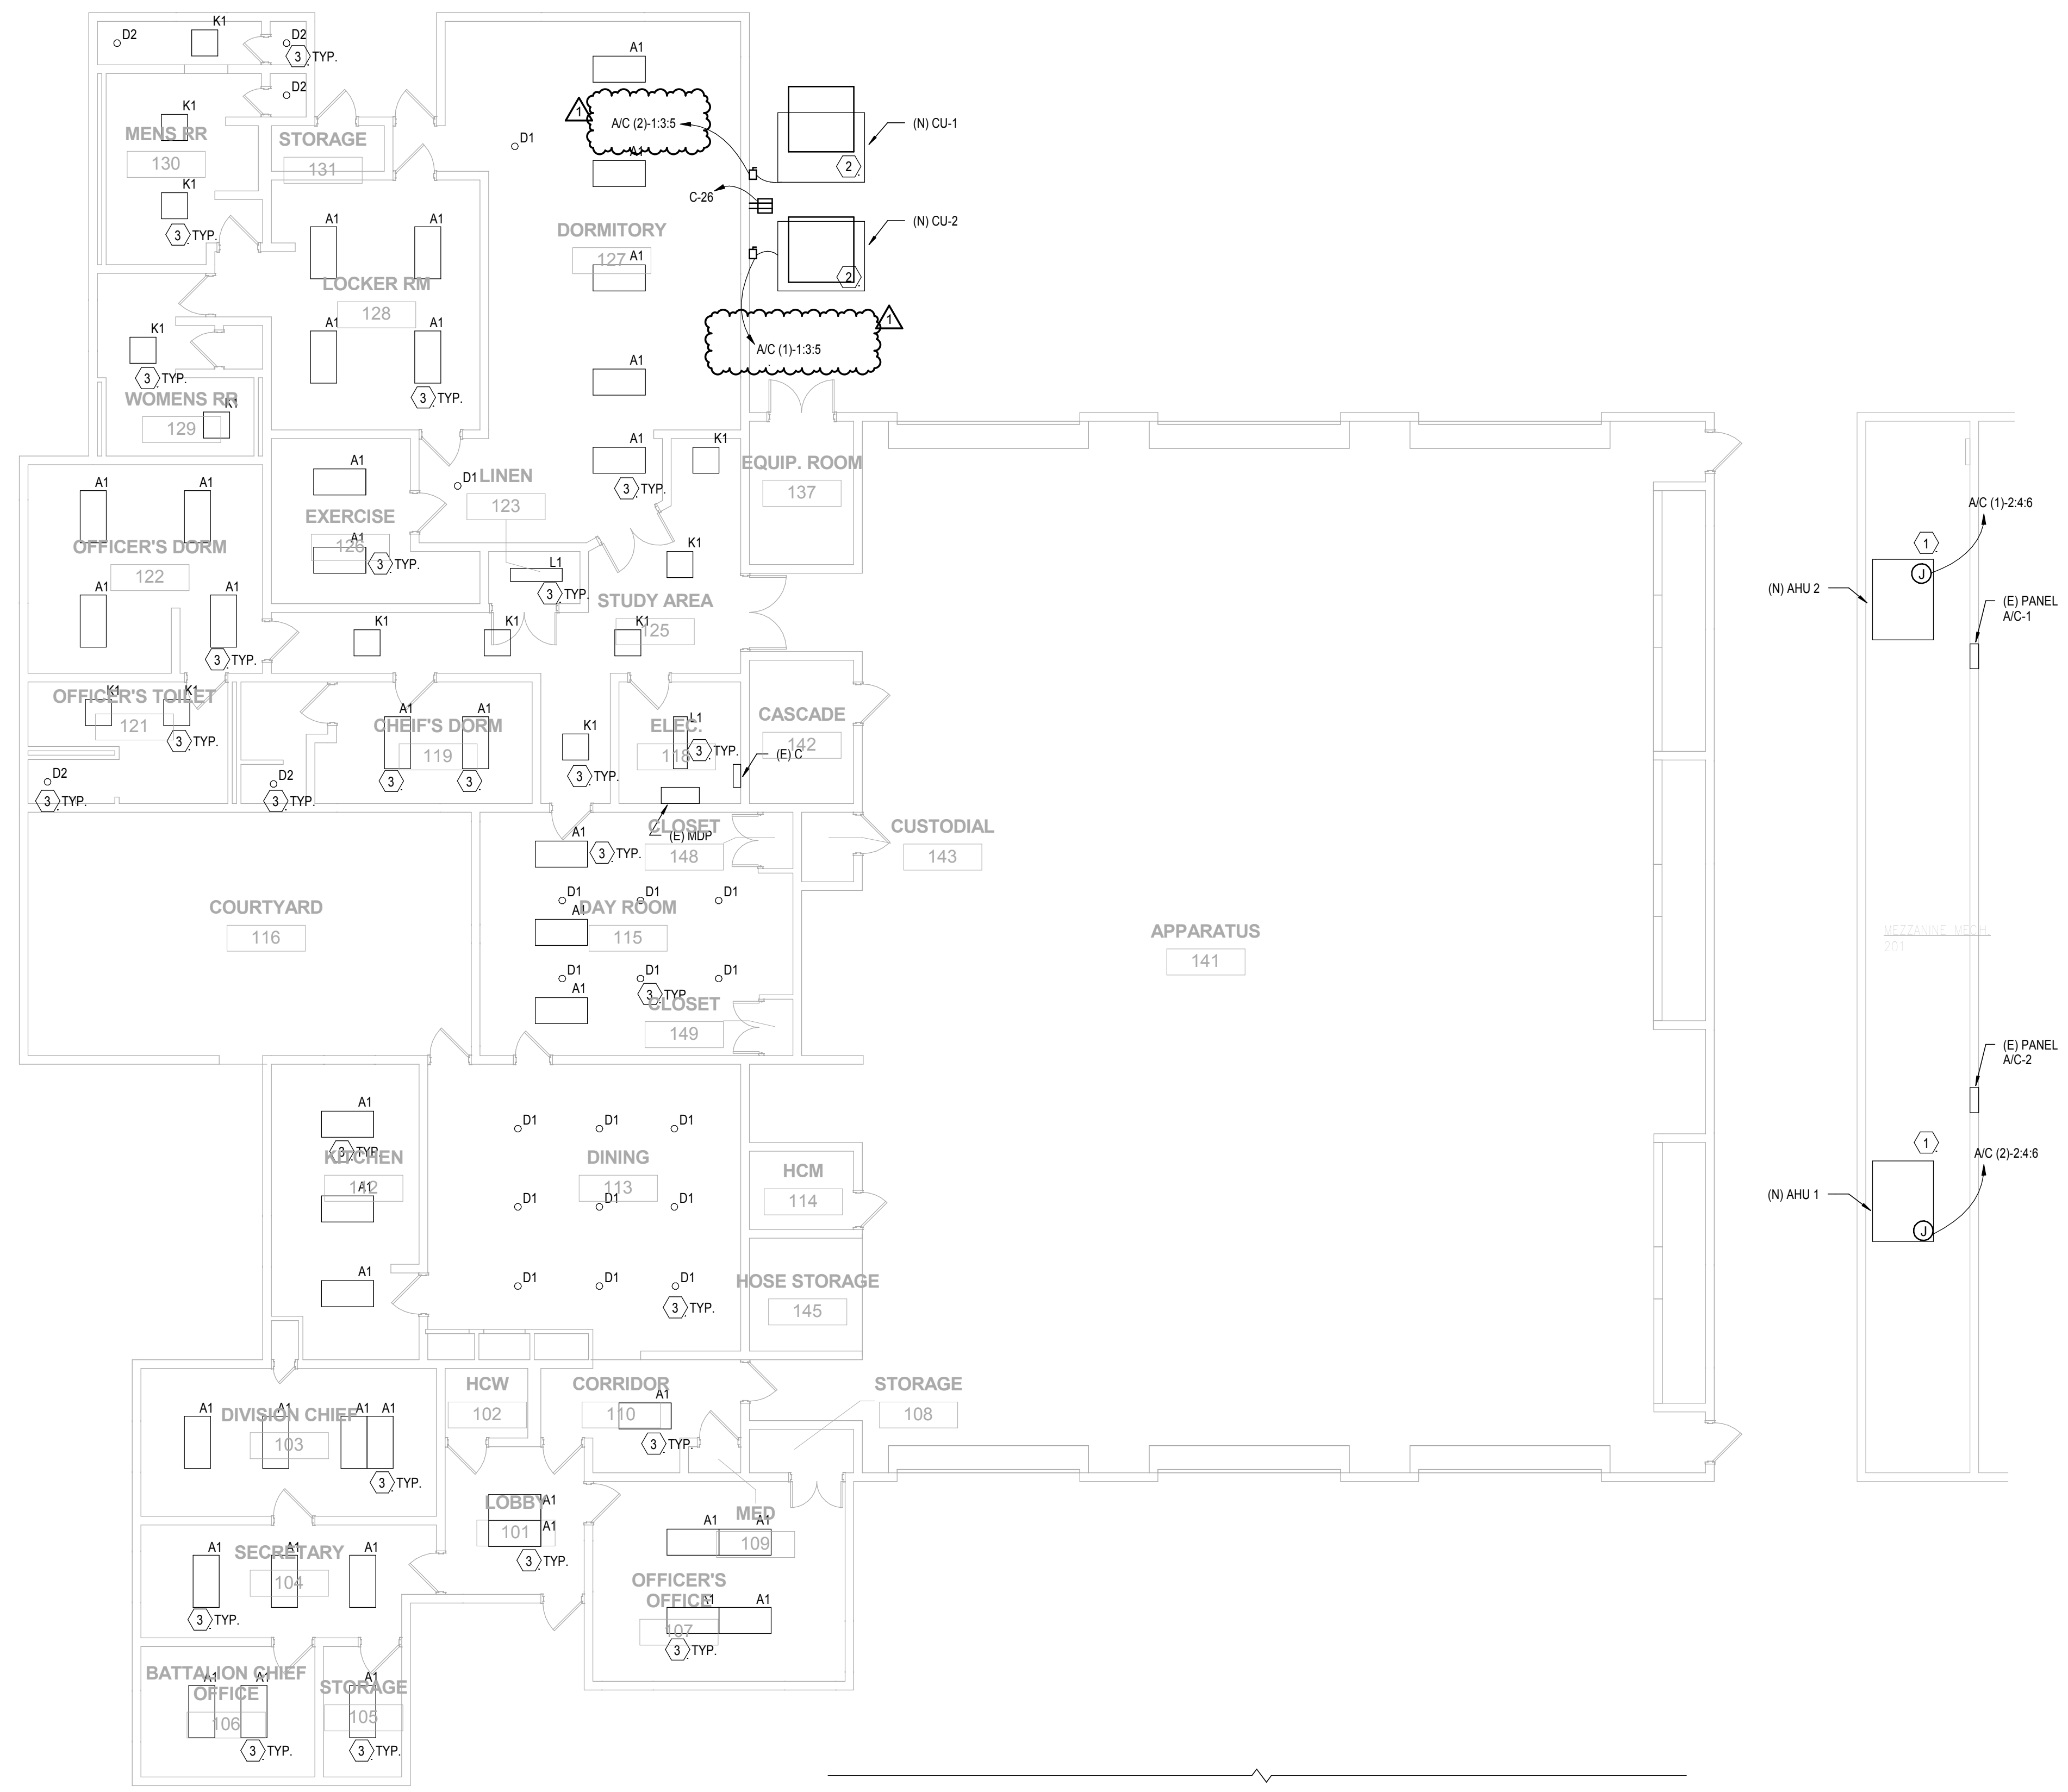

PLAN KEY NOTES:

- 1. NEW AIR HANDLER WITH BUILT IN HEAT TO REPLACE EXISTING.
- 2. FOR CONDENSING UNITS, REUSE ALL DISCONNECTS AND WIRING IF IN ACCEPTABLE SHAPE AND CORRECT REQUIREMENTS BASED ON EQUIPMENT FEEDER SCHEDULE.
- 3. NEW LIGHTING TO REPLACE EXISTING. USE EXISTING FEEDERS AND BREAKERS FED FROM SAME PANEL. REFER TO LIGHTING FIXTURE SCHEDULE SHEET E-602 FOR MORE INFORMATION ON LIGHTING TYPES.

Client Name:

**ORANGE COUNTY
FIRE STATION #30**
20 SOUTH HASTINGS ST.
ORLANDO, FL 32835



Issue: 100% PERMIT DOCUMENTS 02-07-19

NO.	DESCRIPTION	DATE
1	PRE-BID RFI	05/15/19

Project Name:

**ORANGE COUNTY
FIRE STATION #30
HVAC REPLACEMENT**


Scale: As indicated	Seal:
Design By: ME	
Drawn By: ME	
Checked By: JM	
Engineer of Record:	
License Number:	

Sheet Name:

ELECTRICAL FLOOR PLAN

Sheet Number:

E-101

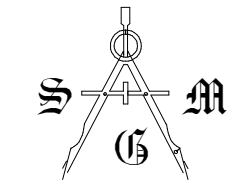

SGM ENGINEERING, INC.
 MEP CONSULTING ENGINEERS
 CA-0006208
 935 Lake Baldwin Lane
 Orlando, FL 32814
 Phone: 407-767-5188
 Fax: 407-767-5772
 www.sgmengineering.com
 Copyright © 2018 SGM Engineering, Inc.
 SGM Project Number 2018-233

Client Name:

ORANGE COUNTY
 FIRE STATION #30
 20 SOUTH HASTINGS ST.
 ORLANDO, FL 32835



Issue: 100% PERMIT DOCUMENTS 02-07-19

NO.	DESCRIPTION	DATE
1	PRE-BID RFI	05/15/19

Project Name:

ORANGE COUNTY
FIRE STATION #30
HVAC REPLACEMENT

Scale:	As indicated	Seal:	
Design By:	GJ		
Drawn By:	GJ		
Checked By:	JS		
Engineer of Record:			
License Number:			

Sheet Name:

MECHANICAL FLOOR PLAN

Sheet Number:


M-101

GENERAL NOTES:


- REFER TO SHEET M0.01 FOR GENERAL NOTES.
- ROUTE NEW AHU CONDENSATE DRAINS FULL SIZE OF NEW UNIT TO EXISTING CONDENSATE DRAINS WITHIN MECHANICAL ROOM.
- RECONNECT EXISTING DUCT SMOKE DETECTOR SMOKE CONTROLS TO NEW AHUS (TYP)
- CONTRACTOR SHALL PROVIDE TEMPORARY COOLING IN ALL AREAS WHERE THE COOLING SYSTEM WILL BE DOWN FOR REPLACEMENT. TEMPORARY COOLING SHALL CONSIST OF SPOT COOLERS FURNISHED BY CONTRACTOR. CONTRACTOR SHALL MAINTAIN AND DRAIN SPOT COOLERS AS REQUIRED DURING THE DAY AND BEFORE LEAVING FOR THE NIGHT. ALL PHASES SHALL BE PROVIDED WITH TEMP. COOLING WHILE OCCUPIED.
- SEE PHASING DRAWING FOR CONSTRUCTION PHASING. AHUS SHALL BE REPLACED IN A MANNER THAT FOLLOWS THE PHASING PLAN. AHU-1 SHALL BE REPLACED & DUCTWORK MODIFICATIONS ACCOMPLISHED DURING PHASES 1, 2 & 3 WITH PHASE 2 RESTROOMS AVAILABLE WITH TEMPORARY COOLING DURING AHU-1 REPLACEMENT. AHU-2 SHALL BE REPLACED & DUCTWORK MODIFICATIONS ACCOMPLISHED DURING PHASES 5 & 6, AFTER AHU-1 IS UP AND RUNNING.
- REBALANCE ALL HVAC SYSTEMS ONCE AHU REPLACEMENT AND HVAC MODIFICATIONS HAVE BEEN ACCOMPLISHED. NEW CONTROLS SHALL BE COMMISSIONED WITH OWNER REPRESENTATIVE PRESENT TO VERIFY EQUIPMENT OPERATIONS AND ALLOW FOR TRAINING OF CONTROLS AND FOR NEW HVAC SYSTEMS.

PLAN KEY NOTES: (xx)

- CLEAN ALL EXISTING SUPPLY AND RETURN ROUND BRANCH DUCTWORK AND RECONNECT TO EXISTING MAIN SUPPLY AND RETURN DUCTWORK.
- PROVIDE NEW MAIN SUPPLY AND RETURN DUCTWORK AND RECONNECT EXISTING SUPPLY AND RETURN SUB-MAINS AS INDICATED (COORD. WITH EXISTING CONDITIONS). PROVIDE NEW FIRE DAMPERS. PROVIDE NEW 2" EXTERNAL BATT INSULATION FOR ALL NEW DUCTWORK. SEAL ALL EXISTING DUCTS AT CONNECTIONS TO NEW.
- PROVIDE NEW 14" DIA. RETURN DUCT AND REGISTER AND CONNECT TO EXISTING RETURN AS INDICATED.
- PROVIDE NEW DUCTWORK AND DIFFUSERS/REGISTERS AS INDICATED; RECONNECT TO EXISTING RETURN
- PROVIDE NEW CONDENSING UNITS; PROVIDE CONCRETE PADS AND ANCHOR PER DETAILS
- PROVIDE NEW AHUS WITH DISCHARGE HEATER; PROVIDE NEW DUCTWORK AND CONDENSATE PIPING AS REQUIRED. INSTALL NEW REFRIG. PIPING. SIZE PER MANUFACTURER'S RECOMMENDATIONS. SEAL ALL WALL PENETRATIONS WATER TIGHT. PROVIDE NEW MOD 1 NOA DUCT, BALANCE PER SCHEDULES.
- REBALANCE EXHAUST FAN TO NEW AIRFLOW; ADJUST PULLEY SQUEEZE SYSTEM TO ALLOW FOR NEW AIRFLOW.
- TIE IN TO EXISTING CONDENSATE LINE BELOW GRADE AND PROVIDE NEW DRYWELL IN TURFED AREA. EXCAVATE BY HAND AS REQUIRED TO AVOID DAMAGE TO EXISTING UTILITIES.
- CAP EXHAUST DUCT AND BLANK OFF EXISTING GRILLE IN SOFFIT.
- RELOCATE EXISTING DIFFUSERS TO WITHIN NEW CEILING GRID

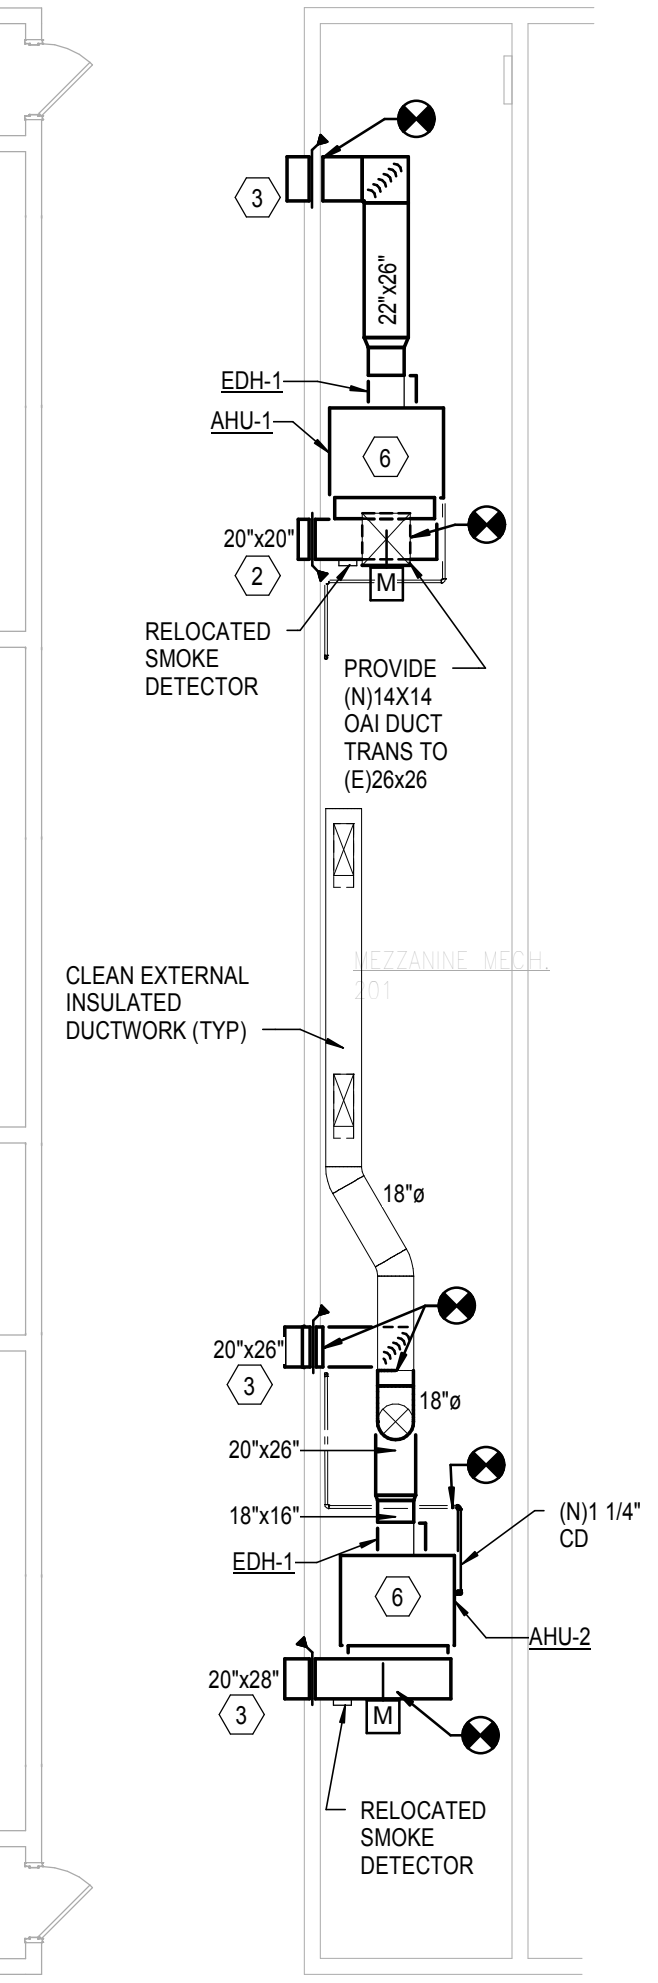


MEZZANINE PLAN
 1/8" = 1'-0"

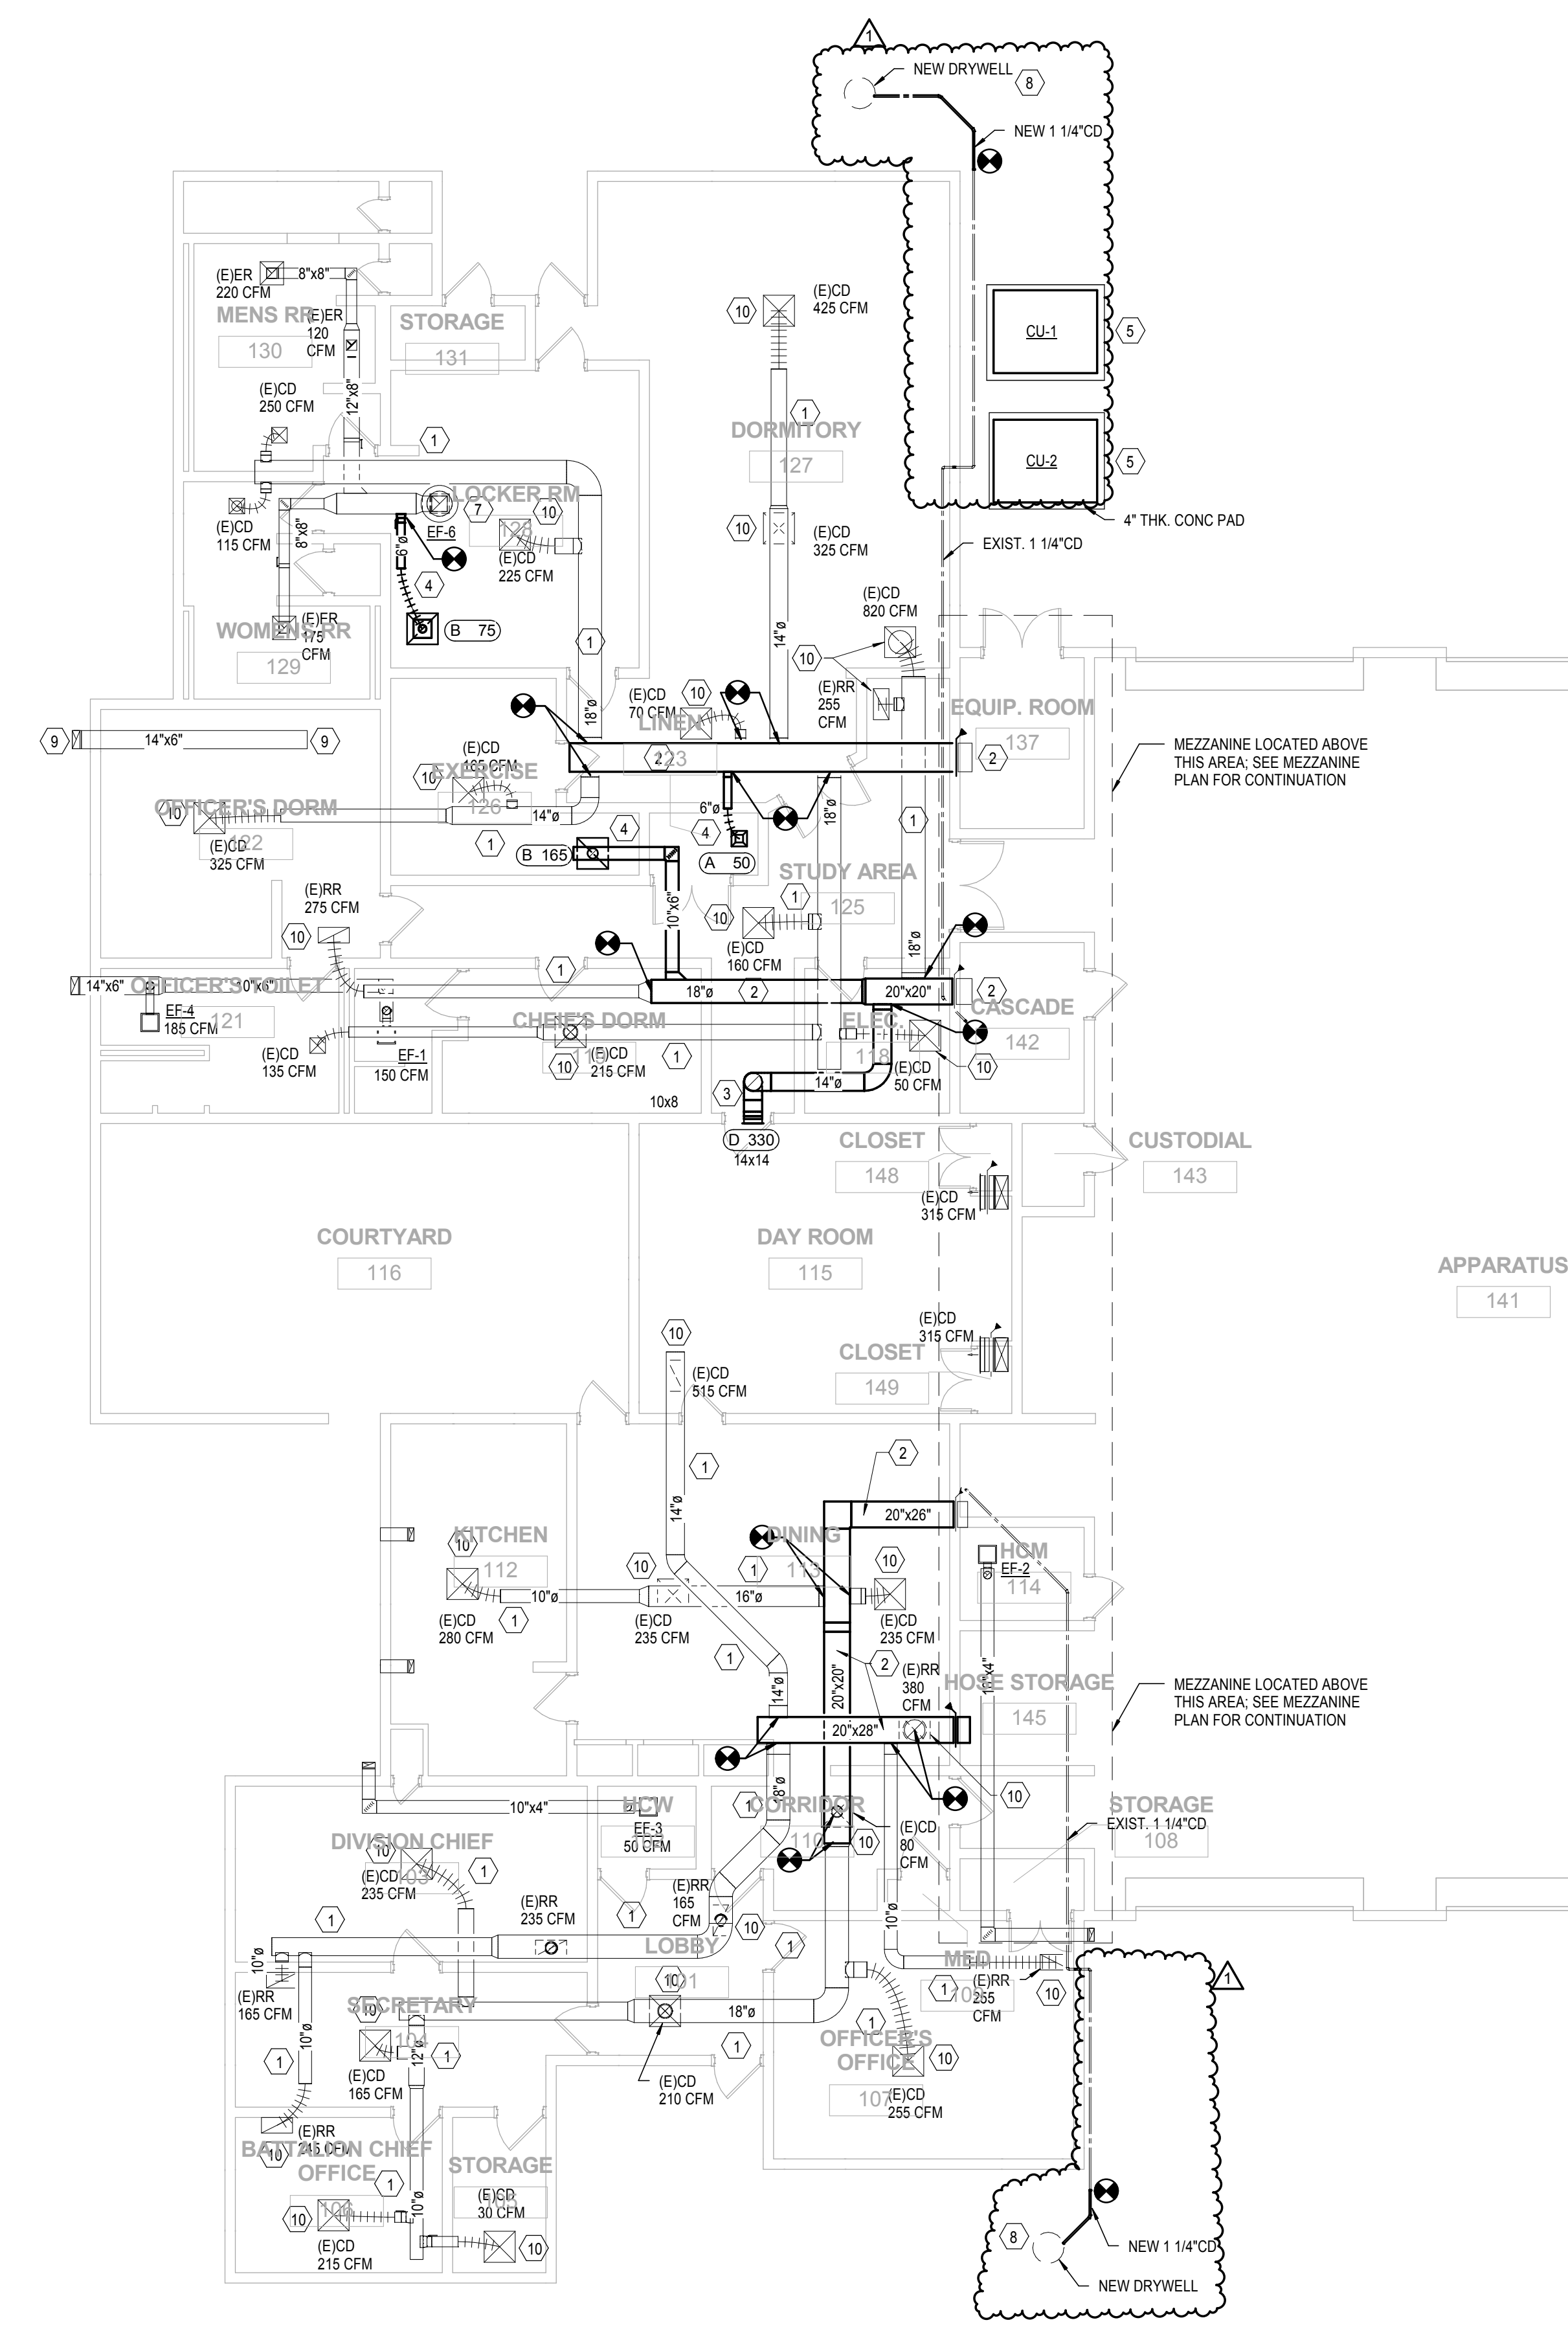

05/15/19 E:\Revit\16\MEP_V16_OC_FS#30_am8S\W08.rvt

Flo-Well


Manufactured Dry Well

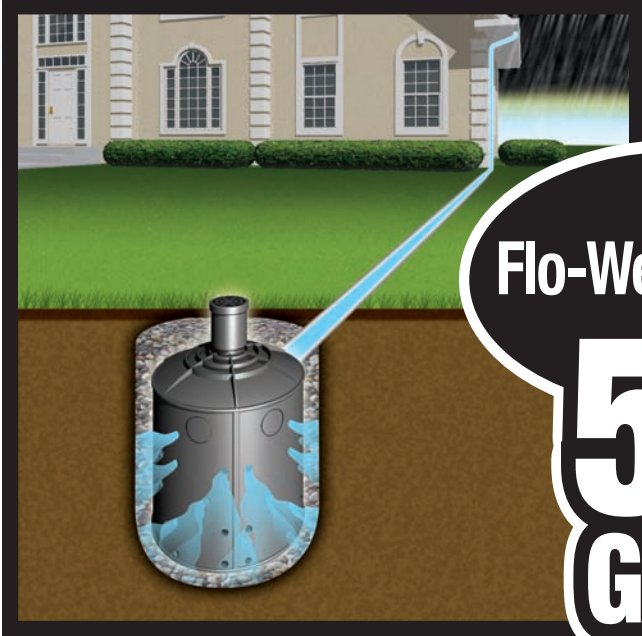

Flo-Well. HOLDS

**50
GAL.**

VERSUS

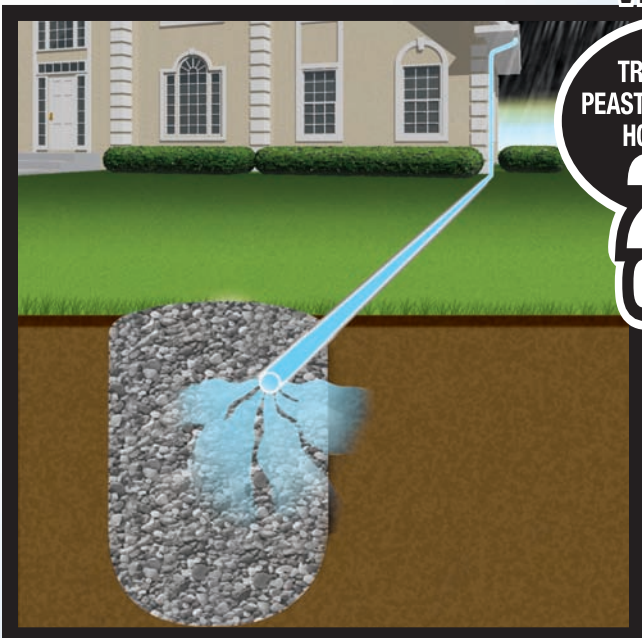

TRADITIONAL
PEASTONE DRYWELL
HOLDS ONLY

**20
GAL.**

LEED credits:
Make your
site green


Retains storm
water on-site

Less costly to
install than pipe
or concrete

Expands to
manage large
volumes of water



FLO-WELL[®] STORM WATER LEACHING SYSTEM

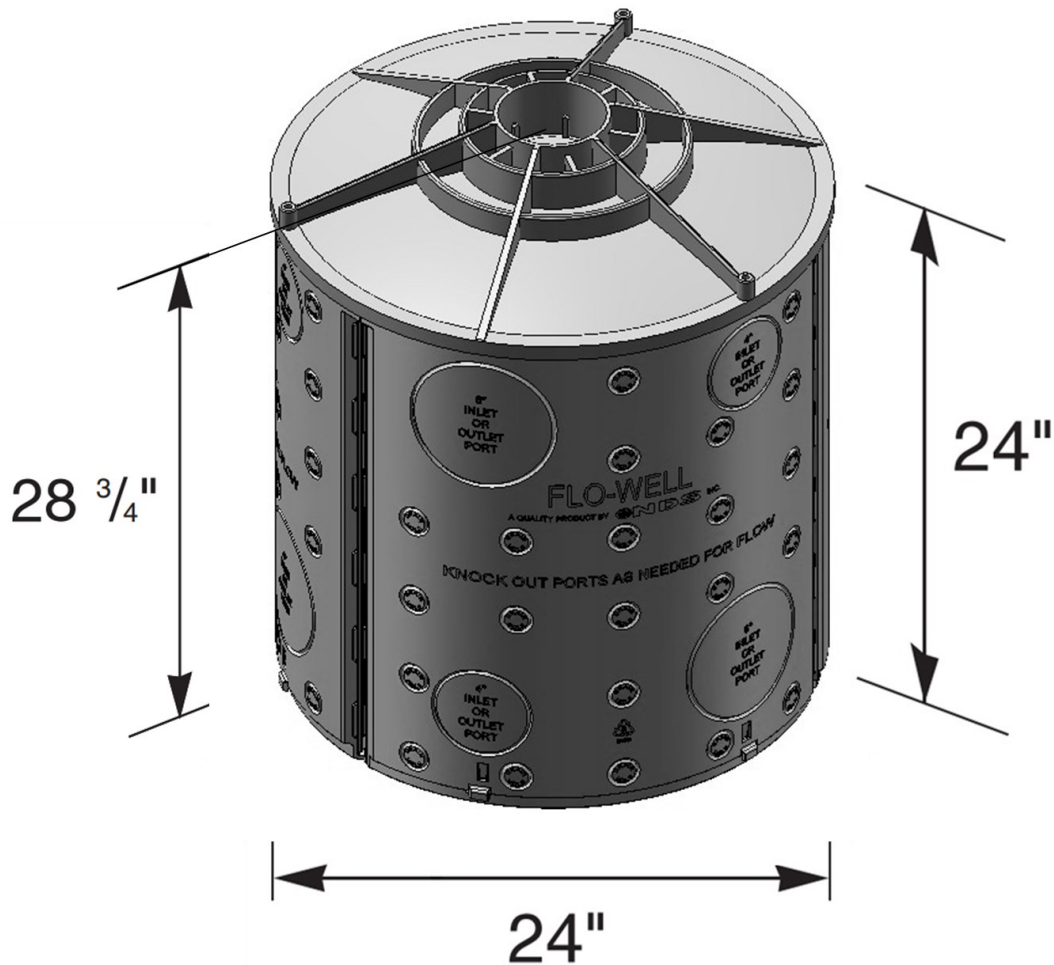

Part #: FWAS24

Material: UV Protected High Density Polypropylene (HDPE)

Colors: Black

Weight: 18.96 lbs each







Fits: 4" SCH-40 and DWV pipe

Will hold 50 gallons of water

Includes (3) FWSPS33 Side Panels and (1) FWAS24C cover

LFWAS24 also includes (1) FWFF67 Filter Fabric Wrap

Flo-Well[®] Manufactured Dry Well

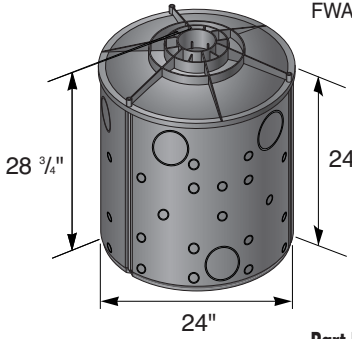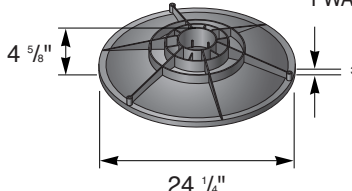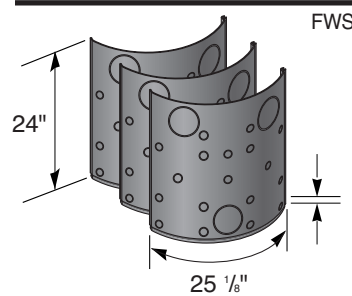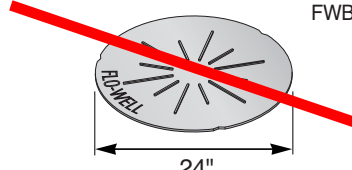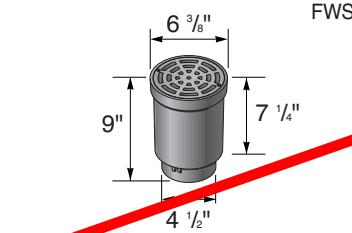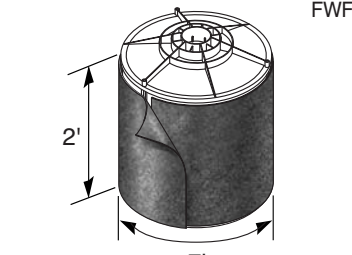	Part No.	Description	Color	Pkg. Qty.	Wt. Ea. (lbs.)	Product Class	Specifications
	FWAS24	24" diam. x 28.75"H Flo-Well [®] Storm water leaching system Includes 3 side panels, 1 Top Component Fits 4" SCH-40 Pipe and 4" DWV Pipe	Black	1	25.15	10FW	NDS #FWAS24 structural foam polyolefin round drywell system with UV inhibitors. 24" dia., 28.75" high, 49 gal. with 18- 1.5" Knockout leaching ports and 3- 4.5" knockout inlet/outlet ports per panel.
	FWAS24C	24" diam. Flo-Well [®] Cover Use with #FWAS24	Black	2	8.00	10FW	NDS#FWAS24C structural foam polyolefin round drywell system cover with UV inhibitors. 24 1/4" dia., 4 5/8" height, 3/4" outer lip, 4.5" center knockout fits NDS #FWAS24, NDS #FWSPS3.
	FWSPS3	Flo-Well [®] Side Panels/ Extension Only Includes 3 side panels; makes 1 round drywell. Fits #FWAS24 (May also be used as a durable compost bin.)	Black	1	5.00	10FW	NDS #FWSPS3 structural foam polyolefin side panels with UV inhibitors with 18- 1 1/2" knockout leaching ports and 3- 4.5" knockout inlet/outlet ports per panel. 24" high with recessed .75" lip for firm stacking.
	FWBP24	24" diam. Flo-Well [®] Bottom Fits #FWAS24	Black	5	3.50	10FW	NDS #FWBP24 structural foam polyolefin round Flo-Well [®] bottom with UV inhibitors. 24" diameter with six 1 1/2" leaching ports. 4.5" center knockout for strut coupling.
	FWSD69	4" SCH40 Surface Drain Inlet with Grate Fits #FWAS24 and #FWAS24C ADA Compliant	Black	8	1.85	10FW	NDS #FWSD69 structural foam polyolefin 6" grate with 4" inlet with UV inhibitors. 6" Diameter at inlet. 9" high. 4.5" OD fits Sch. 40 PVC fittings.
	FWFF67	Porous Filter Fabric Wrap for Flo-Well [®] Use with #FWAS24	Black	20	0.35	10FW	7' long x 2' wide to surround Flo-Well [®] Drywell System. Non-woven fabric. Weight 1 oz. Mullen burst 175 psi. 200 GPM flow through.

ORANGE COUNTY, FLORIDA

**AGREEMENT ASSUMING RISK OF INJURY OR DAMAGE
RELEASE OF LIABILITY AND INDEMNITY AGREEMENT**

WHEREAS, I, _____,
(being/not being) over the age of eighteen and not being employed by Orange County,
having made a voluntary request to utilize Orange County equipment including but not limited
to ladders in order to view Orange County property that my company may have an interest in
providing a bid for work to be completed. This release shall govern the property at

(Address)

I do hereby:

1. Hereby agree and acknowledge that by my voluntary participation in this event,
should an accident occur, any liability, damages, claims and demands of every kind and
nature whatsoever arising out of said accident shall be applied to my own personal insurance
and not that of the County.

2. Release, waive, and forever discharge Orange County, its officers, employees and
agents from any liability, actions, causes of action, damages, claims, and demands of every
kind and nature whatsoever arising out of or resulting from the activities described above.

3. Agree to defend, indemnify, and hold harmless Orange County, its officers,
employees, and agents, against any and all manner of actions, causes of actions, suits,
debts, claims, demands, or damages or liability or expense of every kind and nature incurred
or arising by reason of any actual or claimed wrongful act or omission of mine while
conducting the activities described above.

This release, waiver and hold harmless agreement shall be binding upon me and my
heirs, personal representatives, successors, and assigns.

I hereby represent that I have carefully read and understand the contents of this
document and sign the same of my own free will.

Date

Signature

Print Name

Witness

Address

CAUTION
READ THIS DOCUMENT IN FULL BEFORE SIGNING.